

NOTES

- WORKS CARRIED OUT BY DEMPSEY WOOD.
- CONSTRUCTED IN ACCORDANCE WITH AUCKLAND COUNCIL STANDARDS.

Legend - Roading

- EX BDY
- AB BDY
- STAGE BDY
- AB NSAAT LINE
- AB ROAD SIGN/STREETLIGHT
- AB SPEED HUMP / CUSHION
- AB STREET TREE

Legend - Stormwater

- AB SW PIPES
- AB LOT CONNECTION
- AB SWMH / SWCP
- AB SW OUTLET

Legend - Wastewater

- EX RISING MAIN
- EX VACUUM LINE
- AB VACUUM LINE
- AB GRAVITY LINE
- AB VALVE PIT
- AB VALVE / REDUCER / CAP

Legend - Water

- EX WATERMAIN
- EX/AB HYDRANT / METER
- EX SLUICE / PEET VALVE
- AB WATERMAIN
- AB SLUICE / PEET VALVE

Legend - Power

- LV POWER 100
- HV POWER 140
- STREETLIGHT LINE
- LINK PILLAR / SERVICE PIT
- TRANSFORMER/SWITCHGEAR

Legend - Comms

- AB 1wM MICRONET
- AB 1wR RIBBONET
- AB 7wM MICRONET
- AB 12wR RIBBONET
- AB 26wR RIBBONET
- TELECOM TUD/CHORUS PIT

A	FOR INFORMATION ONLY	ML	11/2024
Rev	Description	By	Date
		By	Date
Survey	DEMPSEY WOOD		08/2024
Design	ML		08/2024
Drawn	ML		08/2024
Checked	JD		08/2024

Maven Associates
09 571 0050
info@maven.co.nz
www.maven.co.nz
5 Owens Road, Epsom
Auckland 1023

Project


**62, 78 AND 80 PAPA KURA -
CLEVEDON ROAD,
CLEVEDON, AUCKLAND
FOR CLEVEDON
PROPERTIES LTD**

Title

**ENG60407601 STAGE 1
COORDINATION
ASBUILT PLAN**

Project no.	194006		
Scale	1:3500 @ A3		
Cad file	CLEVEDON MEADOWS (STG_1) - COORDINATION AS-BUILT.DWG		
Drawing no.	STG_1 C910	Rev	A

ASBUILT

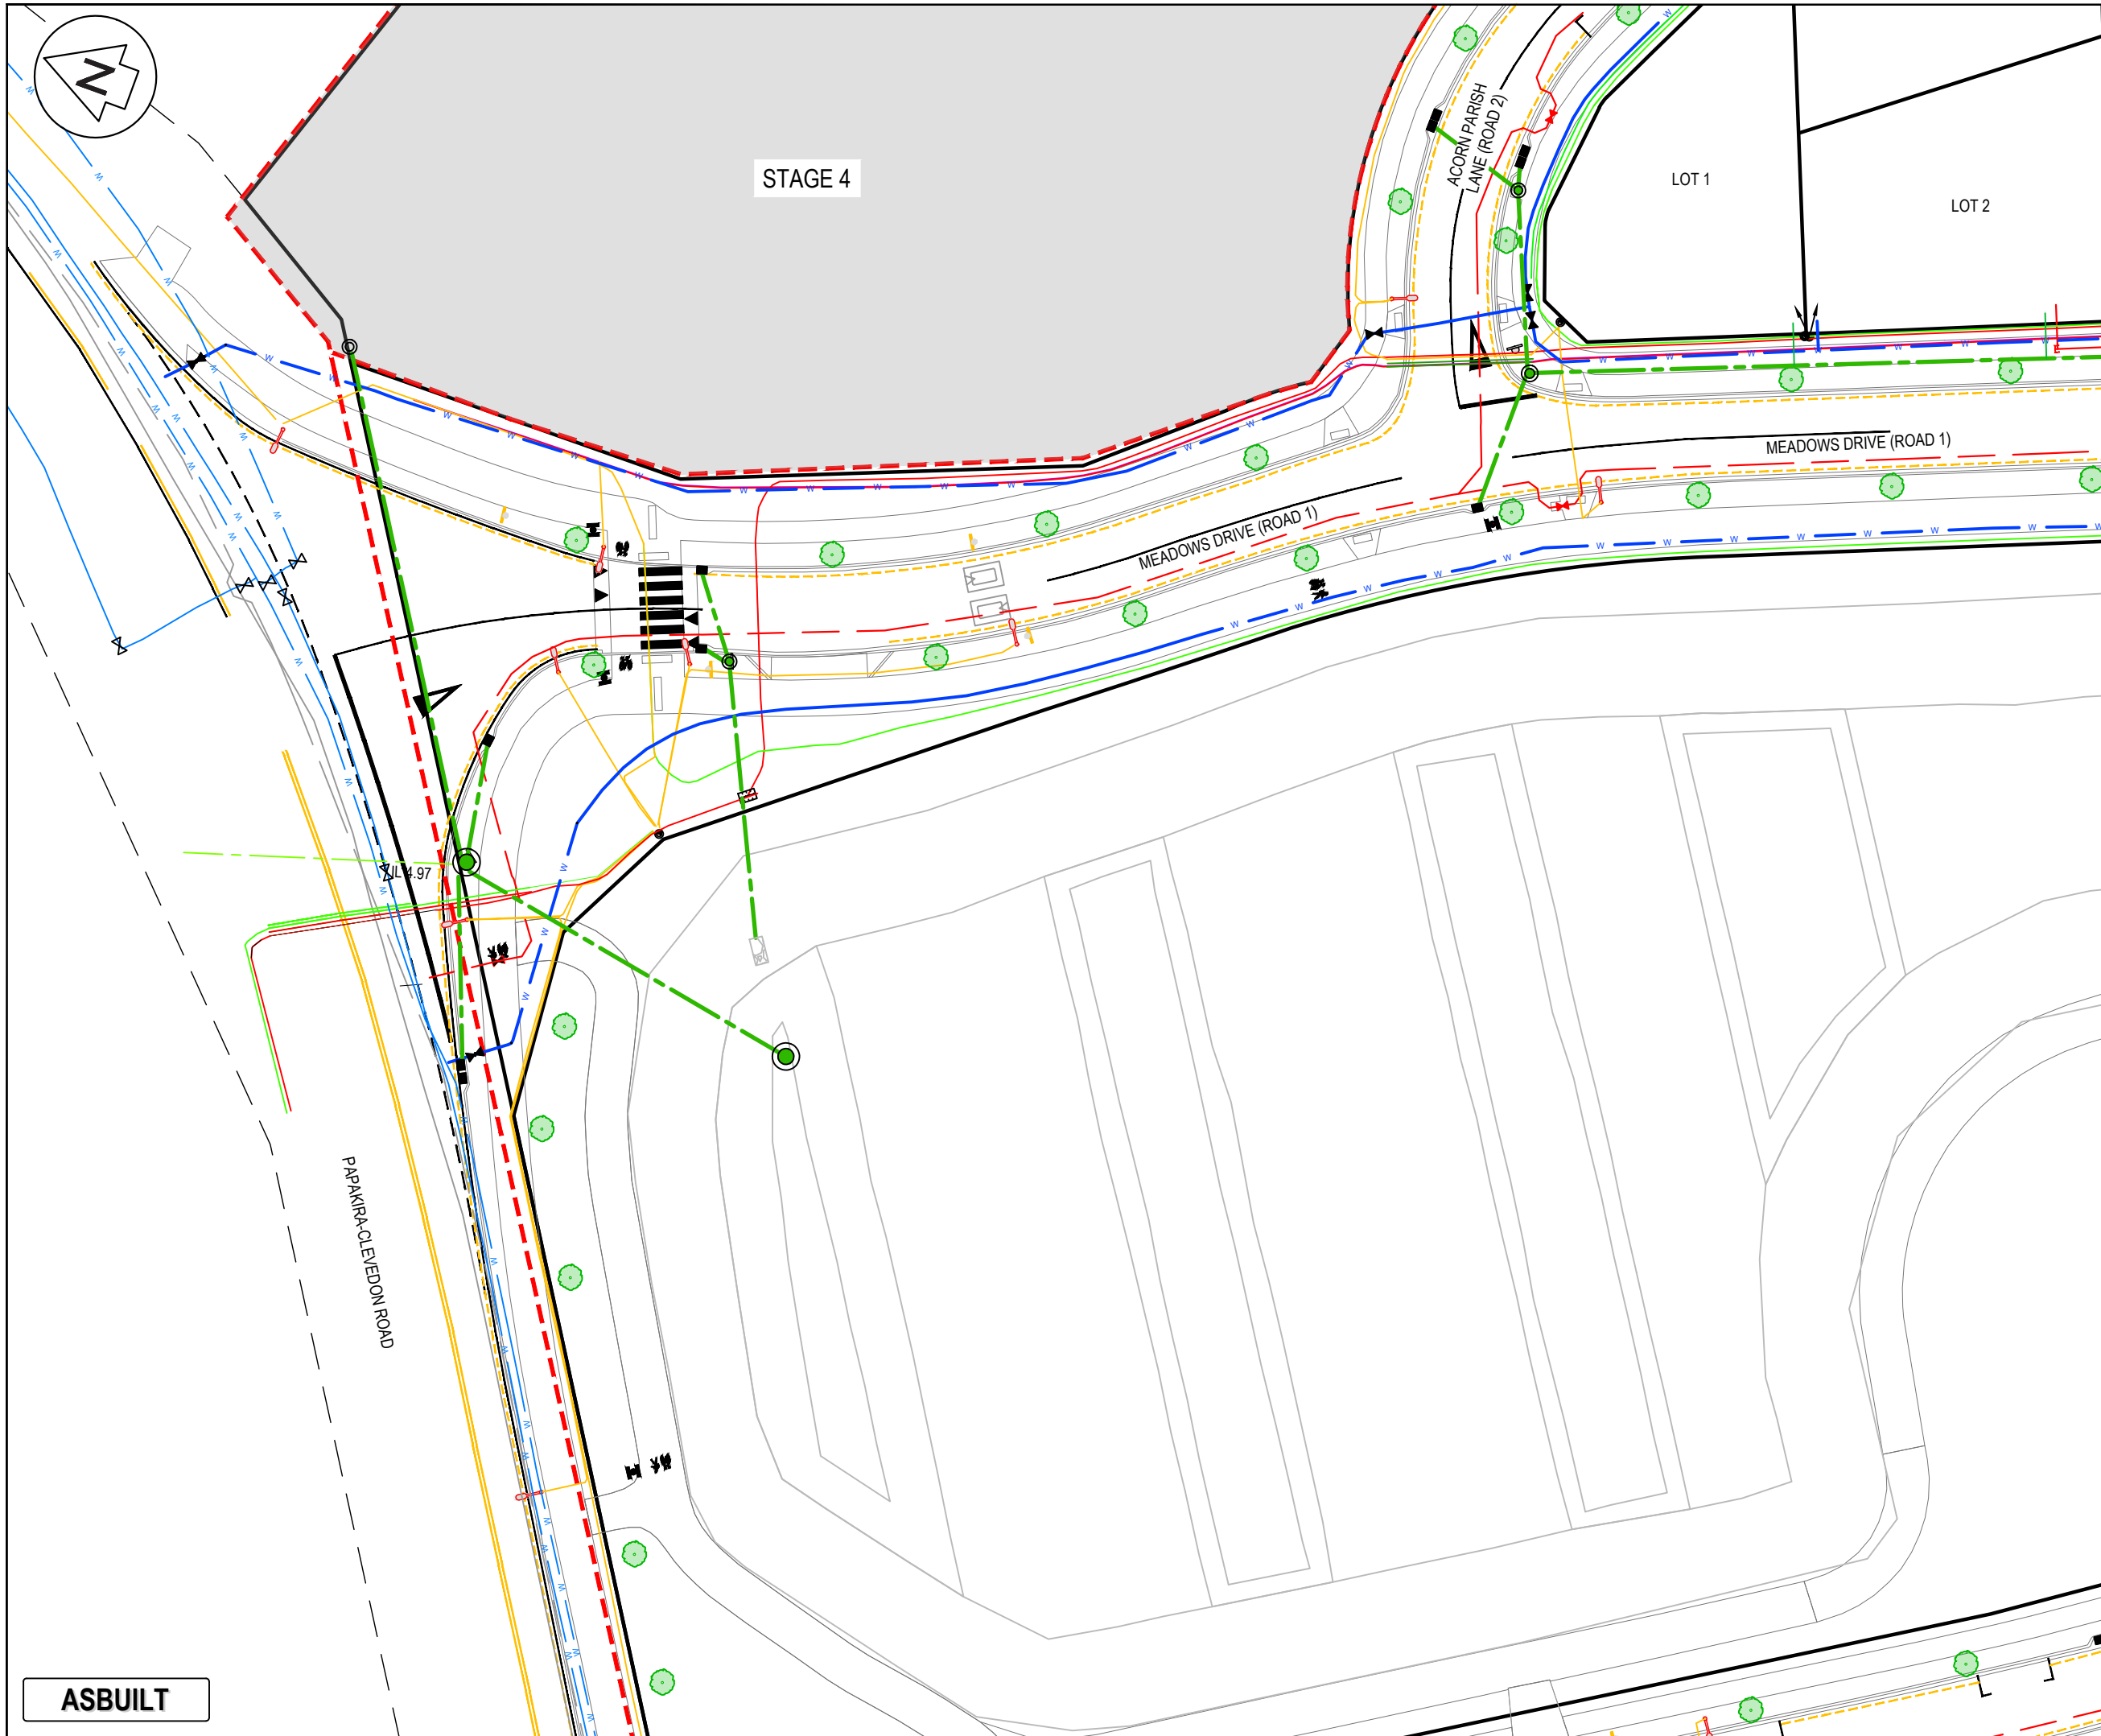

NOTES

- WORKS CARRIED OUT BY DEMPSEY WOOD.
- CONSTRUCTED IN ACCORDANCE WITH AUCKLAND COUNCIL STANDARDS.

Legend - Roading

- EX BDY
- AB BDY
- STAGE BDY
- AB NSAAT LINE
- AB ROAD SIGN/STREETLIGHT
- AB SPEED HUMP / CUSHION
- AB STREET TREE

Legend - Stormwater

- AB SW PIPES
- AB LOT CONNECTION
- AB SWMH / SWCP
- AB SW OUTLET

Legend - Wastewater

- EX RISING MAIN
- EX VACUUM LINE
- AB VACUUM LINE
- AB GRAVITY LINE
- AB VALVE PIT
- AB VALVE / REDUCER / CAP

Legend - Water

- EX WATERMAIN
- EX/AB HYDRANT / METER
- EX SLUICE / PEET VALVE
- AB WATERMAIN
- AB SLUICE / PEET VALVE

Legend - Power

- LV POWER 100
- HV POWER 140
- STREETLIGHT LINE
- LINK PILLAR / SERVICE PIT
- TRANSFORMER/SWITCHGEAR

Legend - Comms

- AB 1wM MICRONET
- AB 1wR RIBBONET
- AB 7wM MICRONET
- AB 12wR RIBBONET
- AB 26wR RIBBONET
- TELECOM TUD/CHORUS PIT

A	FOR INFORMATION ONLY	ML	11/2024
Rev	Description	By	Date
Survey	DEMPSEY WOOD		08/2024
Design	ML		08/2024
Drawn	ML		08/2024
Checked	JD		08/2024

Maven Associates
09 571 0050
info@maven.co.nz
www.maven.co.nz
5 Owens Road, Epsom
Auckland 1023



Project

62, 78 AND 80 PAKURA - CLEVEDON ROAD, CLEVEDON, AUCKLAND FOR CLEVEDON PROPERTIES LTD

Title

ENG60407601 STAGE 1 COORDINATION ASBUILT PLAN

Project no.	194006		
Scale	1:500 @ A3		
Cad file	CLEVEDON MEADOWS (STG. 1) - COORDINATION AS-BUILT		
Drawing no.	STG_1 C911	Rev	A

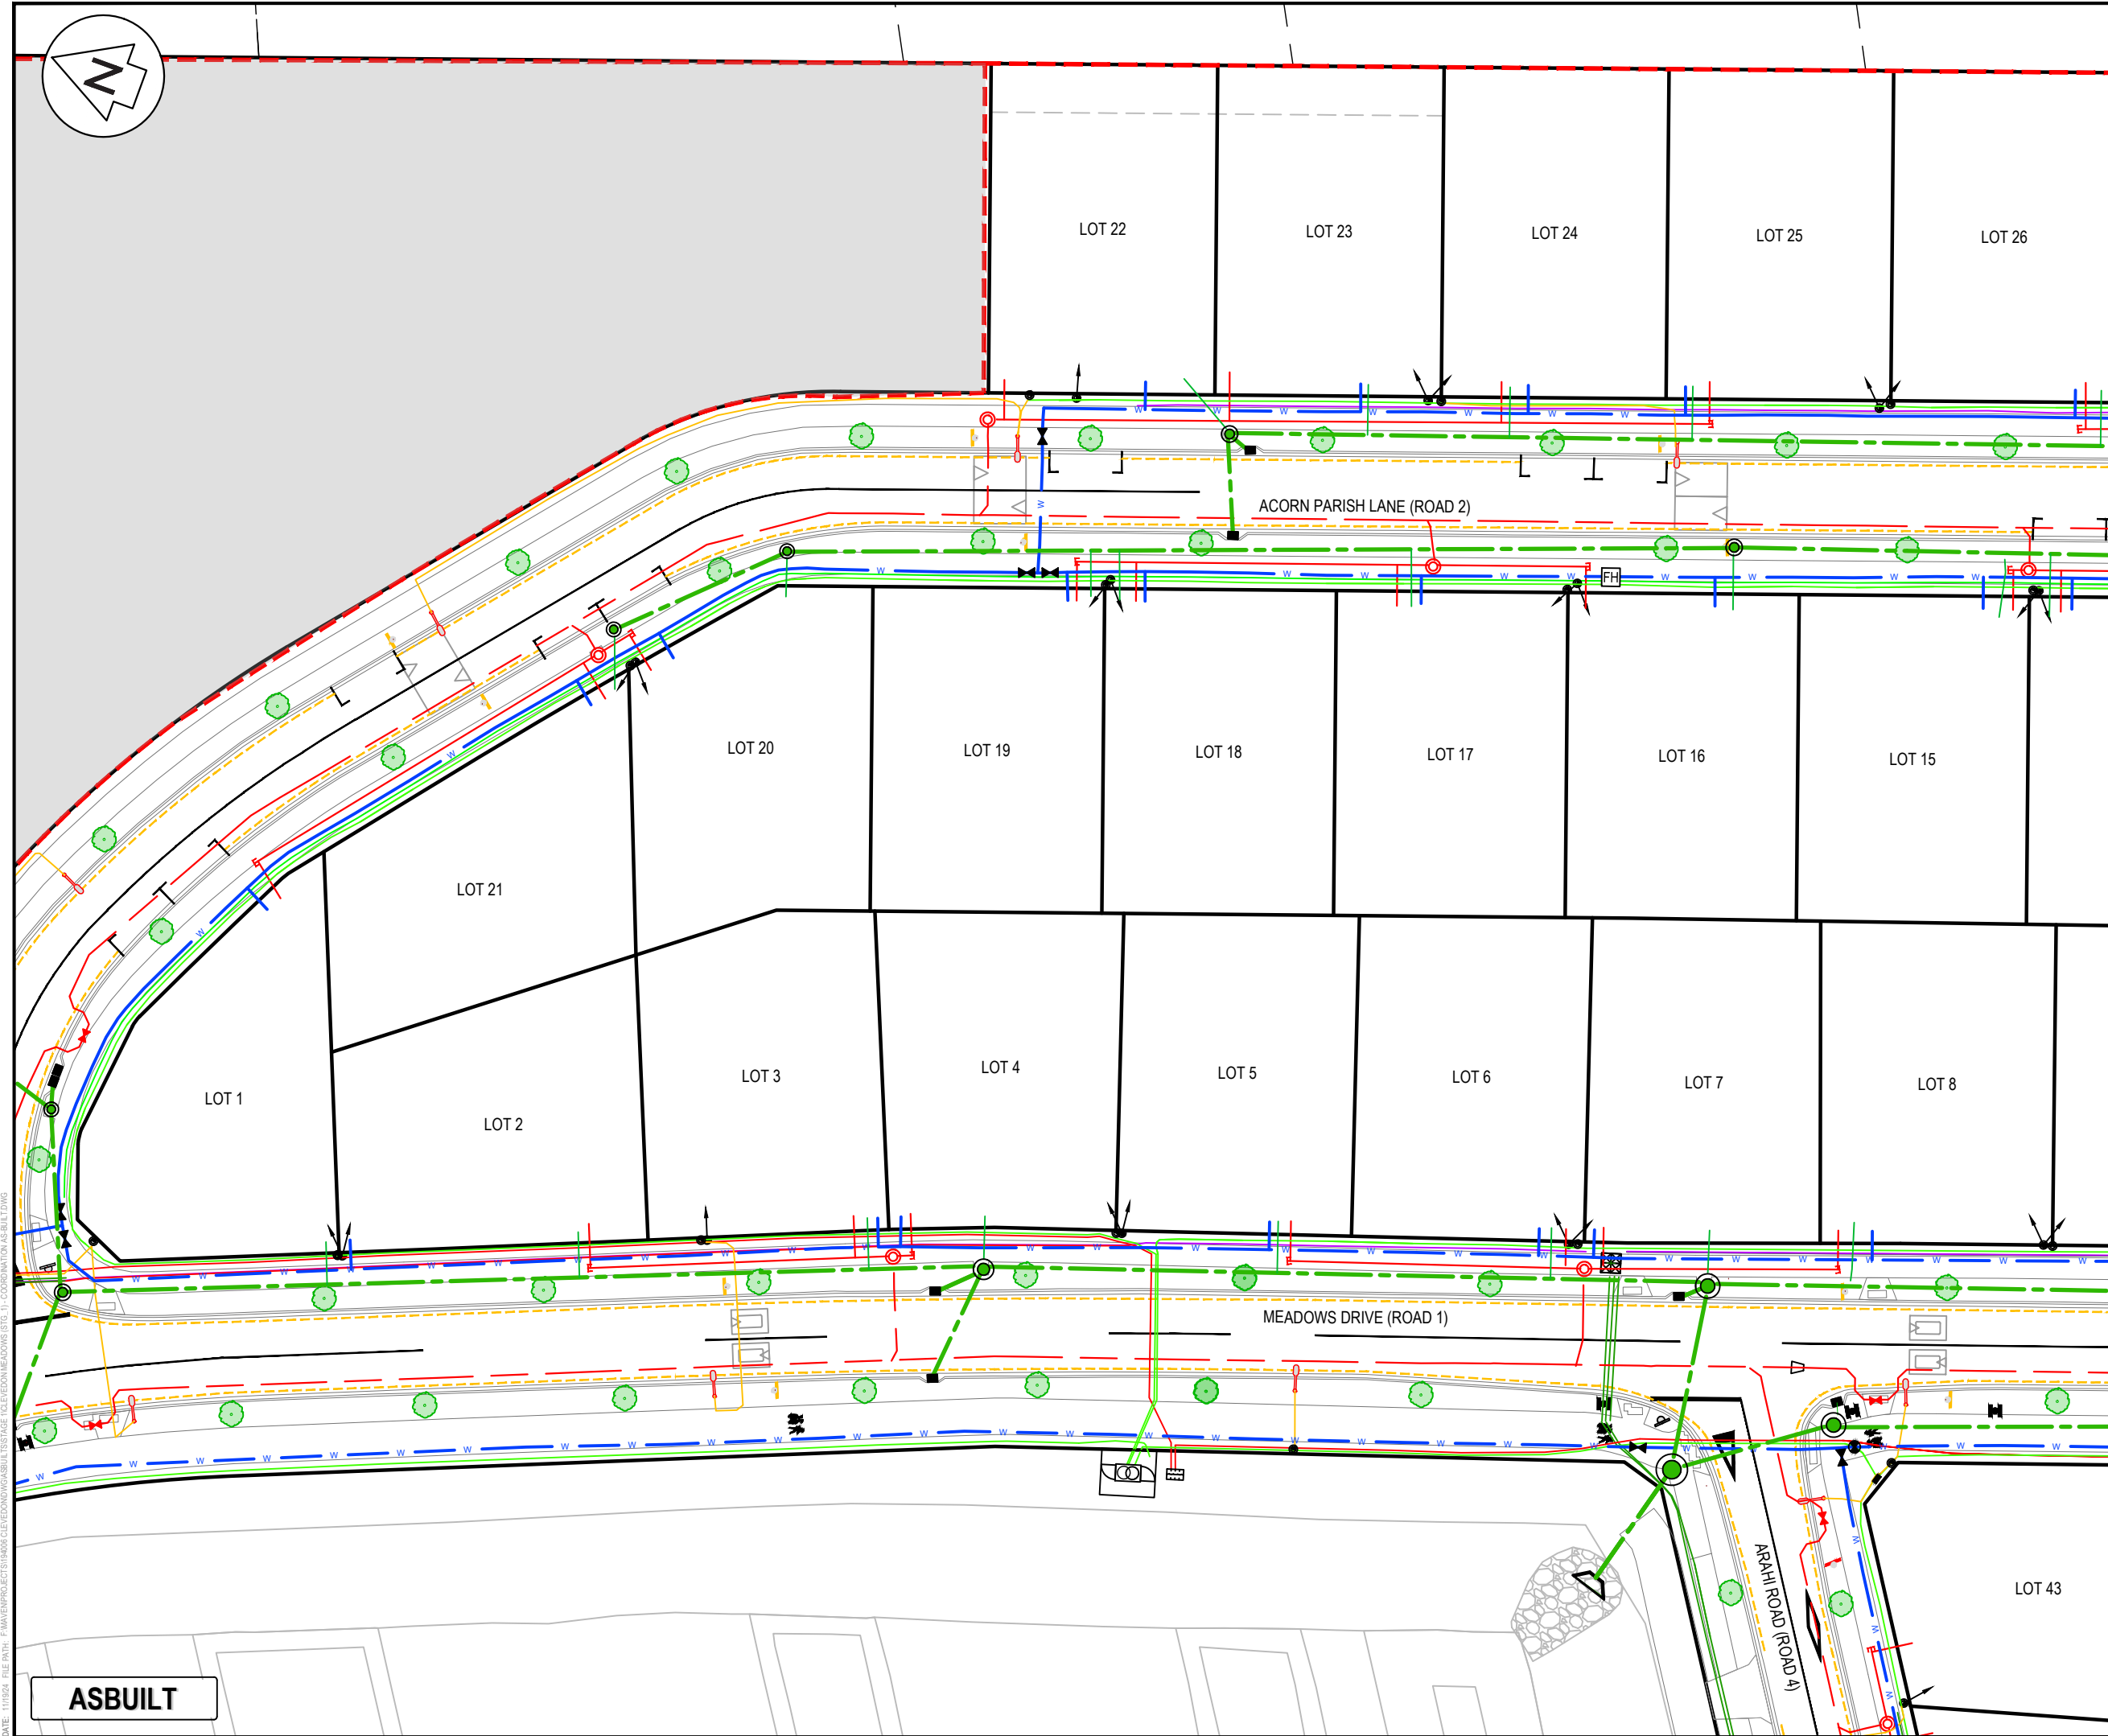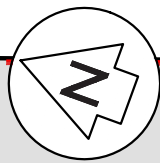

NOTES

- WORKS CARRIED OUT BY DEMPSEY WOOD.
- CONSTRUCTED IN ACCORDANCE WITH AUCKLAND COUNCIL STANDARDS.

Legend - Roading

- EX BDY
- AB BDY
- STAGE BDY
- AB NSAAT LINE
- AB ROAD SIGN/STREETLIGHT
- AB SPEED HUMP / CUSHION
- AB STREET TREE

Legend - Stormwater

- AB SW PIPES
- AB LOT CONNECTION
- AB SWMH / SWCP
- AB SW OUTLET

Legend - Wastewater

- EX RISING MAIN
- EX VACUUM LINE
- AB VACUUM LINE
- AB GRAVITY LINE
- AB VALVE PIT
- AB VALVE / REDUCER / CAP

Legend - Water

- EX WATERMAIN
- EX/AB HYDRANT / METER
- EX SLUICE / PEET VALVE
- AB WATERMAIN
- AB SLUICE / PEET VALVE

Legend - Power

- LV POWER 100
- HV POWER 140
- STREETLIGHT LINE
- LINK PILLAR / SERVICE PIT
- TRANSFORMER/SWITCHGEAR

Legend - Comms

- AB 1wM MICRONET
- AB 1wR RIBBONET
- AB 7wM MICRONET
- AB 12wR RIBBONET
- AB 26wR RIBBONET
- TELECOM TUD/CHORUS PIT

A	FOR INFORMATION ONLY	ML	11/2024
Rev	Description	By	Date
Survey	DEMPSEY WOOD		08/2024
Design	ML		08/2024
Drawn	ML		08/2024
Checked	JD		08/2024

Maven Associates
09 571 0050
info@maven.co.nz
www.maven.co.nz
5 Owens Road, Epsom
Auckland 1023


Project
62, 78 AND 80 PAPAKURA - CLEVEDON ROAD, CLEVEDON, AUCKLAND FOR CLEVEDON PROPERTIES LTD

Title
ENG60407601 STAGE 1 COORDINATION ASBUILT PLAN

Project no.	194006
Scale	1:500 @ A3
Cad file	CLEVEDON MEADOWS (STG_1) - COORDINATION AS-BUILT.DWG
Drawing no.	STG_1_C912
Rev	A

ASBUILT

DATE: 11/2024 FILE PATH: E:\Maven\Projects\194006\Clevedon Meadows\STG_1 - COORDINATION AS-BUILT.DWG

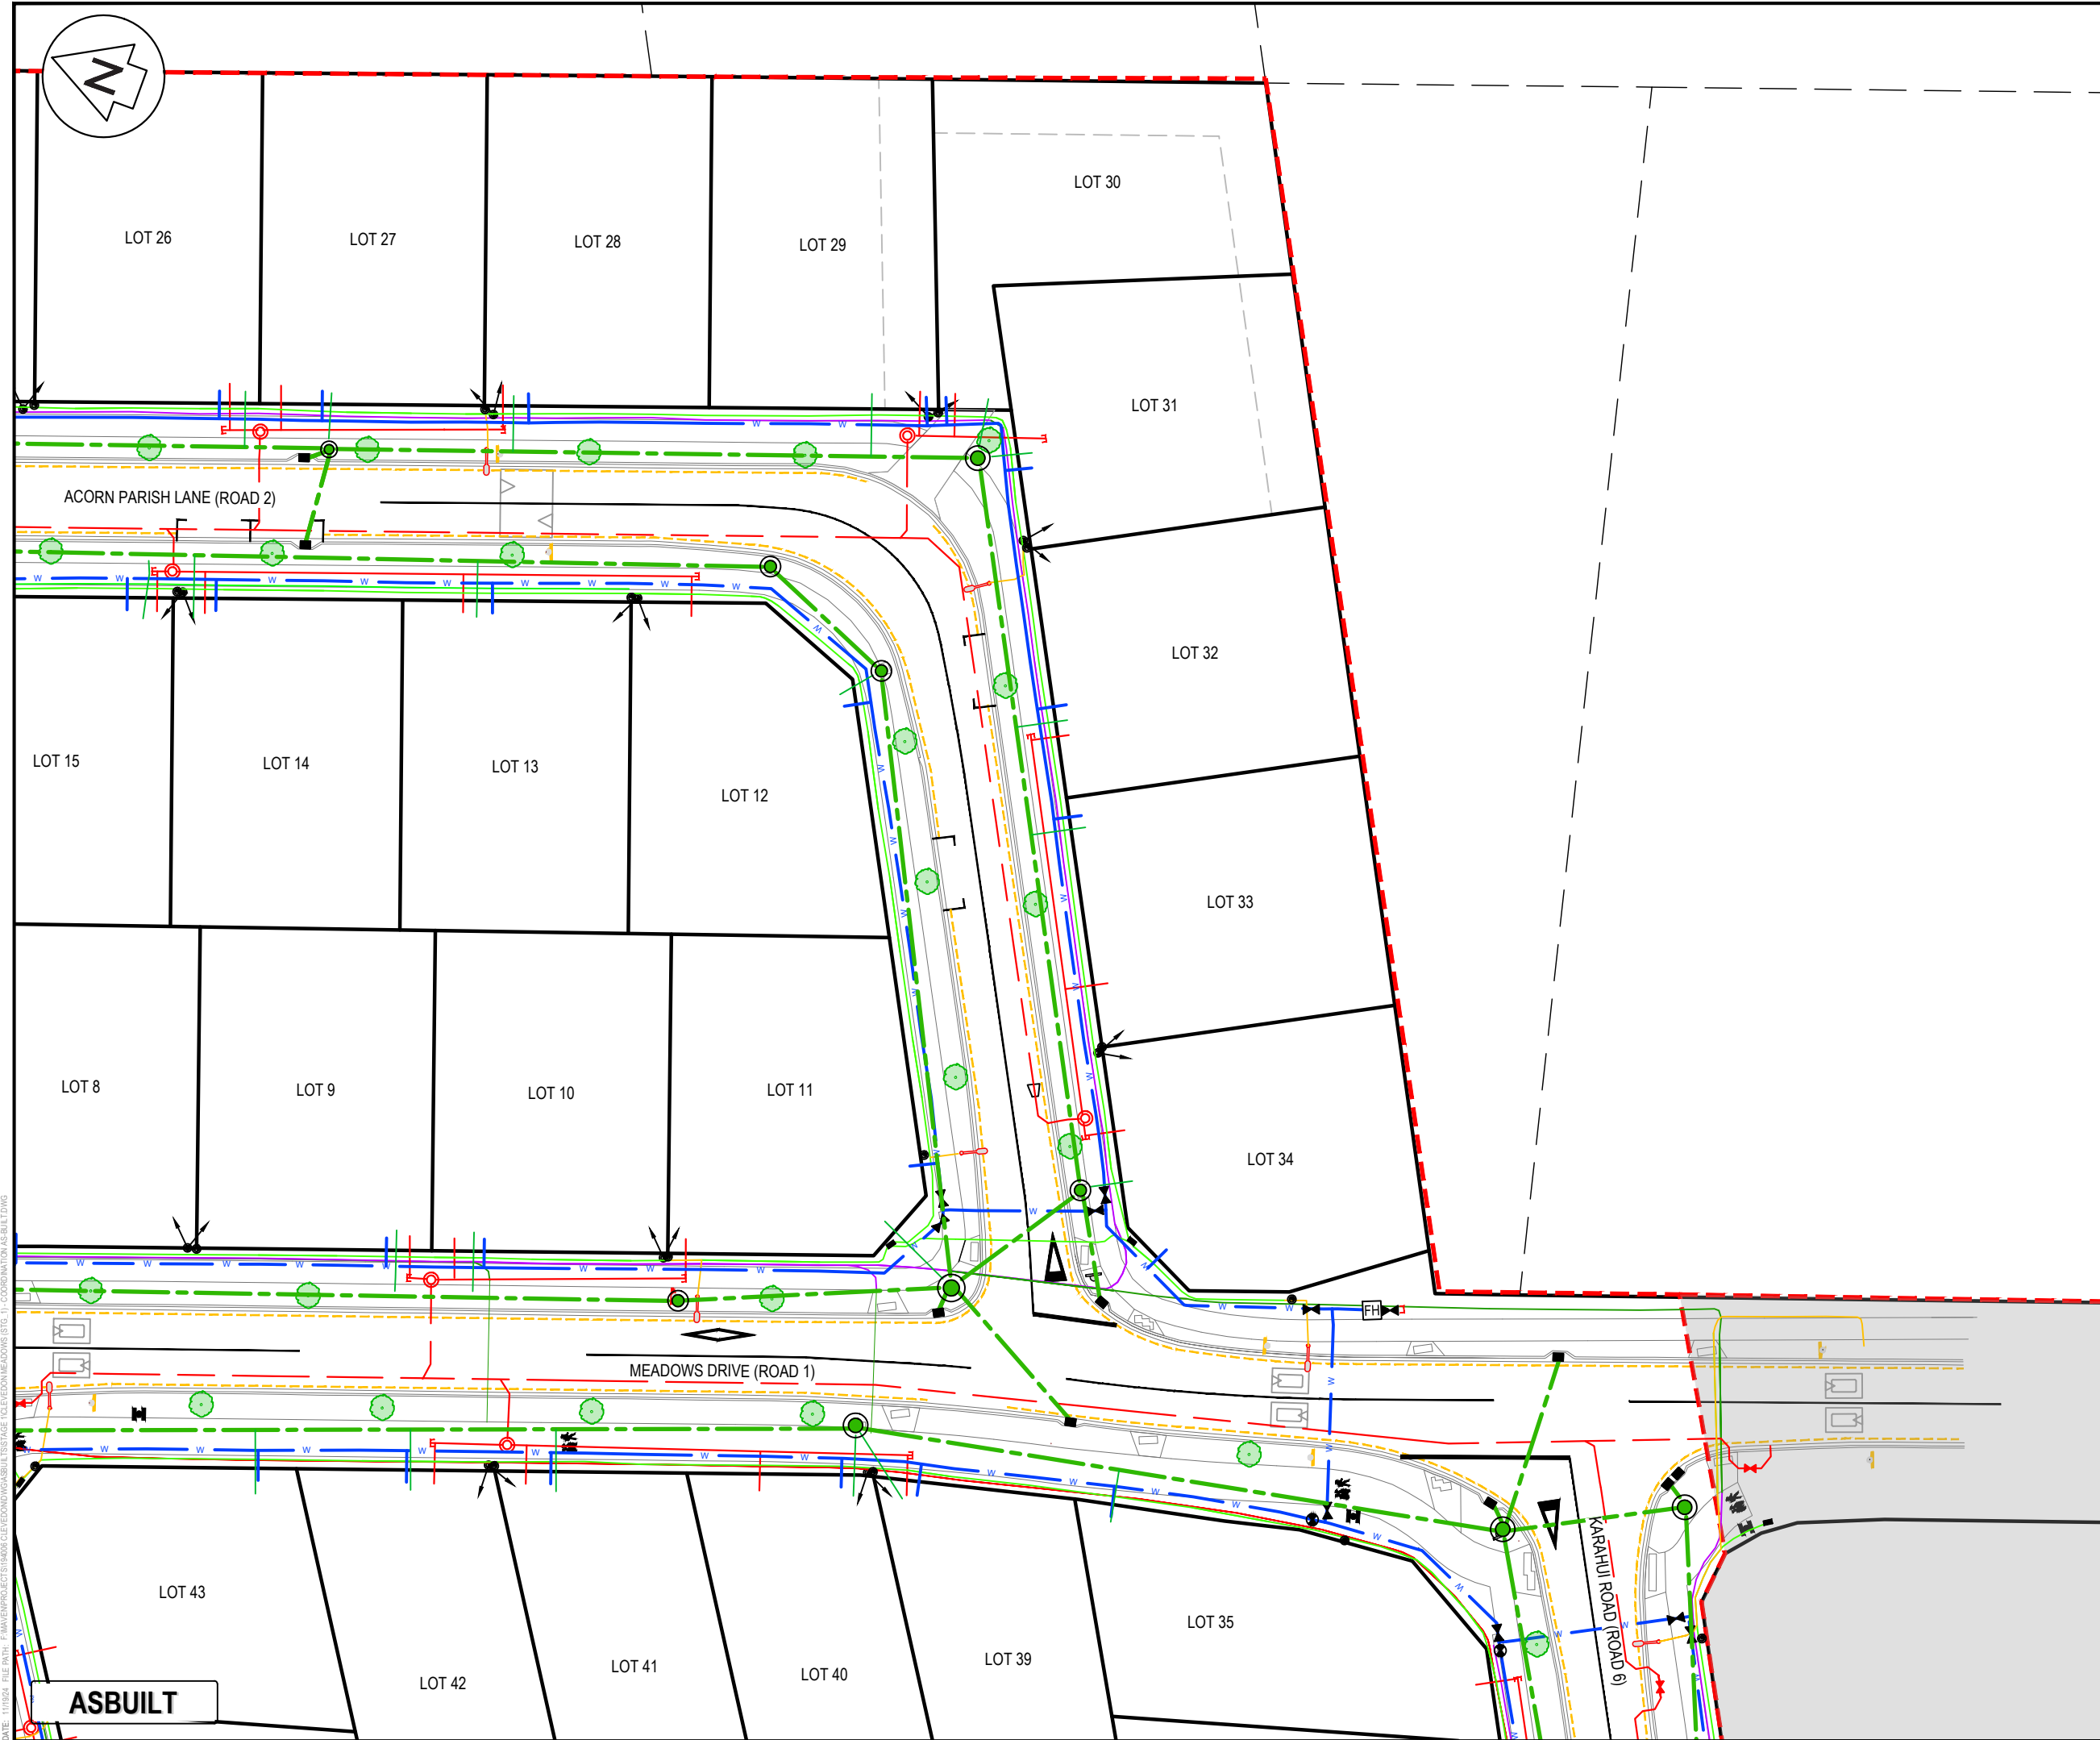

NOTES

- WORKS CARRIED OUT BY DEMPSEY WOOD.
- CONSTRUCTED IN ACCORDANCE WITH AUCKLAND COUNCIL STANDARDS.

Legend - Roading

- EX BDY
- AB BDY
- STAGE BDY
- AB NSAAT LINE
- AB ROAD SIGN/STREETLIGHT
- AB SPEED HUMP / CUSHION
- AB STREET TREE

Legend - Stormwater

- AB SW PIPES
- AB LOT CONNECTION
- AB SWMH / SWCP
- AB SW OUTLET

Legend - Wastewater

- EX RISING MAIN
- EX VACUUM LINE
- AB VACUUM LINE
- AB GRAVITY LINE
- AB VALVE PIT
- AB VALVE / REDUCER / CAP

Legend - Water

- EX WATERMAIN
- EX/AB HYDRANT / METER
- EX SLUICE / PEET VALVE
- AB WATERMAIN
- AB SLUICE / PEET VALVE

Legend - Power

- LV POWER 100
- HV POWER 140
- STREETLIGHT LINE
- LINK PILLAR / SERVICE PIT
- TRANSFORMER/SWITCHGEAR

Legend - Comms

- AB 1wM MICRONET
- AB 1wR RIBBONET
- AB 7wM MICRONET
- AB 12wR RIBBONET
- AB 26wR RIBBONET
- TELECOM TUD/CHORUS PIT

A	FOR INFORMATION ONLY	ML	11/2024
Rev	Description	By	Date
	By	Date	
Survey	DEMPSEY WOOD	08/2024	
Design	ML	08/2024	
Drawn	ML	08/2024	
Checked	JD	08/2024	

Maven Associates
09 571 0050
info@maven.co.nz
www.maven.co.nz
5 Owens Road, Epsom
Auckland 1023


Project
62, 78 AND 80 PAPAKURA - CLEVEDON ROAD, CLEVEDON, AUCKLAND FOR CLEVEDON PROPERTIES LTD

Title
ENG60407601 STAGE 1 COORDINATION ASBUILT PLAN

Project no.	194006
Scale	1:500 @ A3
Cad file	CLEVEDON MEADOWS (STG_1) - COORDINATION AS-BUILT.DWG
Drawing no.	STG_1 C913
Rev	A

DATE: 11/2024 FILE PATH: E:\Maven\Projects\194006\Clevedon Meadows (STG_1) - COORDINATION AS-BUILT.DWG

ASBUILT

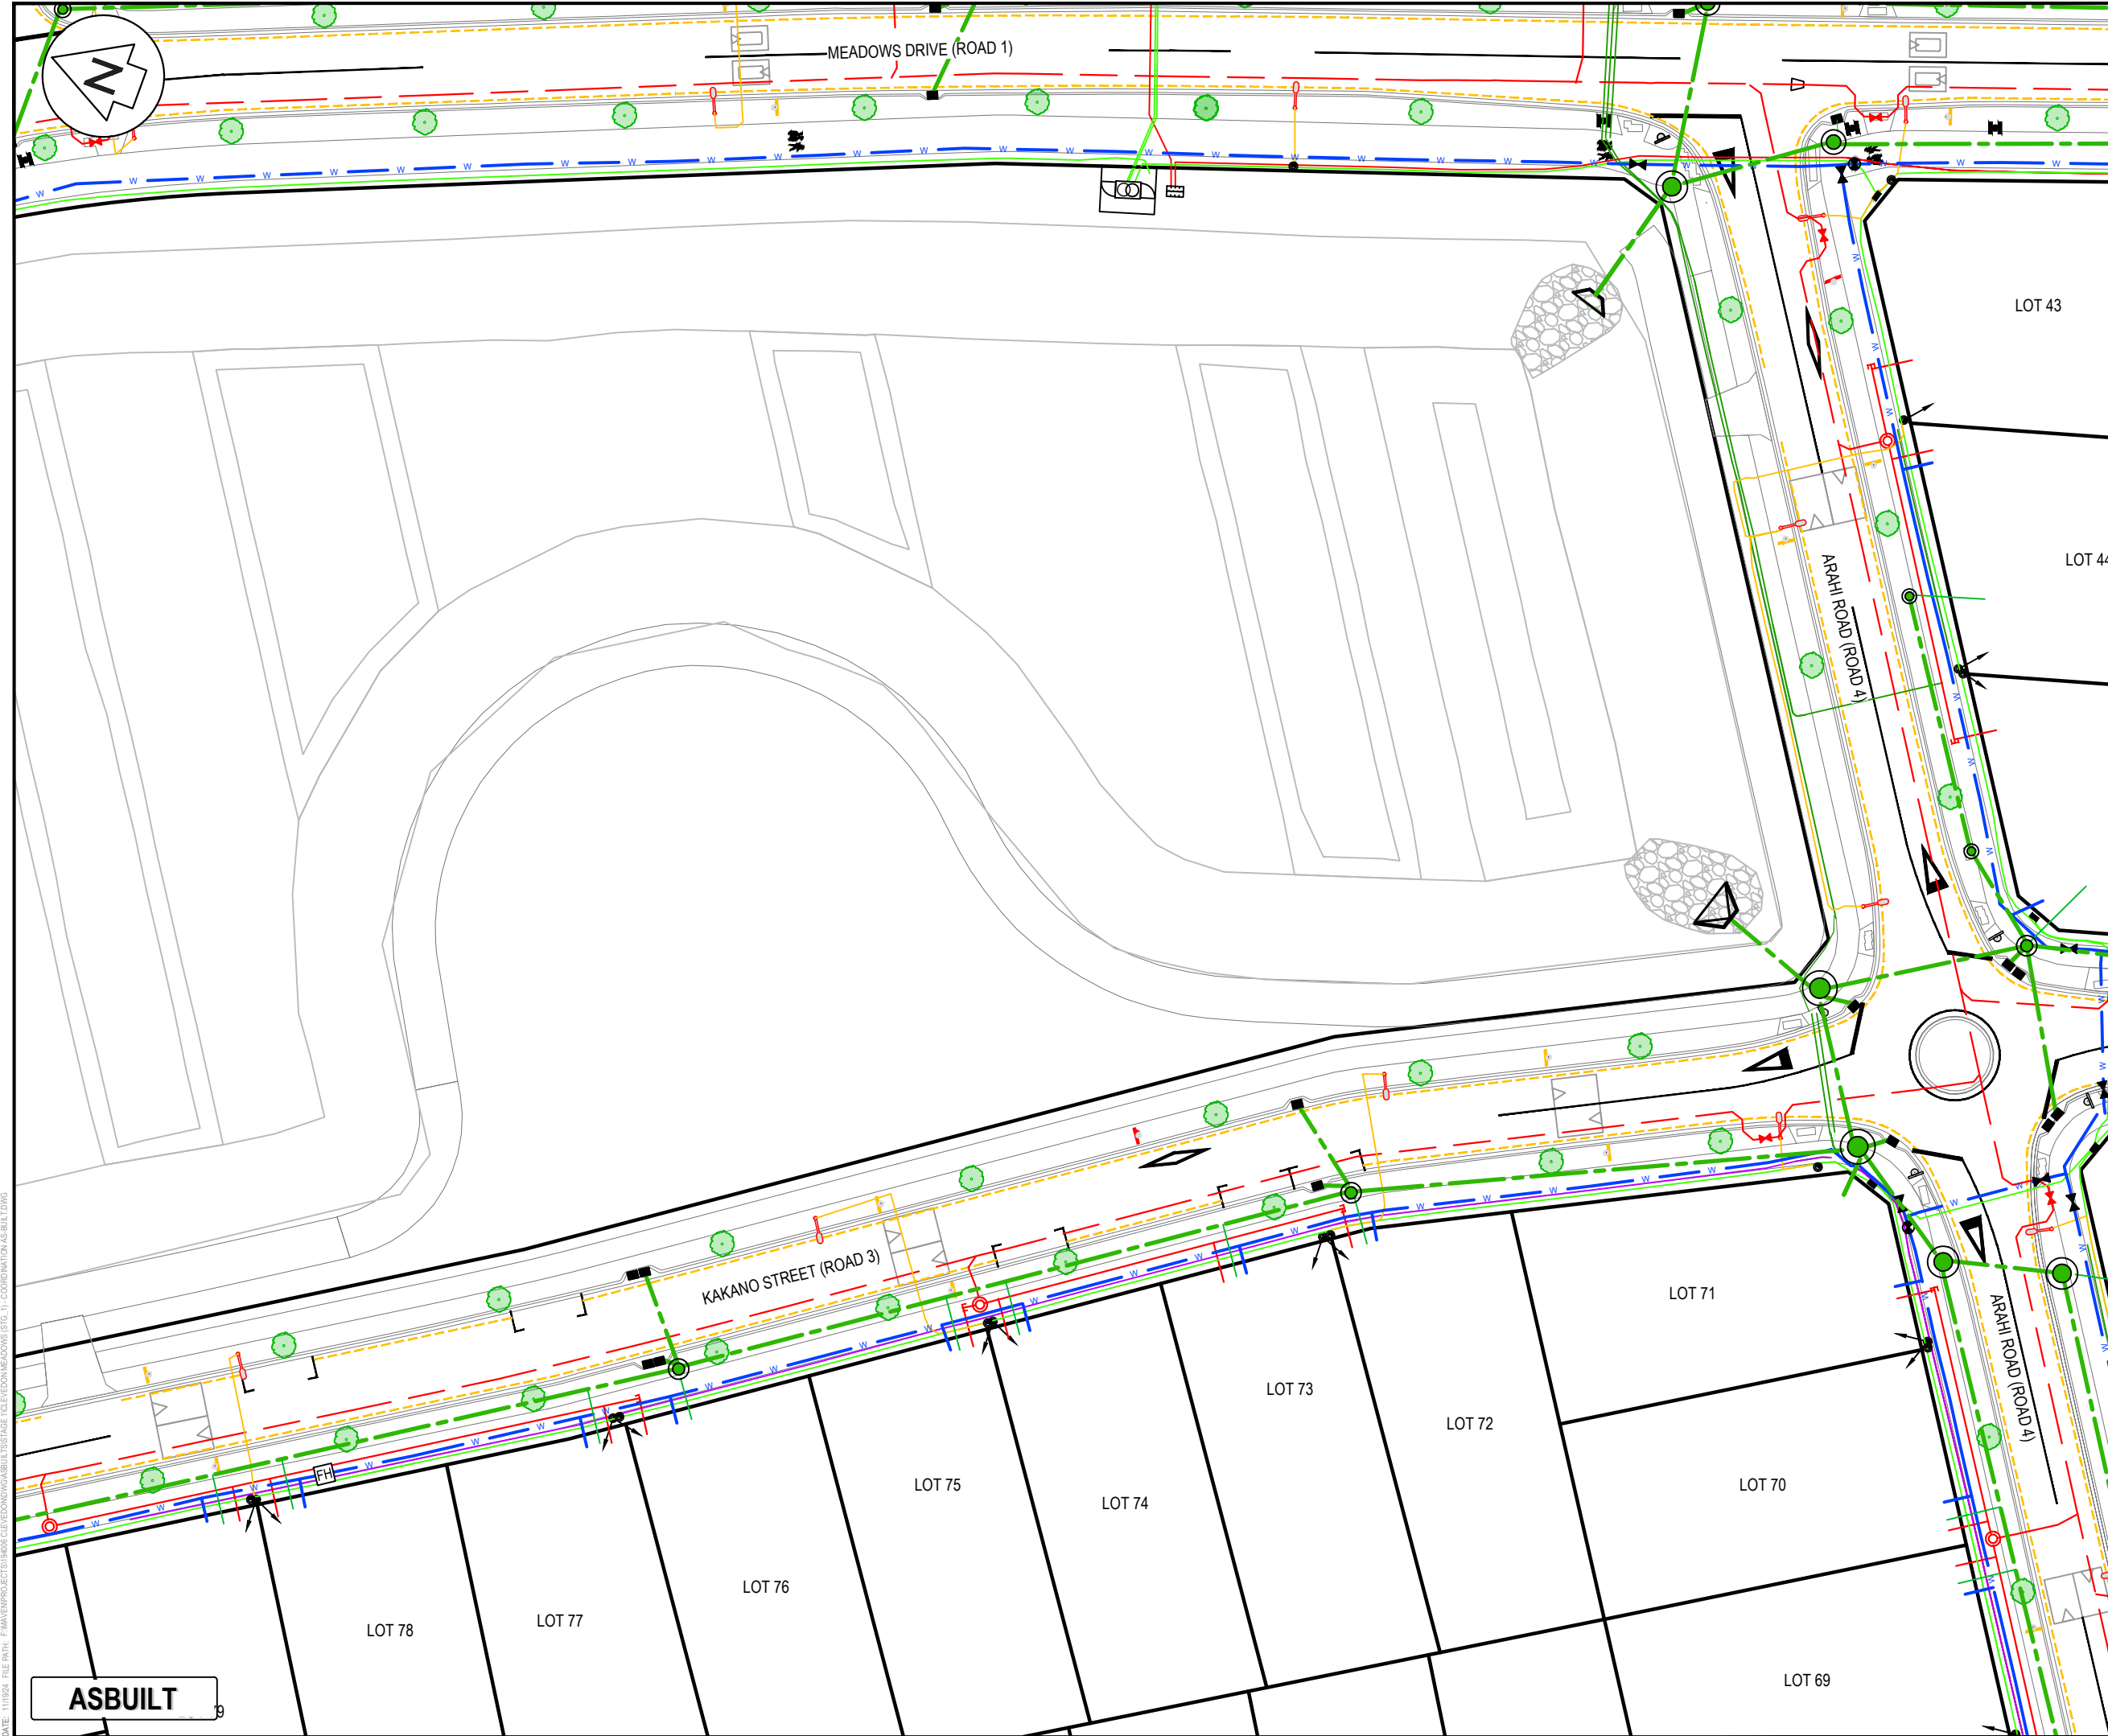

NOTES

- WORKS CARRIED OUT BY DEMPSEY WOOD.
- CONSTRUCTED IN ACCORDANCE WITH AUCKLAND COUNCIL STANDARDS.

Legend - Roading

- EX BDY
- AB BDY
- STAGE BDY
- AB NSAAT LINE
- AB ROAD SIGN/STREETLIGHT
- AB SPEED HUMP / CUSHION
- AB STREET TREE

Legend - Stormwater

- AB SW PIPES
- AB LOT CONNECTION
- AB SWMH / SWCP
- AB SW OUTLET

Legend - Wastewater

- EX RISING MAIN
- EX VACUUM LINE
- AB VACUUM LINE
- AB GRAVITY LINE
- AB VALVE PIT
- AB VALVE / REDUCER / CAP

Legend - Water

- EX WATERMAIN
- EX/AB HYDRANT / METER
- EX SLUICE / PEET VALVE
- AB WATERMAIN
- AB SLUICE / PEET VALVE

Legend - Power

- LV POWER 100
- HV POWER 140
- STREETLIGHT LINE
- LINK PILLAR / SERVICE PIT
- TRANSFORMER/SWITCHGEAR

Legend - Comms

- AB 1wM MICRONET
- AB 1wR RIBBONET
- AB 7wM MICRONET
- AB 12wR RIBBONET
- AB 26wR RIBBONET
- TELECOM TUD/CHORUS PIT

A	FOR INFORMATION ONLY	ML	11/2024
Rev	Description	By	Date
Survey	DEMPSEY WOOD		08/2024
Design	ML		08/2024
Drawn	ML		08/2024
Checked	JD		08/2024




Maven Associates
09 571 0050
info@maven.co.nz
www.maven.co.nz
5 Owens Road, Epsom
Auckland 1023

Project
**62, 78 AND 80 PAPAKURA -
CLEVEDON ROAD,
CLEVEDON, AUCKLAND
FOR CLEVEDON
PROPERTIES LTD**

Title
**ENG60407601 STAGE 1
COORDINATION
ASBUILT PLAN**

Project no.	194006
Scale	1:500 @ A3
Cad file	CLEVEDON MEADOWS (STG_1) - COORDINATION AS-BUILT.DWG
Drawing no.	STG_1 C914
Rev	A

DATE: 11/2024 FILE PATH: E:\MVEN\PROJECTS\62,78 AND 80 PAPA KLEVEDON MEADOWS (STG_1) COORDINATION AS-BUILT.DWG

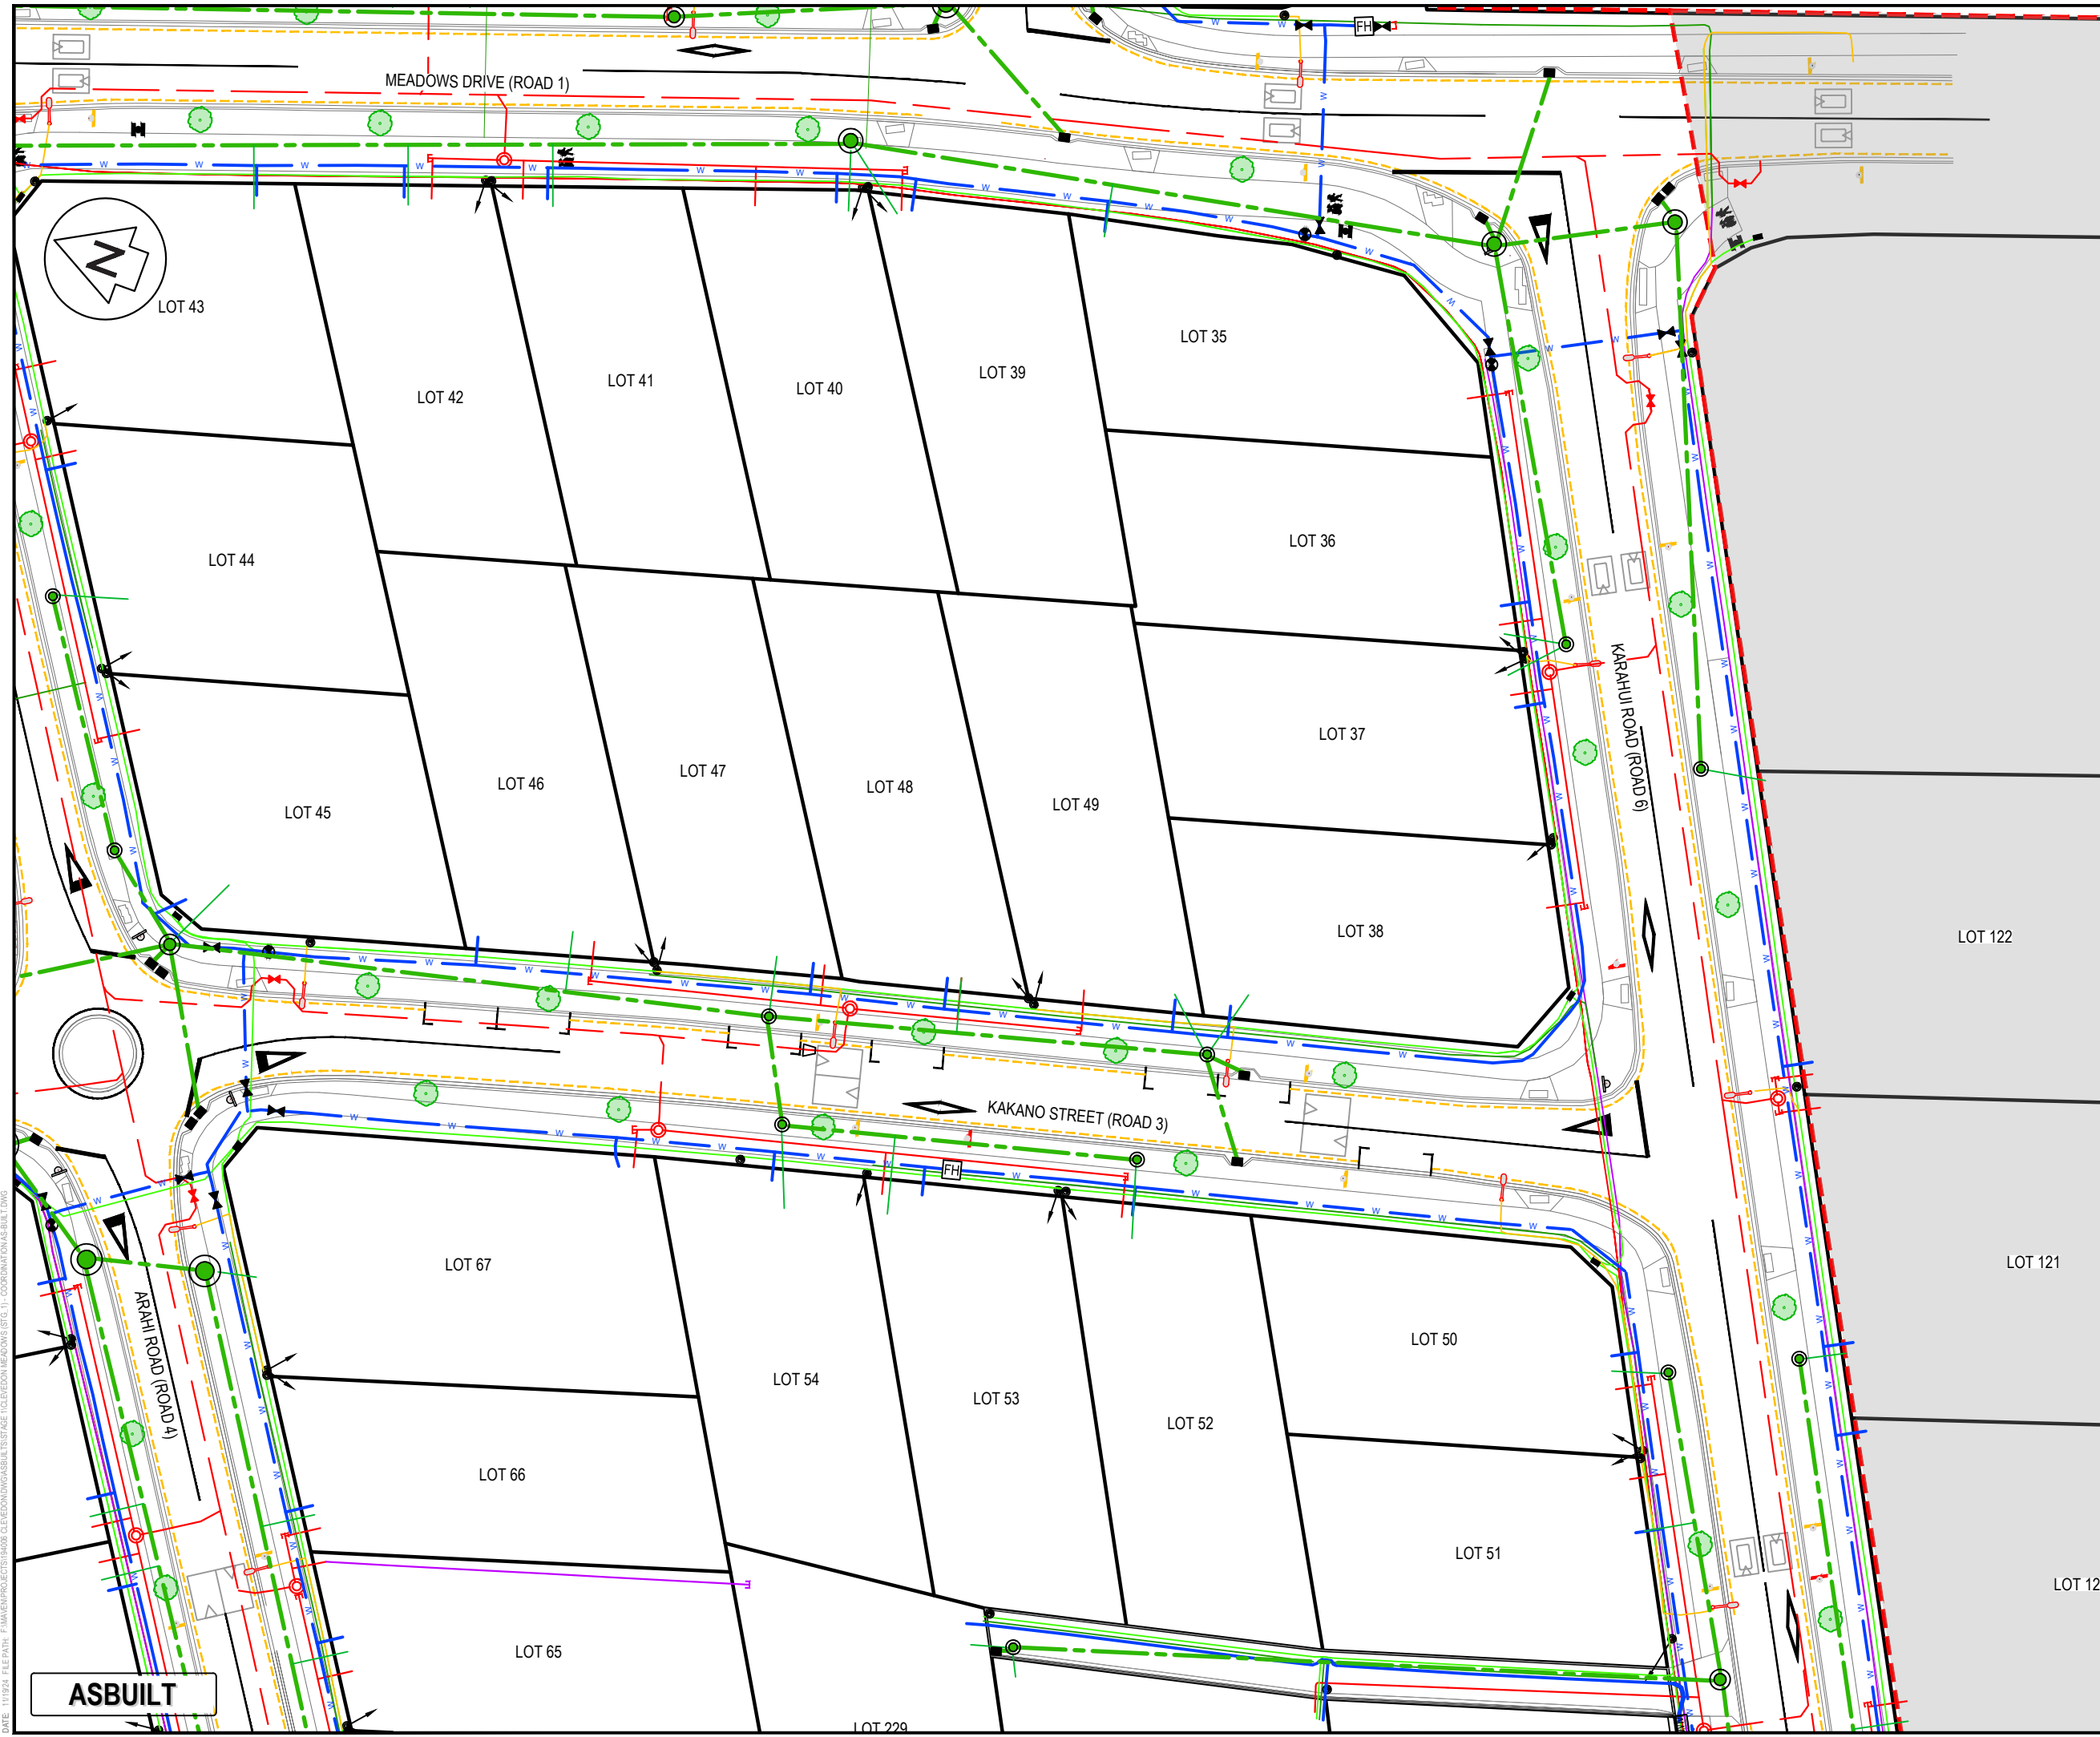

NOTES

- WORKS CARRIED OUT BY DEMPSEY WOOD.
- CONSTRUCTED IN ACCORDANCE WITH AUCKLAND COUNCIL STANDARDS.

Legend - Roading

- EX BDY
- AB BDY
- STAGE BDY
- AB NSAAT LINE
- AB ROAD SIGN/STREETLIGHT
- AB SPEED HUMP / CUSHION
- AB STREET TREE

Legend - Stormwater

- AB SW PIPES
- AB LOT CONNECTION
- AB SWMH / SWCP
- AB SW OUTLET

Legend - Wastewater

- EX RISING MAIN
- EX VACUUM LINE
- AB VACUUM LINE
- AB GRAVITY LINE
- AB VALVE PIT
- AB VALVE / REDUCER / CAP

Legend - Water

- EX WATERMAIN
- EX/AB HYDRANT / METER
- EX SLUICE / PEET VALVE
- AB WATERMAIN
- AB SLUICE / PEET VALVE

Legend - Power

- LV POWER 100
- HV POWER 140
- STREETLIGHT LINE
- LINK PILLAR / SERVICE PIT
- TRANSFORMER/SWITCHGEAR

Legend - Comms

- AB 1wM MICRONET
- AB 1wR RIBBONET
- AB 7wM MICRONET
- AB 12wR RIBBONET
- AB 26wR RIBBONET
- TELECOM TUD/CHORUS PIT

A	FOR INFORMATION ONLY	ML	11/2024
Rev	Description	By	Date
Survey	DEMPSEY WOOD	08/2024	
Design	ML	08/2024	
Drawn	ML	08/2024	
Checked	JD	08/2024	

Maven Associates
09 571 0050
info@maven.co.nz
www.maven.co.nz
5 Owens Road, Epsom
Auckland 1023

Project

**62, 78 AND 80 PAPAURA -
CLEVEDON ROAD,
CLEVEDON, AUCKLAND
FOR CLEVEDON
PROPERTIES LTD**


Title

**ENG60407601 STAGE 1
COORDINATION
ASBUILT PLAN**

Project no.	194006		
Scale	1:500 @ A3		
Cad file	CLEVEDON MEADOWS (STG. 1) - COORDINATION AS-BUILT.DWG		
Drawing no.	STG_1 C915	Rev	A

DATE: 11/2024 FILE PATH: E:\Maven\Projects\60407601 CLEVEDON MEADOWS\STG. 1 - COORDINATION AS-BUILT.DWG

ASBUILT

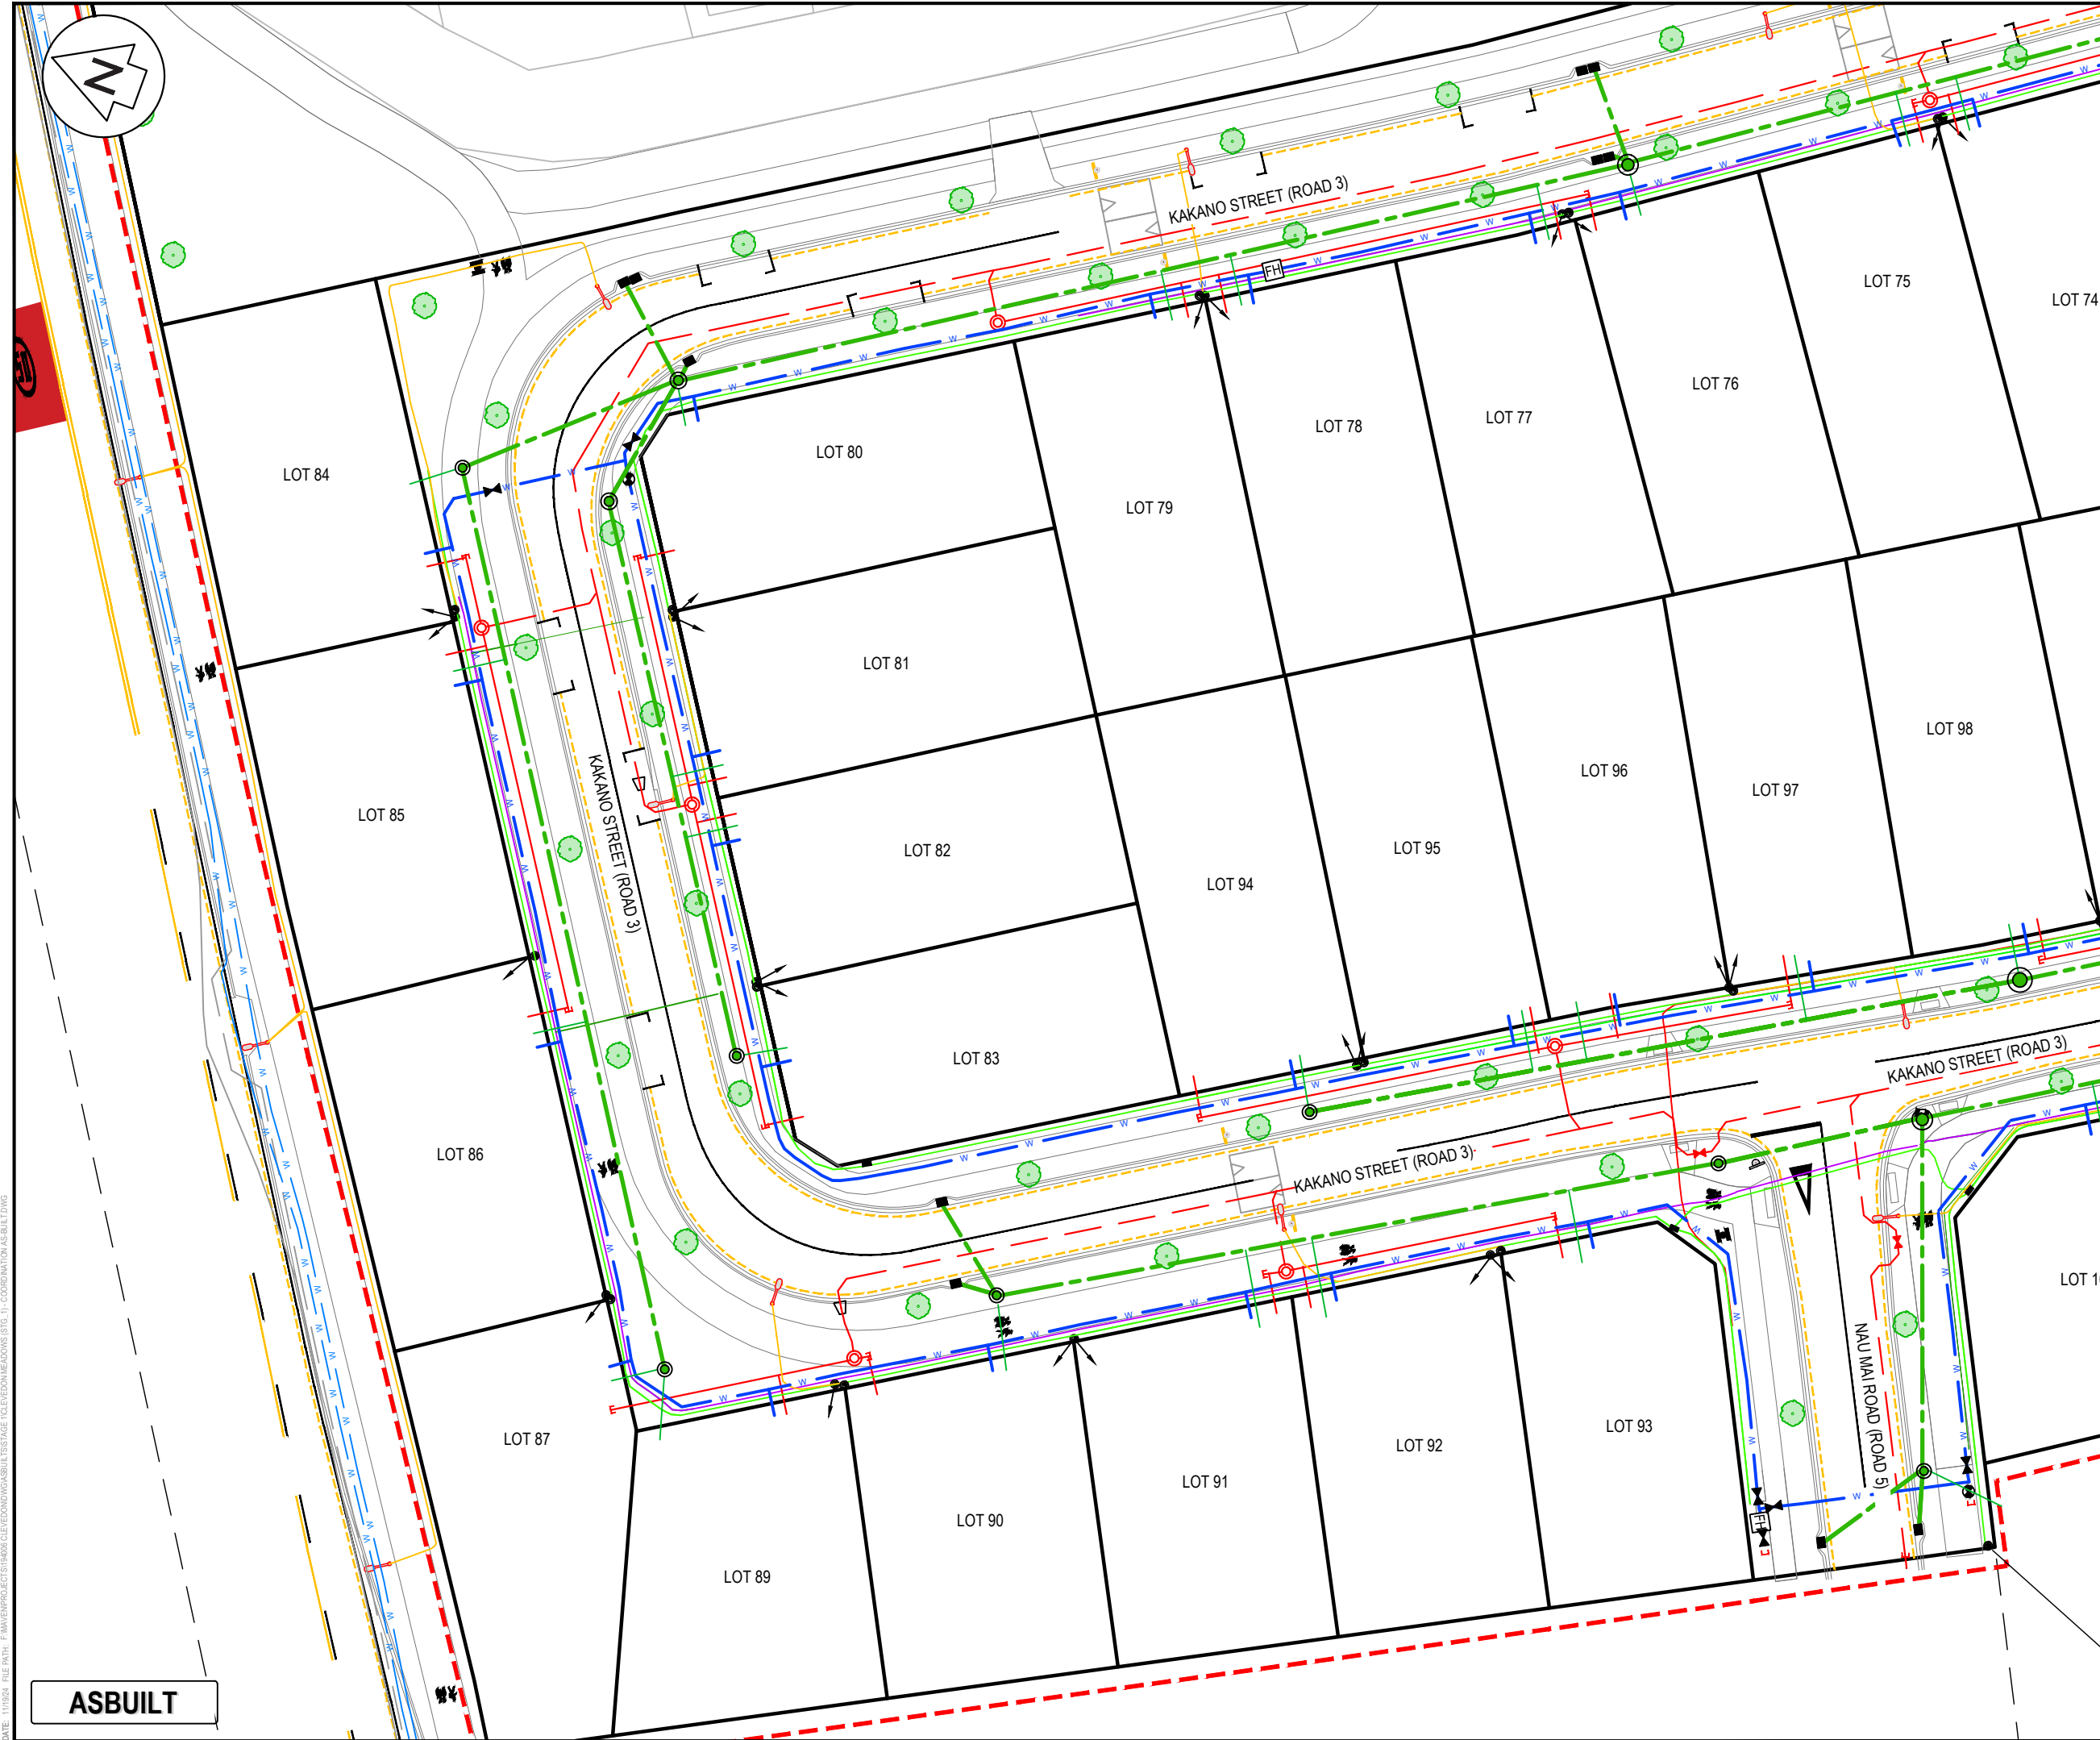

NOTES

- WORKS CARRIED OUT BY DEMPSEY WOOD.
- CONSTRUCTED IN ACCORDANCE WITH AUCKLAND COUNCIL STANDARDS.

Legend - Roading

- EX BDY
- AB BDY
- STAGE BDY
- AB NSAAT LINE
- AB ROAD SIGN/STREETLIGHT
- AB SPEED HUMP / CUSHION
- AB STREET TREE

Legend - Stormwater

- AB SW PIPES
- AB LOT CONNECTION
- AB SWMH / SWCP
- AB SW OUTLET

Legend - Wastewater

- EX RISING MAIN
- EX VACUUM LINE
- AB VACUUM LINE
- AB GRAVITY LINE
- AB VALVE PIT
- AB VALVE / REDUCER / CAP

Legend - Water

- EX WATERMAIN
- EX/AB HYDRANT / METER
- EX SLUICE / PEET VALVE
- AB WATERMAIN
- AB SLUICE / PEET VALVE

Legend - Power

- LV POWER 100
- HV POWER 140
- STREETLIGHT LINE
- LINK PILLAR / SERVICE PIT
- TRANSFORMER/SWITCHGEAR

Legend - Comms

- AB 1wM MICRONET
- AB 1wR RIBBONET
- AB 7wM MICRONET
- AB 12wR RIBBONET
- AB 26wR RIBBONET
- TELECOM TUD/CHORUS PIT

A	FOR INFORMATION ONLY	ML	11/2024
Rev	Description	By	Date
Survey	DEMPSEY WOOD		08/2024
Design	ML		08/2024
Drawn	ML		08/2024
Checked	JD		08/2024

M
M A V E N

Maven Associates
09 571 0050
info@maven.co.nz
www.maven.co.nz
5 Owens Road, Epsom
Auckland 1023


Project
**62, 78 AND 80 PAPAKURA -
CLEVEDON ROAD,
CLEVEDON, AUCKLAND
FOR CLEVEDON
PROPERTIES LTD**

Title
**ENG60407601 STAGE 1
COORDINATION
ASBUILT PLAN**

Project no.	194006
Scale	1:500 @ A3
Cad file	CLEVEDON MEADOWS (STG_1) - COORDINATION AS-BUILT.DWG
Drawing no.	STG_1 C916
Rev	A

ASBUILT

DATE: 11/2024 FILE PATH: E:\Maven\Projects\194006\Clevedon Meadows (STG_1) COORDINATION AS-BUILT.DWG

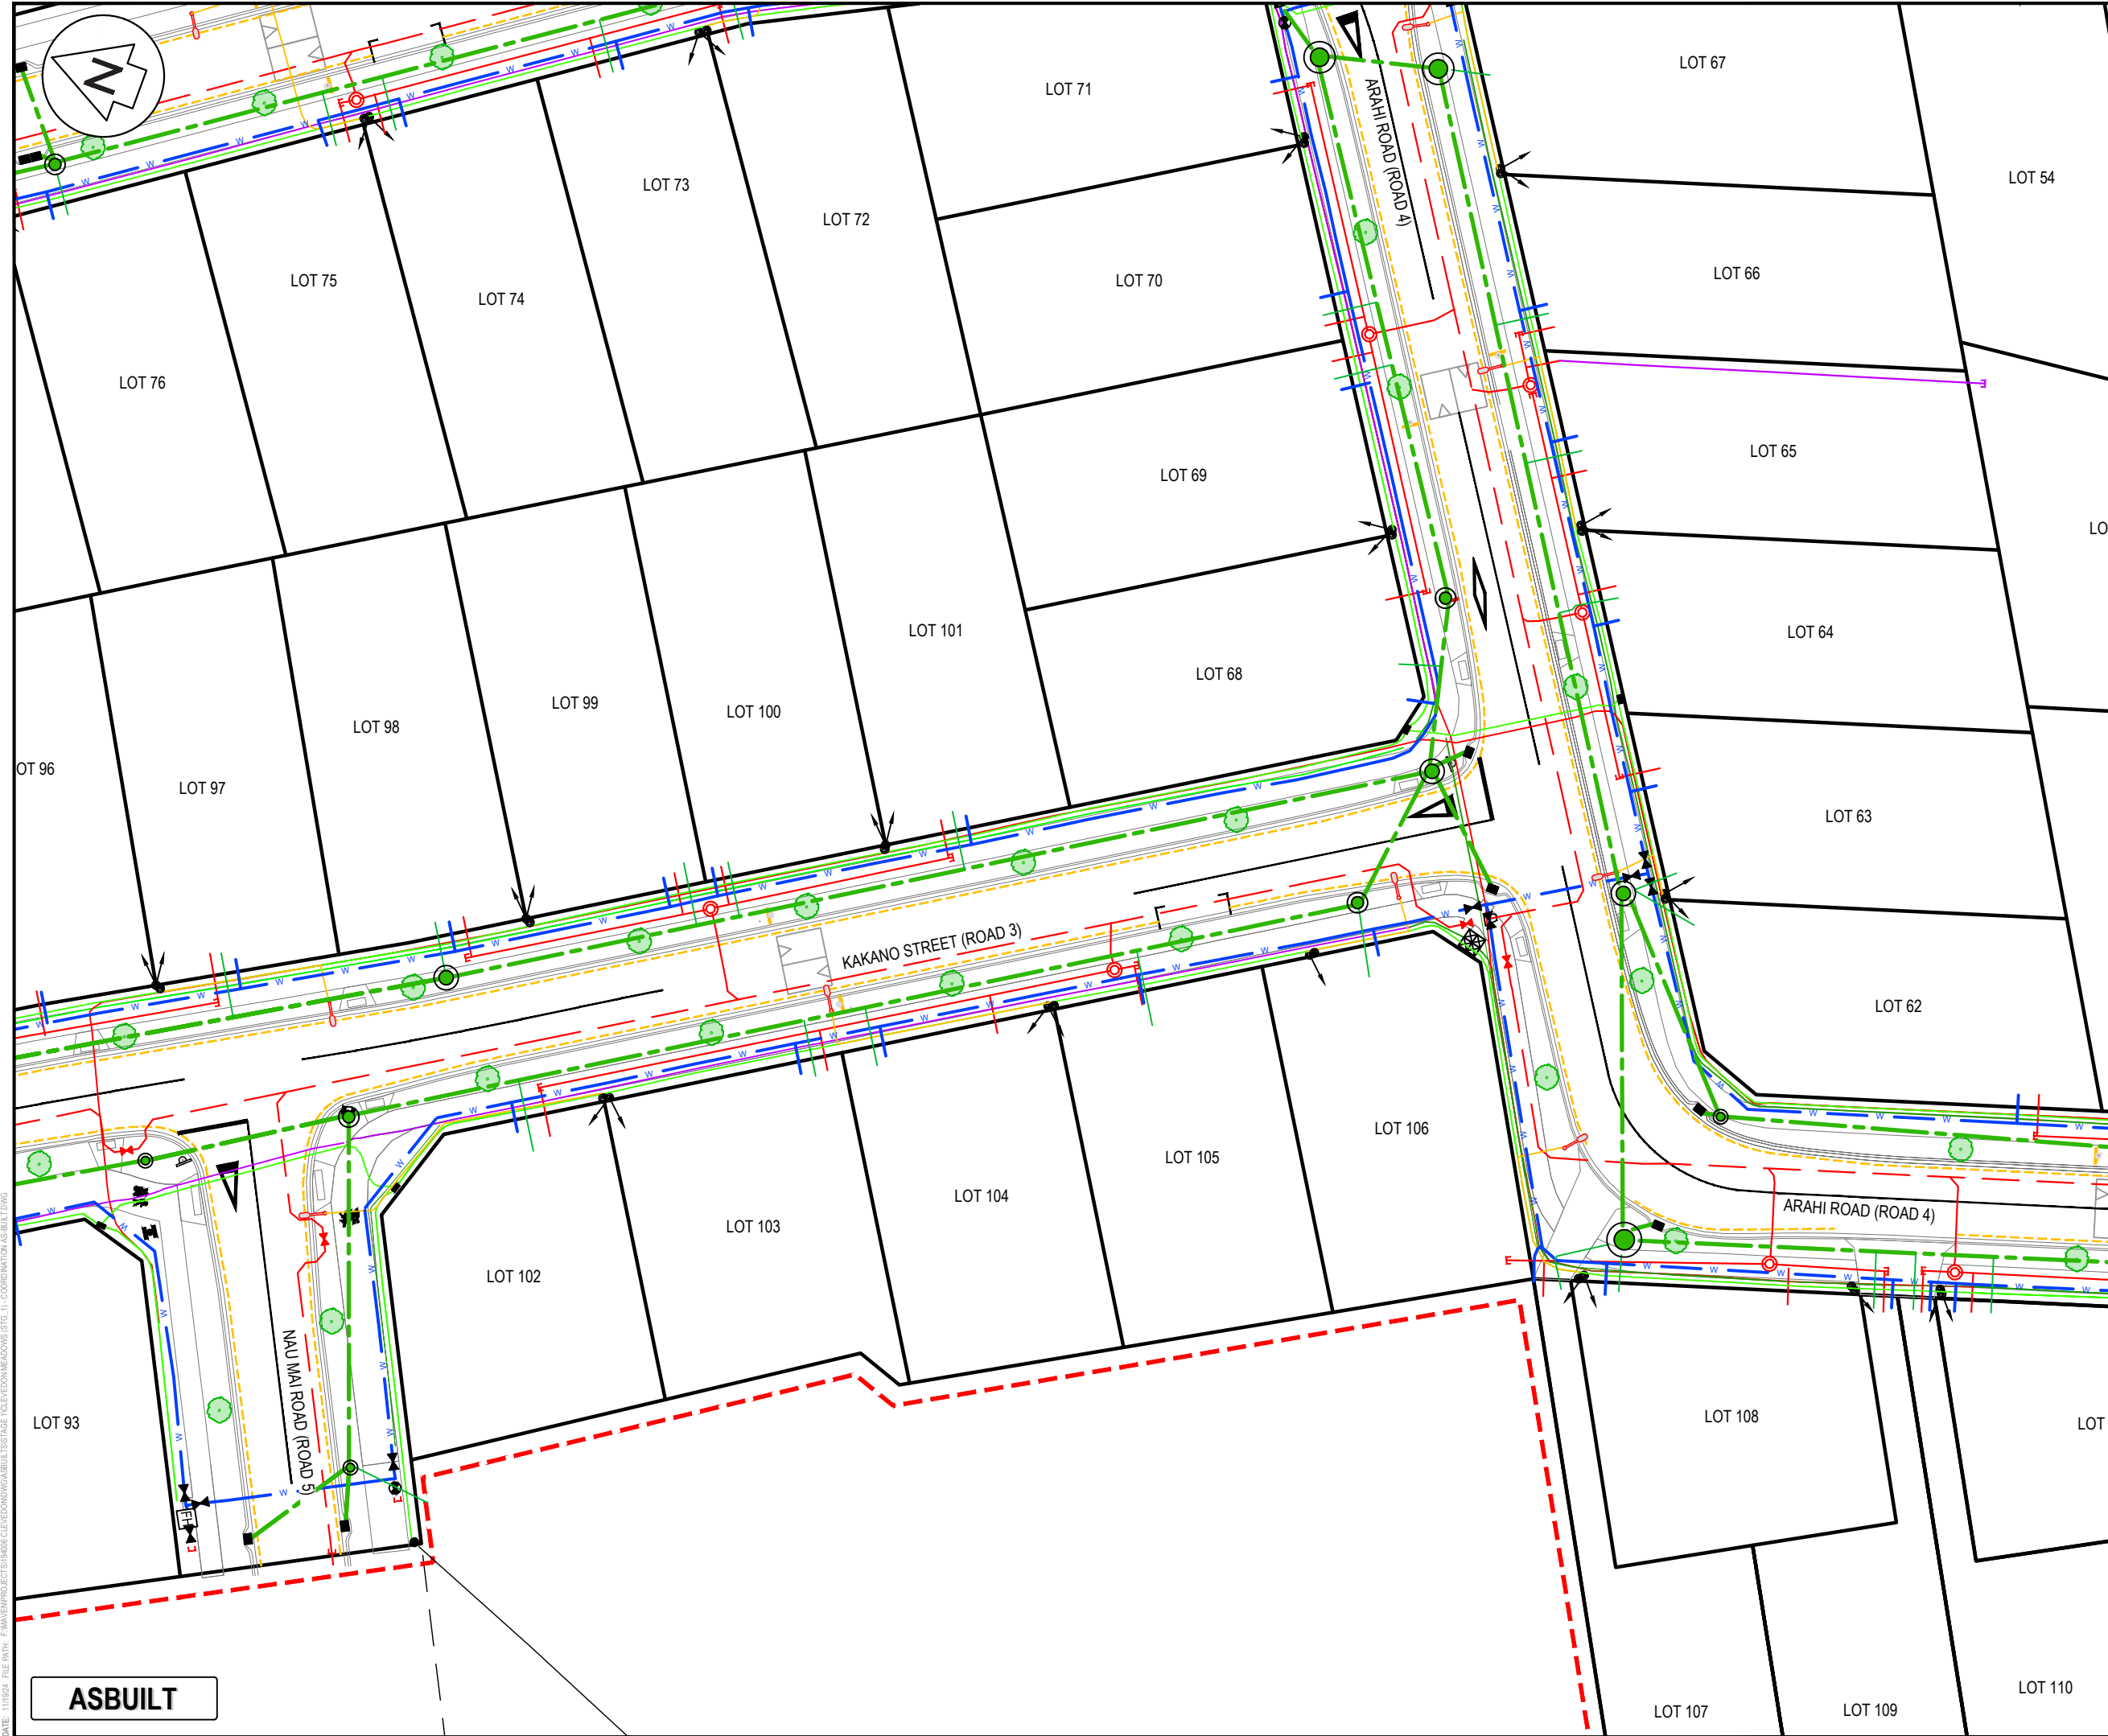

NOTES

- WORKS CARRIED OUT BY DEMPSEY WOOD.
- CONSTRUCTED IN ACCORDANCE WITH AUCKLAND COUNCIL STANDARDS.

Legend - Roading

- EX BDY
- AB BDY
- STAGE BDY
- AB NSAAT LINE
- AB ROAD SIGN/STREETLIGHT
- AB SPEED HUMP / CUSHION
- AB STREET TREE

Legend - Stormwater

- AB SW PIPES
- AB LOT CONNECTION
- AB SWMH / SWCP
- AB SW OUTLET

Legend - Wastewater

- EX RISING MAIN
- EX VACUUM LINE
- AB VACUUM LINE
- AB GRAVITY LINE
- AB VALVE PIT
- AB VALVE / REDUCER / CAP

Legend - Water

- EX WATERMAIN
- EX/AB HYDRANT / METER
- EX SLUICE / PEET VALVE
- AB WATERMAIN
- AB SLUICE / PEET VALVE

Legend - Power

- LV POWER 100
- HV POWER 140
- STREETLIGHT LINE
- LINK PILLAR / SERVICE PIT
- TRANSFORMER/SWITCHGEAR

Legend - Comms

- AB 1wM MICRONET
- AB 1wR RIBBONET
- AB 7wM MICRONET
- AB 12wR RIBBONET
- AB 26wR RIBBONET
- TELECOM TUD/CHORUS PIT

A	FOR INFORMATION ONLY	ML	11/2024
Rev	Description	By	Date
Survey	DEMPSEY WOOD		08/2024
Design	ML		08/2024
Drawn	ML		08/2024
Checked	JD		08/2024

Maven Associates
09 571 0050
info@maven.co.nz
www.maven.co.nz
5 Owens Road, Epsom
Auckland 1023


Project
**62, 78 AND 80 PAPAKURA -
CLEVEDON ROAD,
CLEVEDON, AUCKLAND
FOR CLEVEDON
PROPERTIES LTD**

Title
**ENG60407601 STAGE 1
COORDINATION
ASBUILT PLAN**

Project no.	194006
Scale	1:500 @ A3
Cad file	CLEVEDON MEADOWS (STG_1) - COORDINATION AS-BUILT.DWG
Drawing no.	STG_1 C917
Rev	A

DATE: 11/2024 FILE PATH: E:\Maven\Projects\194006\Clevedon Meadows\STG_1 - COORDINATION AS-BUILT.DWG

ASBUILT

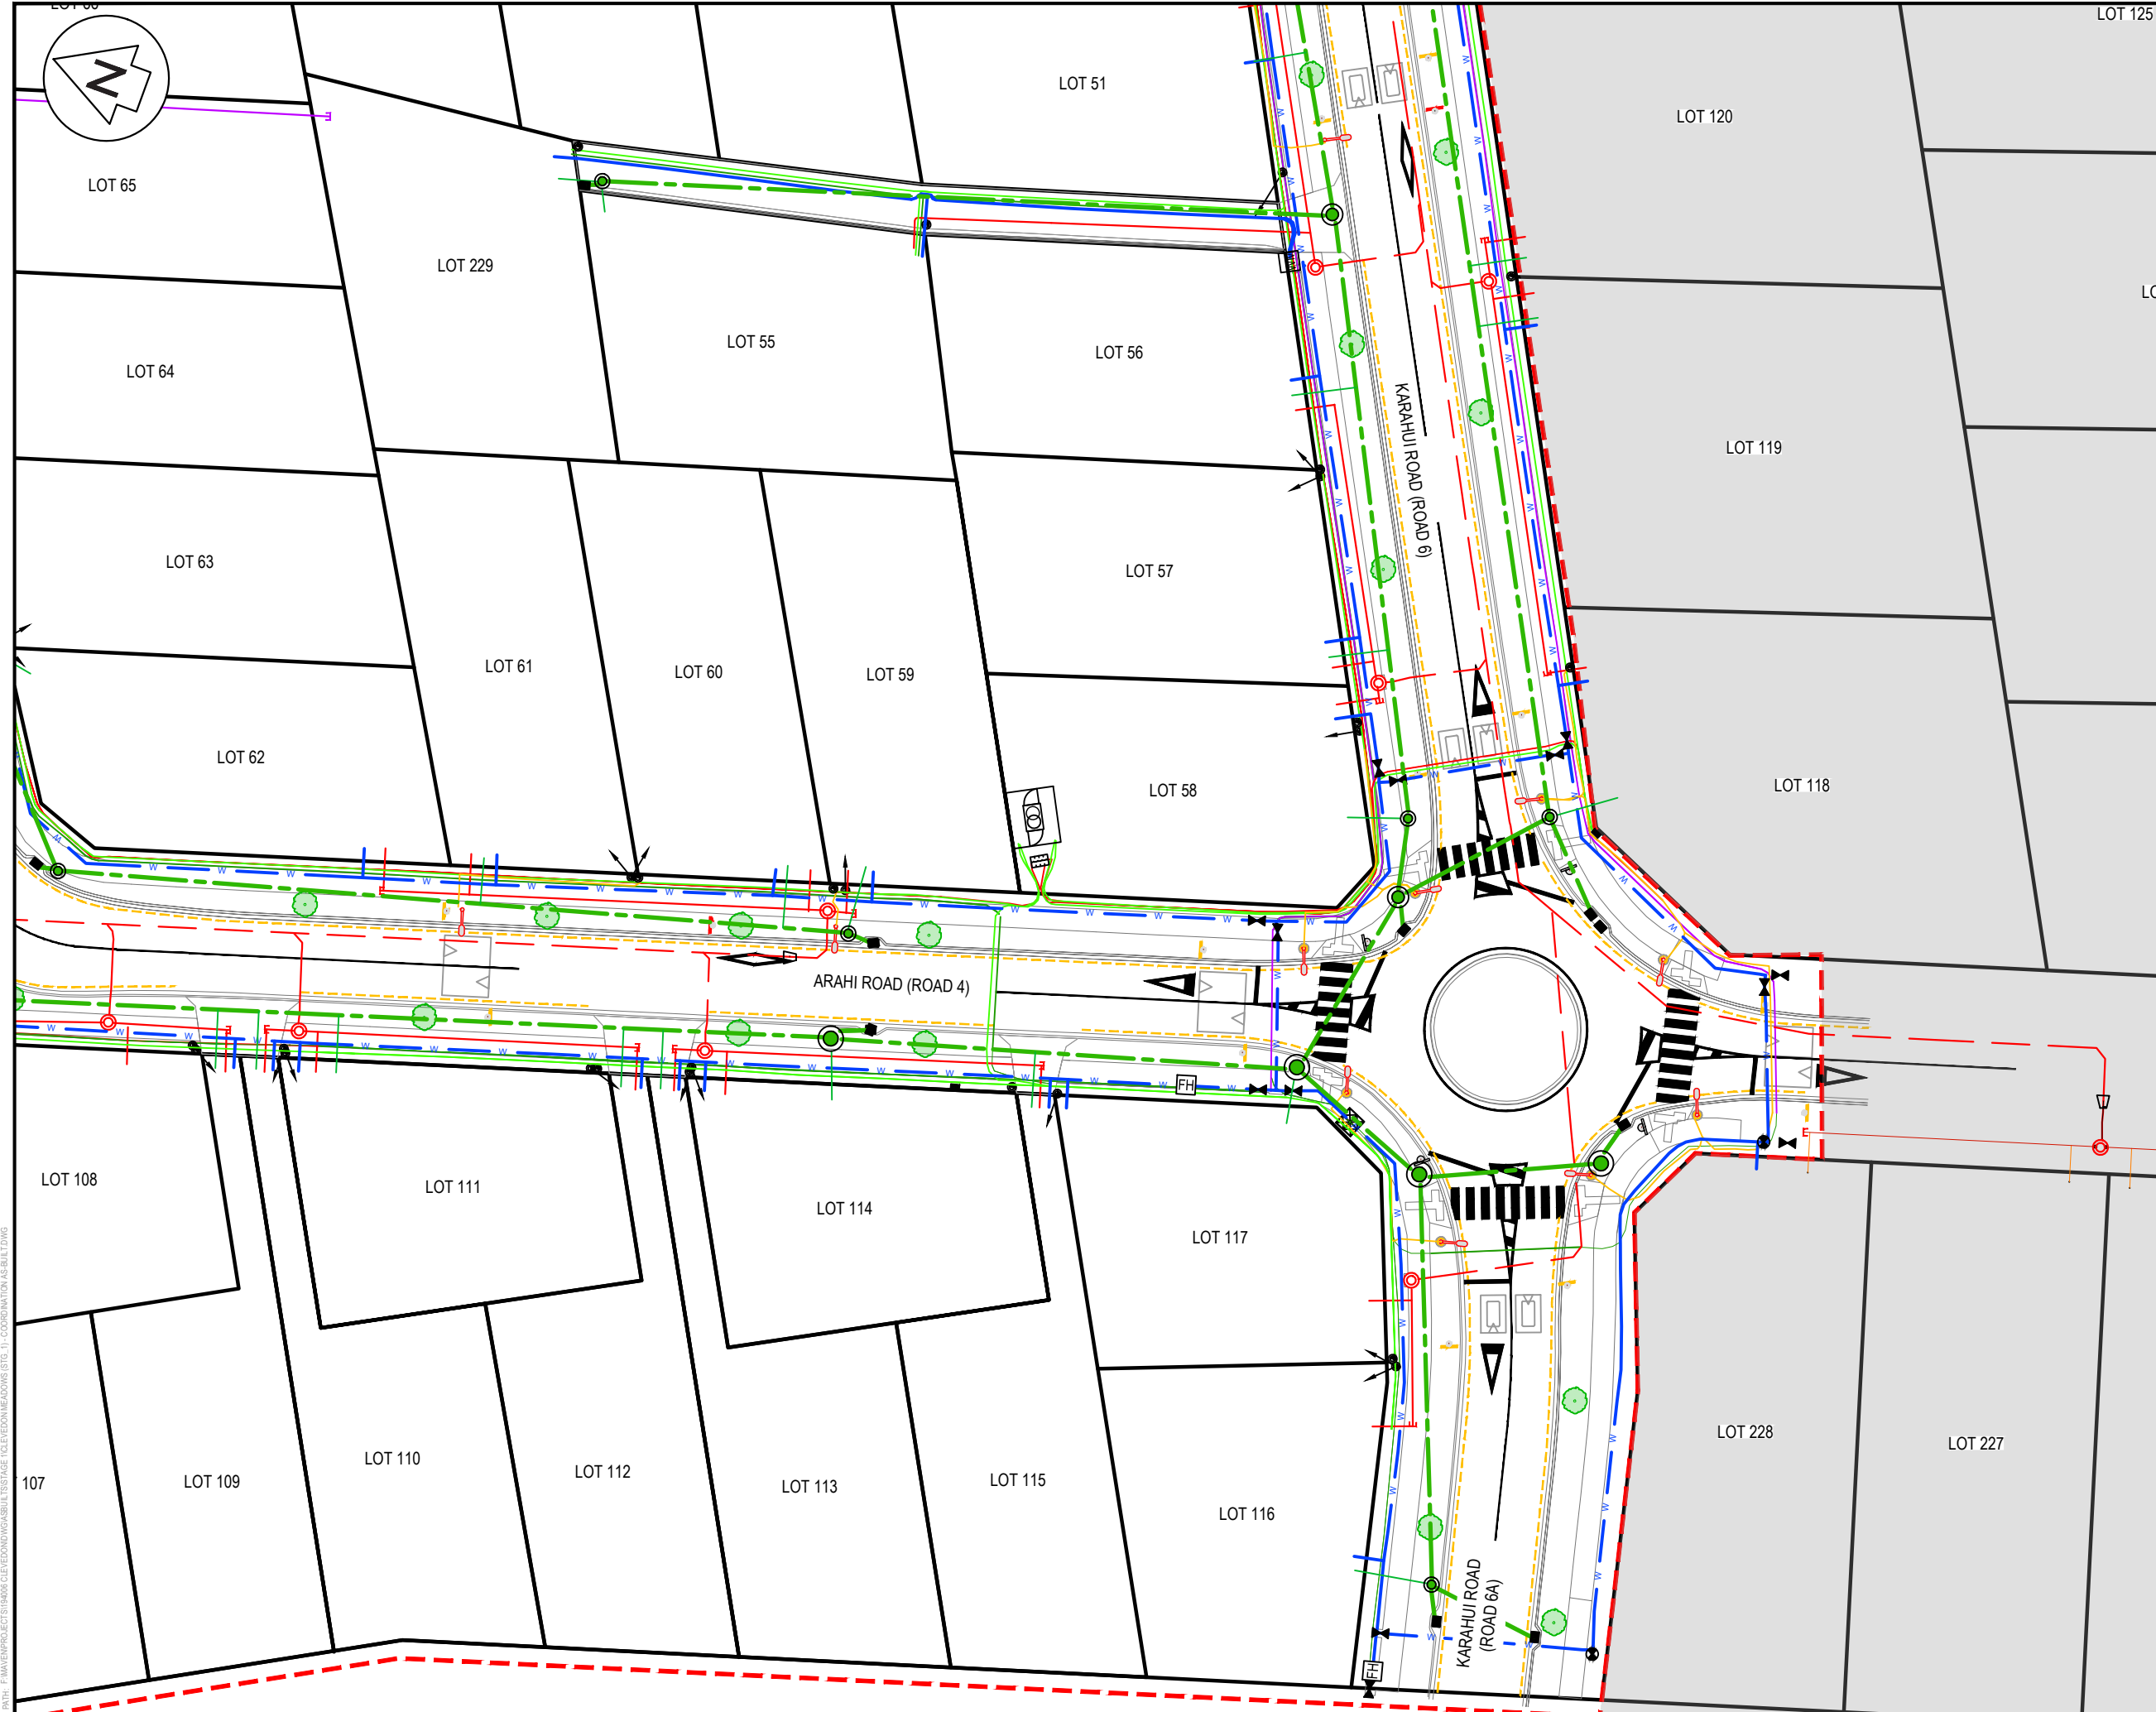

NOTES

1. WORKS CARRIED OUT BY DEMPSEY WOOD.

2. CONSTRUCTED IN ACCORDANCE WITH AUCKLAND COUNCIL STANDARDS.

Legend - Roading

- EX BDY
- AB BDY
- STAGE BDY
- AB NSAAT LINE
- AB ROAD SIGN/STREETLIGHT
- AB SPEED HUMP / CUSHION
- AB STREET TREE

Legend - Stormwater

- AB SW PIPES
- AB LOT CONNECTION
- AB SWMH / SWCP
- AB SW OUTLET

Legend - Wastewater

- EX RISING MAIN
- EX VACUUM LINE
- AB VACUUM LINE
- AB GRAVITY LINE
- AB VALVE PIT
- AB VALVE / REDUCER / CAP

Legend - Water

- EX WATERMAIN
- EX/AB HYDRANT / METER
- EX SLUICE / PEET VALVE
- AB WATERMAIN
- AB SLUICE / PEET VALVE

Legend - Power

- LV POWER 100
- HV POWER 140
- STREETLIGHT LINE
- LINK PILLAR / SERVICE PIT
- TRANSFORMER/SWITCHGEAR

Legend - Comms

- AB 1wM MICRONET
- AB 1wR RIBBONET
- AB 7wM MICRONET
- AB 12wR RIBBONET
- AB 26wR RIBBONET
- TELECOM TUD/CHORUS PIT

A	FOR INFORMATION ONLY	ML	11/2024
Rev	Description	By	Date
Survey	DEMPSEY WOOD		08/2024
Design	ML		08/2024
Drawn	ML		08/2024
Checked	JD		08/2024

M **Maven Associates**
09 571 0050
info@maven.co.nz
www.maven.co.nz
5 Owens Road, Epsom
Auckland 1023

Project
**62, 78 AND 80 PAPAKURA -
CLEVEDON ROAD,
CLEVEDON, AUCKLAND
FOR CLEVEDON
PROPERTIES LTD**

Title
**ENG60407601 STAGE 1
COORDINATION
ASBUILT PLAN**

Project no.	194006		
Scale	1:500 @ A3		
Cad file	CLEVEDON MEADOWS (STG_1) - COORDINATION AS-BUILT.DWG		
Drawing no.	STG_1 C918	Rev	A

DATE: 11/2024 FILE PATH: E:\MVEN\PROJECTS\194006\CLEVEDON MEADOWS (STG_1) COORDINATION AS-BUILT.DWG

ASBUILT