

CERTIFICATION

I CERTIFY THAT THESE AS-BUILT PLANS ARE AN ACCURATE RECORD OF THE WORKS UNDERTAKEN AND THAT:

THE COORDINATES (X, Y) ARE IN TERMS OF NZTM ON NZGD (2000), AND ARE WITHIN + 50MM.

THE LEVELS (Z) ARE IN TERMS OF THE NEW ZEALAND 2016 (MSL) LINZ DATUM (DOSLI DATUM), AND ARE WITHIN THE FOLLOWING TOLERANCES:


FOR ALL PIPE INVERTS & ROADSIDE CHANNELS TO BE WITHIN +/- 10MM (LOCAL CIRCUIT I.E. INTERNAL/RELATIVE CONSISTENCY REQUIRED ONLY)

FOR ALL OTHER ASSETS +/-20MM (E.G. MANHOLE COVERS, EARTHWORKS)

NAME:

REECE MOODY

SIGNED:

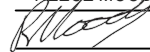

Licensed Cadastral Surveyor

REGISTRATION NUMBER:

1161724

DATE:

06/11/2024

CONTACT PHONE:

09 242 2717

EMAIL:

reecem@maven.co.nz

- NOTES
1.

ALL WORKS TO BE IN ACCORDANCE WITH AUCKLAND COUNCIL STANDARDS.
2.

COORDINATES IN TERMS OF NEW ZEALAND TRANSVERSE MERCATOR 2000 (NZTM 2000).
3.

LEVELS IN TERMS OF NEW ZEALAND VERTICAL DATUM 2016 (NZVD2016).  
ORIGIN OF LEVELS = RM 5846 SO 58211
4.

PUBLISHED RL=10.309, SOURCED FROM THE LINZ DIGITAL GEODETIC DATABASE.BOTANICAL SPECIES NAMES/ COMMON NAMES ARE:  
CB: CARPINUS BETULUS 'FASTIGIATA' / UPRIGHT EUROPEAN HORNBEAM  
DS: DYSOXYLUM SPECTABILE / KOHEKOHE  
AE: ALECTRYON EXCELSUS / TITOKI  
BT: BEILSCHMIEDIA TARAIRE / TARAIRE  
VL: VITEX LUCENS / PURIRI  
EU: EUGENIA VENTENATI / LILLY PILLY

STAGE 1

STAGE 2

STAGE 3

STAGE 4

Legend

EX BDY

AB BDY

STAGE BDY

AB TREES

AB BERM

|         |              |    |         |
|---------|--------------|----|---------|
|         |              |    |         |
|         |              |    |         |
|         |              |    |         |
| A       | ASBUILT      | ML | 10/2024 |
| Rev     | Description  | By | Date    |
|         |              | By | Date    |
| Survey  | DEMPSEY WOOD |    | 08/2024 |
| Design  | ML           |    | 08/2024 |
| Drawn   | ML           |    | 09/2024 |
| Checked | JD           |    | 08/2024 |

M

A

E

N

Maven Associates

09 571 0050

info@maven.co.nz

www.maven.co.nz

5 Owens Road, Epsom

Auckland 1023

Project

62, 78 AND 80 PAKAKURA - CLEVEDON ROAD, CLEVEDON, AUCKLAND FOR CLEVEDON PROPERTIES LTD

Title


ENG60407601 STAGE 1 LANDSCAPE ASBUILT OVERVIEW PLAN

|             |                                                             |
|-------------|-------------------------------------------------------------|
| Project no. | 194006                                                      |
| Scale       | 1:3500 @ A3                                                 |
| Cad file    | ENG60407601 - CLEVEDON MEADOWS - C950 LANDSCAPE ASBUILT.DWG |
| Drawing no. | STG_1 C950                                                  |
| Rev         | A                                                           |

DATE: 11/13/24 FILE PATH: \\MAVEN\MAVENCONSULTING\CO\NZ\SHARE\CURRENT\WAIWEN\PROJECTS\194006\CLEVEDON MEADOWS - C950 LANDSCAPE ASBUILT.DWG

ASBUILT

DATE: 11/13/24 FILE PATH: \\MAVEN\MAVENCONSULTING\CON\SHARECURRENT\WAVEPROJECTS\194006 CLEVEDON MEADOWS - C950 LANDSCAPE ASBUILT.DWG

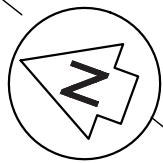

STAGE 4

DS 3

DS 1

DS 2

LOT 1

LOT 2

ACORN PARISH LANE (ROAD 2)

CB 34

CB 36

CB 35

MEADOWS DRIVE (ROAD 1)

CB 144

CB 146

CB 149

CB 148

MEADOWS DRIVE (ROAD 1)

CB 145

CB 143

CB 142

CB 33

CB 37

CB 150

CB 147

PAPAKURA-CLEVEDON ROAD

DS 151

TR 152

AE 153

DS 154

TR 155

- NOTES
1. ALL WORKS TO BE IN ACCORDANCE WITH AUCKLAND COUNCIL STANDARDS.
  2. COORDINATES IN TERMS OF NEW ZEALAND TRANSVERSE MERCATOR 2000 (NZTM 2000).
  3. LEVELS IN TERMS OF NEW ZEALAND VERTICAL DATUM 2016 (NZVD2016).  
ORIGIN OF LEVELS = RM 5846 SO 58211
  4. PUBLISHED RL=10.309, SOURCED FROM THE LINZ DIGITAL GEODETIC DATABASE. BOTANICAL SPECIES NAMES/ COMMON NAMES ARE:  
CB: CARPINUS BETULUS 'FASTIGIATA' / UPRIGHT EUROPEAN HORNBEAM  
DS: DYSOXYLUM SPECTABILE / KOHEKOHE  
AE: ALECTRYON EXCELSUS / TITOKI  
BT: BEILSCHMIEDIA TARAIRE / TARAIRE  
VL: VITEX LUCENS / PURIRI  
EU: EUGENIA VENTENATI / LILLY PILLY

Legend

|     |           |
|-----|-----------|
| --- | EX BDY    |
| --- | AB BDY    |
| --- | STAGE BDY |
| ●   | AB TREES  |
| ■   | AB BERM   |

|         |              |         |         |
|---------|--------------|---------|---------|
| A       | ASBUILT      | ML      | 10/2024 |
| Rev     | Description  | By      | Date    |
|         |              | By      | Date    |
| Survey  | DEMPSEY WOOD | 08/2024 |         |
| Design  | ML           | 08/2024 |         |
| Drawn   | ML           | 09/2024 |         |
| Checked | JD           | 08/2024 |         |

**M** **Maven Associates**  
09 571 0050  
info@maven.co.nz  
www.maven.co.nz  
5 Owens Road, Epsom  
Auckland 1023

Project  
**62, 78 AND 80 PAPAKURA -  
CLEVEDON ROAD,  
CLEVEDON, AUCKLAND  
FOR CLEVEDON  
PROPERTIES LTD**

Title  
**ENG60407601 STAGE 1  
LANDSCAPE ASBUILT  
PLAN**

|             |                                                             |
|-------------|-------------------------------------------------------------|
| Project no. | 194006                                                      |
| Scale       | 1:500 @ A3                                                  |
| Cad file    | ENG60407601 - CLEVEDON MEADOWS - C950 LANDSCAPE ASBUILT.DWG |
| Drawing no. | STG_1 C951                                                  |
| Rev         | <b>A</b>                                                    |

CERTIFICATION

I CERTIFY THAT THESE AS-BUILT PLANS ARE AN ACCURATE RECORD OF THE WORKS UNDERTAKEN AND THAT:

- THE COORDINATES (X, Y) ARE IN TERMS OF NZTM ON NZGD (2000), AND ARE WITHIN + 50MM.
- THE LEVELS (Z) ARE IN TERMS OF THE NEW ZEALAND 2016 (MSL) LINZ DATUM (DOSLI DATUM), AND ARE WITHIN THE FOLLOWING TOLERANCES:

- FOR ALL PIPE INVERTS & ROADSIDE CHANNELS TO BE WITHIN +/- 10MM (LOCAL CIRCUIT I.E. INTERNAL/RELATIVE CONSISTENCY REQUIRED ONLY)
- FOR ALL OTHER ASSETS +/-20MM (E.G. MANHOLE COVERS, EARTHWORKS)

NAME: REECE MOODY


SIGNED: *[Signature]*  
Licensed Cadastral Surveyor

REGISTRATION NUMBER: 1161724 DATE: 06/11/2024

CONTACT PHONE: 09 242 2717

EMAIL: reecem@maven.co.nz

ASBUILT

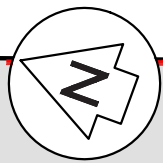

CERTIFICATION

I CERTIFY THAT THESE AS-BUILT PLANS ARE AN ACCURATE RECORD OF THE WORKS UNDERTAKEN AND THAT:

- THE COORDINATES (X, Y) ARE IN TERMS OF NZTM ON NZGD (2000), AND ARE WITHIN + 50MM.
- THE LEVELS (Z) ARE IN TERMS OF THE NEW ZEALAND 2016 (MSL) LINZ DATUM (DOSLI DATUM), AND ARE WITHIN THE FOLLOWING TOLERANCES:
  - FOR ALL PIPE INVERTS & ROADSIDE CHANNELS TO BE WITHIN +/- 10MM (LOCAL CIRCUIT I.E. INTERNAL/RELATIVE CONSISTENCY REQUIRED ONLY)
  - FOR ALL OTHER ASSETS +/-20MM (E.G. MANHOLE COVERS, EARTHWORKS)

NAME: REECE MOODY

SIGNED:

REGISTRATION NUMBER: 1161724 DATE: 06/11/2024

CONTACT PHONE: 09 242 2717

EMAIL: reecem@maven.co.nz

- NOTES
1. ALL WORKS TO BE IN ACCORDANCE WITH AUCKLAND COUNCIL STANDARDS.

2. COORDINATES IN TERMS OF NEW ZEALAND TRANSVERSE MERCATOR 2000 (NZTM 2000).

3. LEVELS IN TERMS OF NEW ZEALAND VERTICAL DATUM 2016 (NZVD2016).  
ORIGIN OF LEVELS = RM 5846 SO 58211

4. PUBLISHED RL=10.309, SOURCED FROM THE LINZ DIGITAL GEODETIC DATABASE.BOTANICAL SPECIES NAMES/ COMMON NAMES ARE:  
CB: CARPINUS BETULUS 'FASTIGIATA' / UPRIGHT EUROPEAN HORNBEAM  
DS: DYSOXYLUM SPECTABILE / KOHEKOHE  
AE: ALECTRYON EXCELSUS / TITOKI  
BT: BEILSCHMIEDIA TARAIRE / TARAIRE  
VL: VITEX LUCENS / PURIRI  
EU: EUGENIA VENTENATI / LILLY PILLY

Legend

---

EX BDY

---

AB BDY

---

STAGE BDY

AB TREES

AB BERM

|         |              |         |         |
|---------|--------------|---------|---------|
|         |              |         |         |
|         |              |         |         |
|         |              |         |         |
| A       | ASBUILT      | ML      | 10/2024 |
| Rev     | Description  | By      | Date    |
|         | By           | Date    |         |
| Survey  | DEMPSEY WOOD | 08/2024 |         |
| Design  | ML           | 08/2024 |         |
| Drawn   | ML           | 09/2024 |         |
| Checked | JD           | 08/2024 |         |

Maven Associates  
09 571 0050  
info@maven.co.nz  
www.maven.co.nz  
5 Owens Road, Epsom  
Auckland 1023

Project

62, 78 AND 80 PAPAKURA - CLEVEDON ROAD, CLEVEDON, AUCKLAND FOR CLEVEDON PROPERTIES LTD

Title

ENG60407601 STAGE 1 LANDSCAPE ASBUILT PLAN

|             |                                                             |
|-------------|-------------------------------------------------------------|
| Project no. | 194006                                                      |
| Scale       | 1:500 @ A3                                                  |
| Cad file    | ENG60407601 - CLEVEDON MEADOWS - C950 LANDSCAPE ASBUILT.DWG |
| Drawing no. | STG_1 C952                                                  |
| Rev         | A                                                           |



ASBUILT

DATE: 11/13/24 FILE PATH: \\MAVEN\MAVENCONSULTING\CO\NZSHARED\CURRENT\WATER\PROJECTS\19406\CLEVEDON MEADOWS - C950 LANDSCAPE ASBUILT.DWG




CERTIFICATION

I CERTIFY THAT THESE AS-BUILT PLANS ARE AN ACCURATE RECORD OF THE WORKS UNDERTAKEN AND THAT:

- THE COORDINATES (X, Y) ARE IN TERMS OF NZTM ON NZGD (2000), AND ARE WITHIN + 50MM.
- THE LEVELS (Z) ARE IN TERMS OF THE NEW ZEALAND 2016 (MSL) LINZ DATUM (DOSLI DATUM), AND ARE WITHIN THE FOLLOWING TOLERANCES:
  - FOR ALL PIPE INVERTS & ROADSIDE CHANNELS TO BE WITHIN +/- 10MM (LOCAL CIRCUIT I.E. INTERNAL/RELATIVE CONSISTENCY REQUIRED ONLY)
  - FOR ALL OTHER ASSETS +/-20MM (E.G. MANHOLE COVERS, EARTHWORKS)

NAME: REECE MOODY

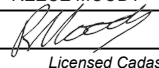SIGNED:  Licensed Cadastral Surveyor

REGISTRATION NUMBER: 1161724 DATE: 06/11/2024

CONTACT PHONE: 09 242 2717

EMAIL: reecem@maven.co.nz

NOTES

- ALL WORKS TO BE IN ACCORDANCE WITH AUCKLAND COUNCIL STANDARDS.
- COORDINATES IN TERMS OF NEW ZEALAND TRANSVERSE MERCATOR 2000 (NZTM 2000).
- LEVELS IN TERMS OF NEW ZEALAND VERTICAL DATUM 2016 (NZVD2016).  
ORIGIN OF LEVELS = RM 5846 SO 58211
- PUBLISHED RL=10.309, SOURCED FROM THE LINZ DIGITAL GEODETIC DATABASE.BOTANICAL SPECIES NAMES/ COMMON NAMES ARE:  
CB: CARPINUS BETULUS 'FASTIGIATA' / UPRIGHT EUROPEAN HORNBEAM  
DS: DYSOXYLUM SPECTABILE / KOHEKOHE  
AE: ALECTRYON EXCELSUS / TITOKI  
BT: BEILSCHMIEDIA TARAIRE / TARAIRE  
VL: VITEX LUCENS / PURIRI  
EU: EUGENIA VENTENATI / LILLY PILLY

Legend

---

EX BDY

---

AB BDY

---

STAGE BDY



AB TREES



AB BERM

Maven Associates  
09 571 0050  
info@maven.co.nz  
www.maven.co.nz  
5 Owens Road, Epsom  
Auckland 1023


Project

62, 78 AND 80 PAPAKURA - CLEVEDON ROAD, CLEVEDON, AUCKLAND FOR CLEVEDON PROPERTIES LTD

Title

ENG60407601 STAGE 1 LANDSCAPE ASBUILT PLAN

DATE: 11/13/24 FILE PATH: \\MAVEN\MAVENCONSULTING\CO\NZSHARED\CURRENT\WATER\PROJECTS\194006\CLEVEDON MEADOWS - C950 LANDSCAPE ASBUILT.DWG

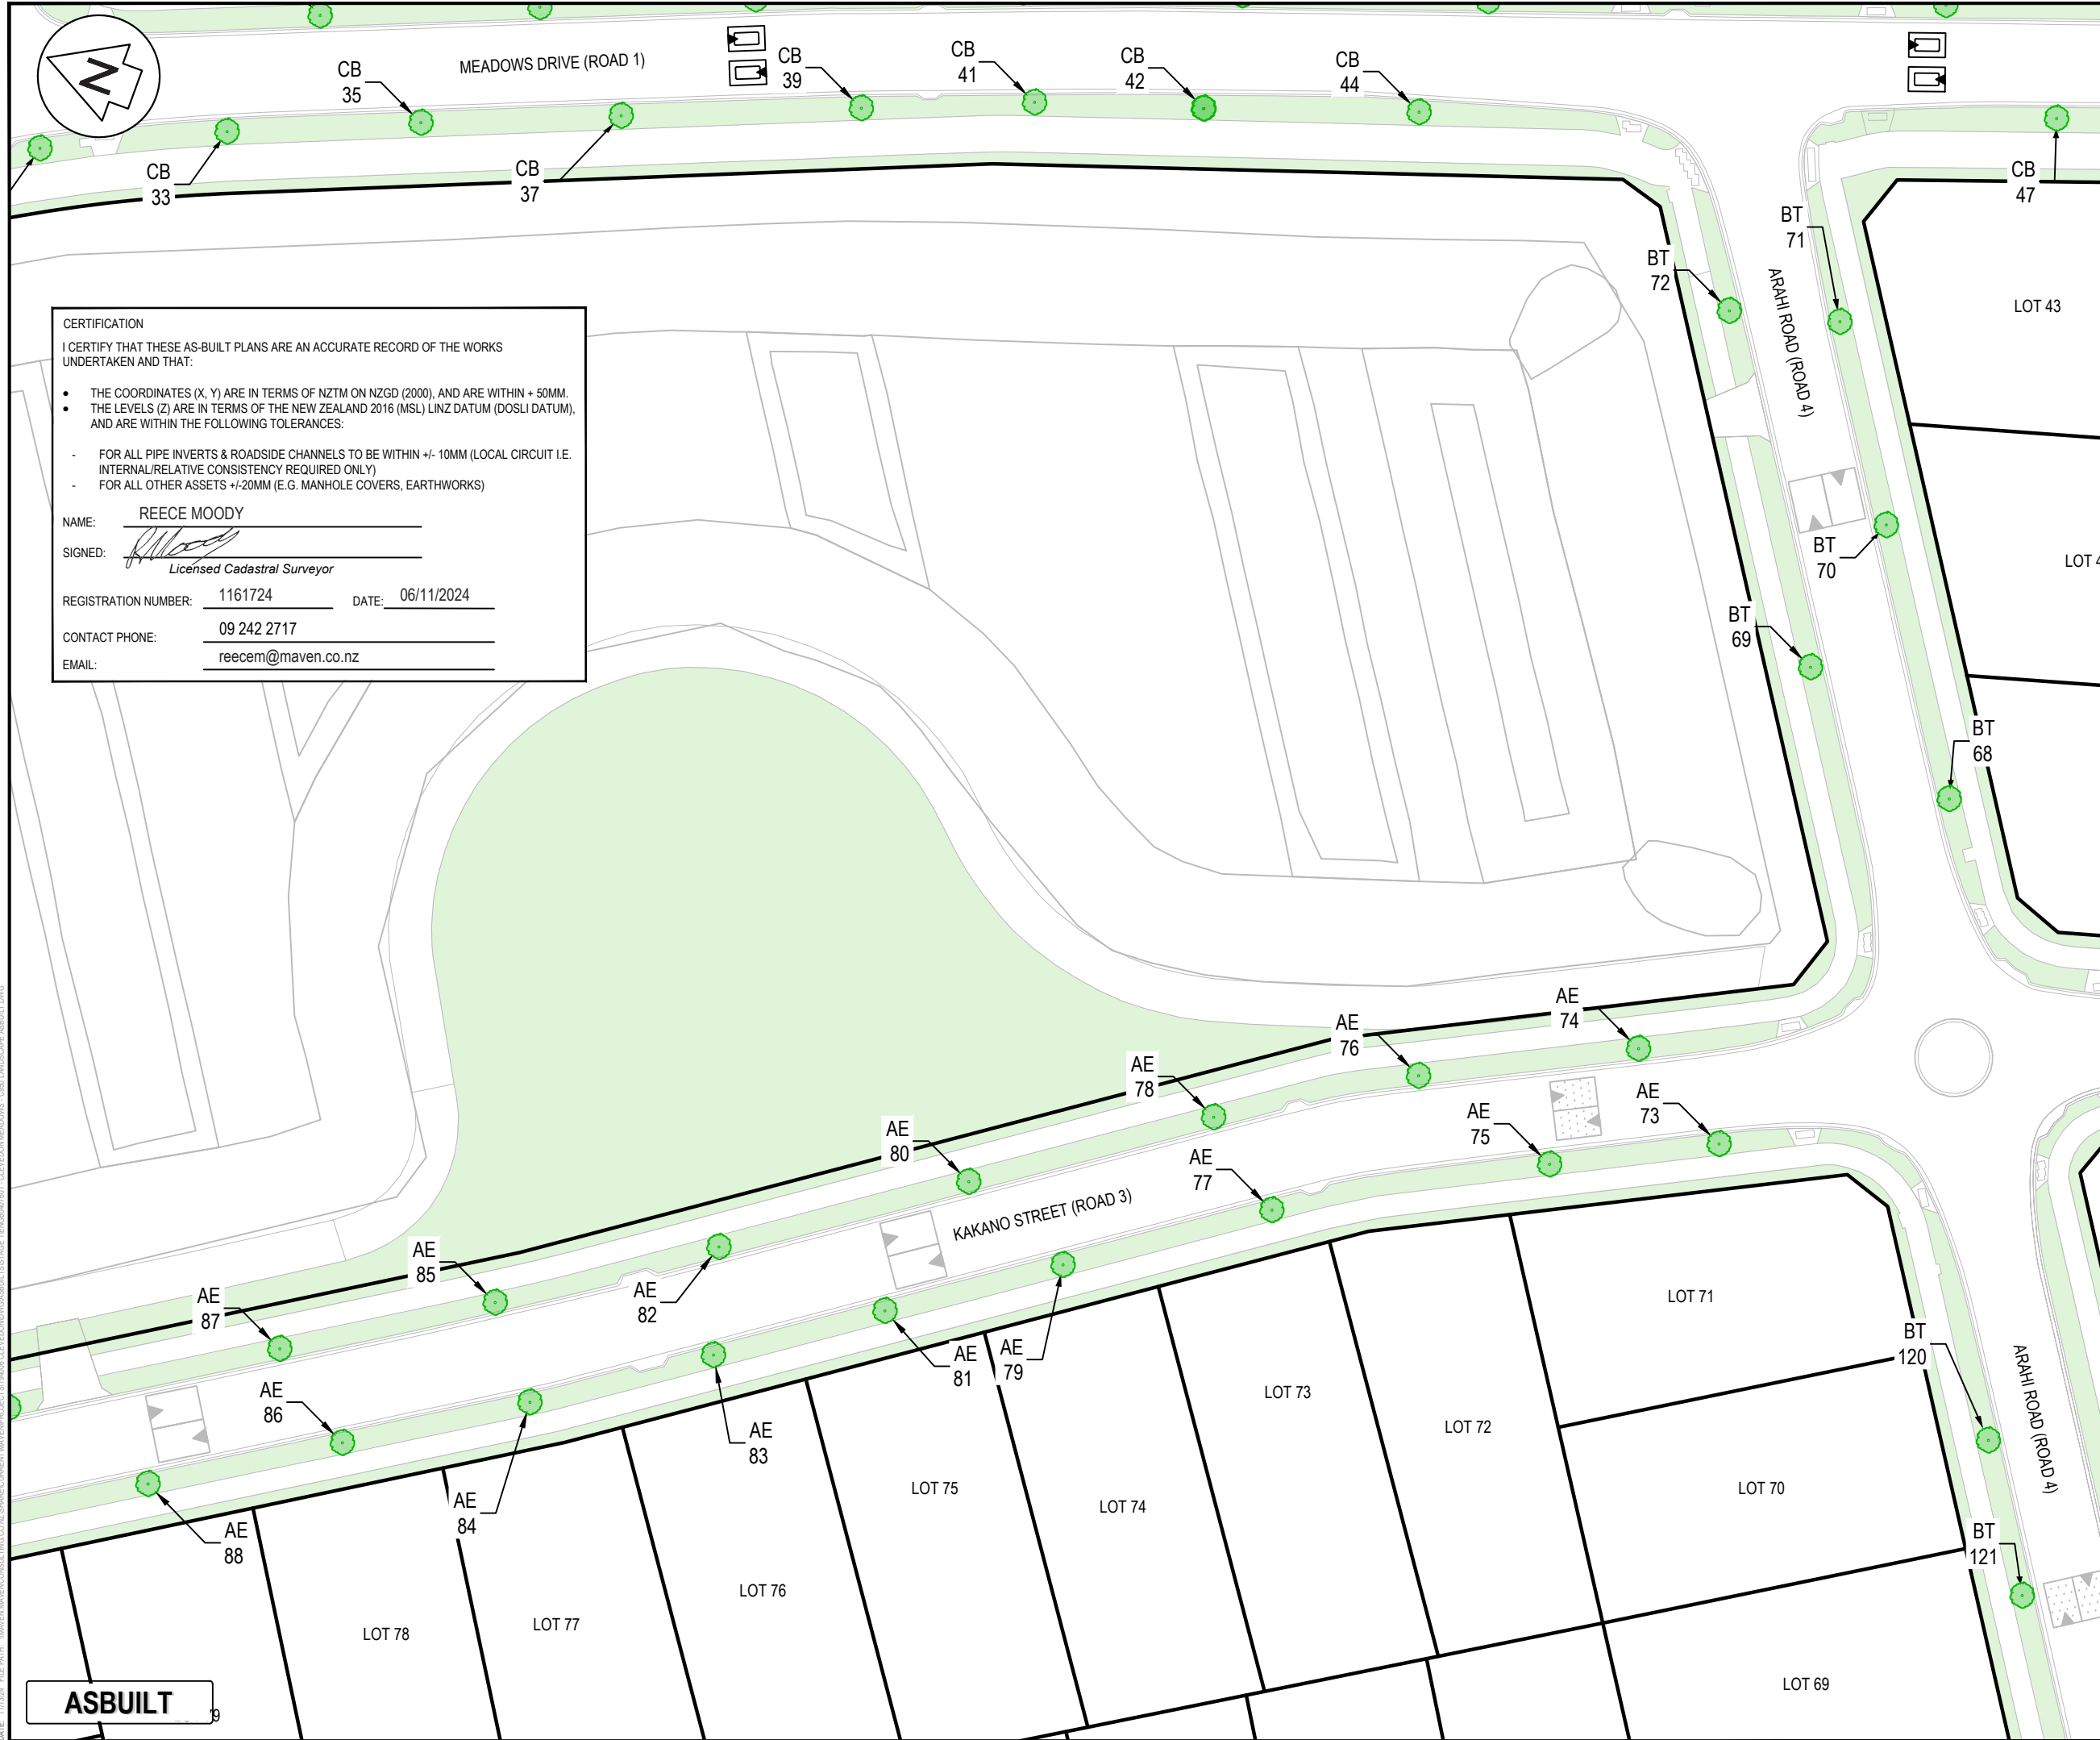

CERTIFICATION

I CERTIFY THAT THESE AS-BUILT PLANS ARE AN ACCURATE RECORD OF THE WORKS UNDERTAKEN AND THAT:

- THE COORDINATES (X, Y) ARE IN TERMS OF NZTM ON NZGD (2000), AND ARE WITHIN + 50MM.
- THE LEVELS (Z) ARE IN TERMS OF THE NEW ZEALAND 2016 (MSL) LINZ DATUM (DOSLI DATUM), AND ARE WITHIN THE FOLLOWING TOLERANCES:

- FOR ALL PIPE INVERTS & ROADSIDE CHANNELS TO BE WITHIN +/- 10MM (LOCAL CIRCUIT I.E. INTERNAL/RELATIVE CONSISTENCY REQUIRED ONLY)
- FOR ALL OTHER ASSETS +/-20MM (E.G. MANHOLE COVERS, EARTHWORKS)

NAME: REECE MOODY

SIGNED: *[Signature]*  
Licensed Cadastral Surveyor

REGISTRATION NUMBER: 1161724 DATE: 06/11/2024

CONTACT PHONE: 09 242 2717

EMAIL: reecem@maven.co.nz

- NOTES
- ALL WORKS TO BE IN ACCORDANCE WITH AUCKLAND COUNCIL STANDARDS.
  - COORDINATES IN TERMS OF NEW ZEALAND TRANSVERSE MERCATOR 2000 (NZTM 2000).
  - LEVELS IN TERMS OF NEW ZEALAND VERTICAL DATUM 2016 (NZVD2016).  
ORIGIN OF LEVELS = RM 5846 SO 58211
  - PUBLISHED RL=10.309, SOURCED FROM THE LINZ DIGITAL GEODETIC DATABASE.BOTANICAL SPECIES NAMES/ COMMON NAMES ARE:  
CB: CARPINUS BETULUS 'FASTIGIATA' / UPRIGHT EUROPEAN HORNBEAM  
DS: DYSOXYLUM SPECTABILE / KOHEKOHE  
AE: ALECTRYON EXCELSUS / TITOKI  
BT: BEILSCHMIEDIA TARAIRE / TARAIRE  
VL: VITEX LUCENS / PURIRI  
EU: EUGENIA VENTENATI / LILLY PILLY

Legend

- EX BDY
- AB BDY
- - - STAGE BDY
- AB TREES
- AB BERM

|         |              |         |         |
|---------|--------------|---------|---------|
|         |              |         |         |
|         |              |         |         |
|         |              |         |         |
| A       | ASBUILT      | ML      | 10/2024 |
| Rev     | Description  | By      | Date    |
|         |              | By      | Date    |
| Survey  | DEMPSEY WOOD | 08/2024 |         |
| Design  | ML           | 08/2024 |         |
| Drawn   | ML           | 09/2024 |         |
| Checked | JD           | 08/2024 |         |

**M** **Maven Associates**  
09 571 0050  
info@maven.co.nz  
www.maven.co.nz  
5 Owens Road, Epsom  
Auckland 1023

Project  
**62, 78 AND 80 PAKAPURA -  
CLEVEDON ROAD,  
CLEVEDON, AUCKLAND  
FOR CLEVEDON  
PROPERTIES LTD**

Title  
**ENG60407601 STAGE 1  
LANDSCAPE ASBUILT  
PLAN**

|             |                                                             |
|-------------|-------------------------------------------------------------|
| Project no. | 194006                                                      |
| Scale       | 1:500 @ A3                                                  |
| Cad file    | ENG60407601 - CLEVEDON MEADOWS - C950 LANDSCAPE ASBUILT.DWG |
| Drawing no. | STG_1 C954                                                  |
| Rev         | <b>A</b>                                                    |

DATE: 11/13/24 FILE PATH: \\MAVEN\MAVEN\CONSULTING\CO\NZSHARED\CURRENT\WATER\PROJECTS\194006\CLEVEDON MEADOWS - C950 LANDSCAPE ASBUILT.DWG

ASBUILT

DATE: 11/13/24 FILE PATH: \\MAVEN\MAVENCONSULTING\CO\2\SHARECURRENT\WATER\PROJECTS\194006\CLEVEDON MEADOWS - C950 LANDSCAPE ASBUILT.DWG



CERTIFICATION  
I CERTIFY THAT THESE AS-BUILT PLANS ARE AN ACCURATE RECORD OF THE WORKS UNDERTAKEN AND THAT:

- THE COORDINATES (X, Y) ARE IN TERMS OF NZTM ON NZGD (2000), AND ARE WITHIN + 50MM.
- THE LEVELS (Z) ARE IN TERMS OF THE NEW ZEALAND 2016 (MSL) LINZ DATUM (DOSLI DATUM), AND ARE WITHIN THE FOLLOWING TOLERANCES:
  - FOR ALL PIPE INVERTS & ROADSIDE CHANNELS TO BE WITHIN +/- 10MM (LOCAL CIRCUIT I.E. INTERNAL/RELATIVE CONSISTENCY REQUIRED ONLY)
  - FOR ALL OTHER ASSETS +/-20MM (E.G. MANHOLE COVERS, EARTHWORKS)

NAME: REECE MOODY  
SIGNED: *[Signature]*  
Registration Number: 1161724 DATE: 06/11/2024  
CONTACT PHONE: 09 242 2717  
EMAIL: reecem@maven.co.nz

- NOTES
1. ALL WORKS TO BE IN ACCORDANCE WITH AUCKLAND COUNCIL STANDARDS.
  2. COORDINATES IN TERMS OF NEW ZEALAND TRANSVERSE MERCATOR 2000 (NZTM 2000).
  3. LEVELS IN TERMS OF NEW ZEALAND VERTICAL DATUM 2016 (NZVD2016).  
ORIGIN OF LEVELS = RM 5846 SO 58211
  4. PUBLISHED RL=10.309, SOURCED FROM THE LINZ DIGITAL GEODETIC DATABASE.BOTANICAL SPECIES NAMES/ COMMON NAMES ARE:  
CB: CARPINUS BETULUS 'FASTIGIATA' / UPRIGHT EUROPEAN HORNBEAM  
DS: DYSOXYLUM SPECTABILE / KOHEKOHE  
AE: ALECTRYON EXCELSUS / TITOKI  
BT: BEILSCHMIEDIA TARAIRE / TARAIRE  
VL: VITEX LUCENS / PURIRI  
EU: EUGENIA VENTENATI / LILLY PILLY

Legend

- EX BDY
- AB BDY
- - - STAGE BDY
- AB TREES
- AB BERM

|         |              |         |         |
|---------|--------------|---------|---------|
| A       | ASBUILT      | ML      | 10/2024 |
| Rev     | Description  | By      | Date    |
|         | By           | Date    |         |
| Survey  | DEMPSEY WOOD | 08/2024 |         |
| Design  | ML           | 08/2024 |         |
| Drawn   | ML           | 09/2024 |         |
| Checked | JD           | 08/2024 |         |

**M** **Maven Associates**  
09 571 0050  
info@maven.co.nz  
www.maven.co.nz  
5 Owens Road, Epsom  
Auckland 1023


Project  
**62, 78 AND 80 PAPAKURA -  
CLEVEDON ROAD,  
CLEVEDON, AUCKLAND  
FOR CLEVEDON  
PROPERTIES LTD**

Title  
**ENG60407601 STAGE 1  
LANDSCAPE ASBUILT  
PLAN**

|             |                                                             |
|-------------|-------------------------------------------------------------|
| Project no. | 194006                                                      |
| Scale       | 1:500 @ A3                                                  |
| Cad file    | ENG60407601 - CLEVEDON MEADOWS - C950 LANDSCAPE ASBUILT.DWG |
| Drawing no. | STG_1 C955                                                  |
| Rev         | <b>A</b>                                                    |

ASBUILT

DATE: 11/13/24 FILE PATH: \\MAVEN\MAVENCONSULTING\WORKS\CURRENT\PROJECTS\19406 CLEVEDON MEADOWS - C950 LANDSCAPE ASBUILT.DWG

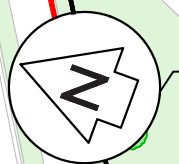

TR  
155

AE  
156

VL  
92

VL  
93

VL  
94

VL  
95

VL  
97

VL  
99

VL  
101

VL  
102

VL  
104

VL  
103

VL  
105

VL  
106

VL  
108

AE  
112

VL  
110

VL  
109

VL  
107

LOT 91

LOT 92

LOT 93

LOT 89

LOT 90

VL  
100

LOT 82

VL  
98

LOT 81

VL  
96

LOT 79

AE  
88

LOT 78

LOT 77

LOT 76

LOT 75

LOT 74

LOT 98

LOT 97

LOT 96

LOT 95

LOT 94

LOT 83

VL  
100

VL  
98

VL  
96

VL  
94

VL  
93

VL  
92

AE  
156

AE  
91

AE  
89

AE  
90

AE  
88

AE  
84

AE  
83

AE  
81

AE  
79

KAKANO STREET (ROAD 3)

KAKANO STREET (ROAD 3)

MAU MAI ROAD (ROAD 5)

- NOTES
1. ALL WORKS TO BE IN ACCORDANCE WITH AUCKLAND COUNCIL STANDARDS.
  2. COORDINATES IN TERMS OF NEW ZEALAND TRANSVERSE MERCATOR 2000 (NZTM 2000).
  3. LEVELS IN TERMS OF NEW ZEALAND VERTICAL DATUM 2016 (NZVD2016).  
ORIGIN OF LEVELS = RM 5846 SO 58211
  4. PUBLISHED RL=10.309, SOURCED FROM THE LINZ DIGITAL GEODETIC DATABASE. BOTANICAL SPECIES NAMES/ COMMON NAMES ARE:  
CB: CARPINUS BETULUS 'FASTIGIATA' / UPRIGHT EUROPEAN HORNBEAM  
DS: DYSOXYLUM SPECTABILE / KOHEKOHE  
AE: ALECTRYON EXCELSUS / TITOKI  
BT: BEILSCHMIEDIA TARAIRE / TARAIRE  
VL: VITEX LUCENS / PURIRI  
EU: EUGENIA VENTENATI / LILLY PILLY

| Legend |           |  |  |
|--------|-----------|--|--|
| ---    | EX BDY    |  |  |
| ---    | AB BDY    |  |  |
| ---    | STAGE BDY |  |  |
| ●      | AB TREES  |  |  |
| ---    | AB BERM   |  |  |

|         |              |         |         |
|---------|--------------|---------|---------|
| A       | ASBUILT      | ML      | 10/2024 |
| Rev     | Description  | By      | Date    |
|         | By           | Date    |         |
| Survey  | DEMPSEY WOOD | 08/2024 |         |
| Design  | ML           | 08/2024 |         |
| Drawn   | ML           | 09/2024 |         |
| Checked | JD           | 08/2024 |         |

**M** **MAVEN**  
Maven Associates  
09 571 0050  
info@maven.co.nz  
www.maven.co.nz  
5 Owens Road, Epsom  
Auckland 1023

Project  
**62, 78 AND 80 PAPAKURA -  
CLEVEDON ROAD,  
CLEVEDON, AUCKLAND  
FOR CLEVEDON  
PROPERTIES LTD**

Title  
**ENG60407601 STAGE 1  
LANDSCAPE ASBUILT  
PLAN**

|             |                                                             |
|-------------|-------------------------------------------------------------|
| Project no. | 194006                                                      |
| Scale       | 1:500 @ A3                                                  |
| Cad file    | ENG60407601 - CLEVEDON MEADOWS - C950 LANDSCAPE ASBUILT.DWG |
| Drawing no. | STG_1 C956                                                  |
| Rev         | <b>A</b>                                                    |

CERTIFICATION

I CERTIFY THAT THESE AS-BUILT PLANS ARE AN ACCURATE RECORD OF THE WORKS UNDERTAKEN AND THAT:

- THE COORDINATES (X, Y) ARE IN TERMS OF NZTM ON NZGD (2000), AND ARE WITHIN + 50MM.
- THE LEVELS (Z) ARE IN TERMS OF THE NEW ZEALAND 2016 (MSL) LINZ DATUM (DOSLI DATUM), AND ARE WITHIN THE FOLLOWING TOLERANCES:

- FOR ALL PIPE INVERTS & ROADSIDE CHANNELS TO BE WITHIN +/- 10MM (LOCAL CIRCUIT I.E. INTERNAL/RELATIVE CONSISTENCY REQUIRED ONLY)
- FOR ALL OTHER ASSETS +/-20MM (E.G. MANHOLE COVERS, EARTHWORKS)

NAME: REECE MOODY

SIGNED:

REGISTRATION NUMBER: 1161724 DATE: 06/11/2024

CONTACT PHONE: 09 242 2717

EMAIL: reecem@maven.co.nz

ASBUILT



- NOTES
1. ALL WORKS TO BE IN ACCORDANCE WITH AUCKLAND COUNCIL STANDARDS.
  2. COORDINATES IN TERMS OF NEW ZEALAND TRANSVERSE MERCATOR 2000 (NZTM 2000).
  3. LEVELS IN TERMS OF NEW ZEALAND VERTICAL DATUM 2016 (NZVD2016).  
ORIGIN OF LEVELS = RM 5846 SO 58211
  4. PUBLISHED RL=10.309, SOURCED FROM THE LINZ DIGITAL GEODETIC DATABASE. BOTANICAL SPECIES NAMES/ COMMON NAMES ARE:  
CB: CARPINUS BETULUS 'FASTIGIATA' / UPRIGHT EUROPEAN HORNBEAM  
DS: DYSOXYLUM SPECTABILE / KOHEKOHE  
AE: ALECTRYON EXCELSUS / TITOKI  
BT: BEILSCHMIEDIA TARAIRE / TARAIRE  
VL: VITEX LUCENS / PURIRI  
EU: EUGENIA VENTENATI / LILLY PILLY

Legend

- EX BDY
- AB BDY
- - - STAGE BDY
- AB TREES
- AB BERM

|         |              |         |         |
|---------|--------------|---------|---------|
|         |              |         |         |
|         |              |         |         |
| A       | ASBUILT      | ML      | 10/2024 |
| Rev     | Description  | By      | Date    |
|         | By           | Date    |         |
| Survey  | DEMPSEY WOOD | 08/2024 |         |
| Design  | ML           | 08/2024 |         |
| Drawn   | ML           | 09/2024 |         |
| Checked | JD           | 08/2024 |         |

**Maven Associates**  
09 571 0050  
info@maven.co.nz  
www.maven.co.nz  
5 Owens Road, Epsom  
Auckland 1023

Project  
**62, 78 AND 80 PAKAPURA -  
CLEVEDON ROAD,  
CLEVEDON, AUCKLAND  
FOR CLEVEDON  
PROPERTIES LTD**

Title  
**ENG60407601 STAGE 1  
LANDSCAPE ASBUILT  
PLAN**

|             |                                                             |
|-------------|-------------------------------------------------------------|
| Project no. | 194006                                                      |
| Scale       | 1:500 @ A3                                                  |
| Cad file    | ENG60407601 - CLEVEDON MEADOWS - C950 LANDSCAPE ASBUILT.DWG |
| Drawing no. | STG_1 C957                                                  |
| Rev         | <b>A</b>                                                    |

CERTIFICATION

I CERTIFY THAT THESE AS-BUILT PLANS ARE AN ACCURATE RECORD OF THE WORKS UNDERTAKEN AND THAT:

- THE COORDINATES (X, Y) ARE IN TERMS OF NZTM ON NZGD (2000), AND ARE WITHIN + 50MM.
- THE LEVELS (Z) ARE IN TERMS OF THE NEW ZEALAND 2016 (MSL) LINZ DATUM (DOSLI DATUM), AND ARE WITHIN THE FOLLOWING TOLERANCES:

- FOR ALL PIPE INVERTS & ROADSIDE CHANNELS TO BE WITHIN +/- 10MM (LOCAL CIRCUIT I.E. INTERNAL/RELATIVE CONSISTENCY REQUIRED ONLY)
- FOR ALL OTHER ASSETS +/-20MM (E.G. MANHOLE COVERS, EARTHWORKS)

NAME: REECE MOODY

SIGNED: Licensed Cadastral Surveyor

REGISTRATION NUMBER: 1161724 DATE: 06/11/2024

CONTACT PHONE: 09 242 2717

EMAIL: reecem@maven.co.nz

DATE: 11/10/24 FILE PATH: \\MAVEN\MAVEN\CONSULTING\CO-NO\S\ASBUILT\PROJECTS\194006\CLEVEDON MEADOWS - C950 LANDSCAPE ASBUILT.DWG



- NOTES
1. ALL WORKS TO BE IN ACCORDANCE WITH AUCKLAND COUNCIL STANDARDS.
  2. COORDINATES IN TERMS OF NEW ZEALAND TRANSVERSE MERCATOR 2000 (NZTM 2000).
  3. LEVELS IN TERMS OF NEW ZEALAND VERTICAL DATUM 2016 (NZVD2016).  
ORIGIN OF LEVELS = RM 5846 SO 58211
  4. PUBLISHED RL=10.309, SOURCED FROM THE LINZ DIGITAL GEODETIC DATABASE. BOTANICAL SPECIES NAMES/ COMMON NAMES ARE:  
CB: CARPINUS BETULUS 'FASTIGIATA' / UPRIGHT EUROPEAN HORNBEAM  
DS: DYSOXYLUM SPECTABILE / KOHEKOHE  
AE: ALECTRYON EXCELSUS / TITOKI  
BT: BEILSCHMIEDIA TARAIRE / TARAIRE  
VL: VITEX LUCENS / PURIRI  
EU: EUGENIA VENTENATI / LILLY PILLY

Legend

- EX BDY
- AB BDY
- - - STAGE BDY
- AB TREES
- AB BERM

|         |              |         |         |
|---------|--------------|---------|---------|
|         |              |         |         |
|         |              |         |         |
|         |              |         |         |
| A       | ASBUILT      | ML      | 10/2024 |
| Rev     | Description  | By      | Date    |
|         |              | By      | Date    |
| Survey  | DEMPSEY WOOD | 08/2024 |         |
| Design  | ML           | 08/2024 |         |
| Drawn   | ML           | 09/2024 |         |
| Checked | JD           | 08/2024 |         |

**M** **Maven Associates**  
09 571 0050  
info@maven.co.nz  
www.maven.co.nz  
5 Owens Road, Epsom  
Auckland 1023

Project  
**62, 78 AND 80 PAPAURA -  
CLEVEDON ROAD,  
CLEVEDON, AUCKLAND  
FOR CLEVEDON  
PROPERTIES LTD**

Title  
**ENG60407601 STAGE 1  
LANDSCAPE ASBUILT  
PLAN**


|             |                                                             |
|-------------|-------------------------------------------------------------|
| Project no. | 194006                                                      |
| Scale       | 1:500 @ A3                                                  |
| Cad file    | ENG60407601 - CLEVEDON MEADOWS - C950 LANDSCAPE ASBUILT.DWG |
| Drawing no. | STG_1 C958                                                  |
| Rev         | <b>A</b>                                                    |

CERTIFICATION  
I CERTIFY THAT THESE AS-BUILT PLANS ARE AN ACCURATE RECORD OF THE WORKS UNDERTAKEN AND THAT:

- THE COORDINATES (X, Y) ARE IN TERMS OF NZTM ON NZGD (2000), AND ARE WITHIN + 50MM.
- THE LEVELS (Z) ARE IN TERMS OF THE NEW ZEALAND 2016 (MSL) LINZ DATUM (DOSLI DATUM), AND ARE WITHIN THE FOLLOWING TOLERANCES:
  - FOR ALL PIPE INVERTS & ROADSIDE CHANNELS TO BE WITHIN +/- 10MM (LOCAL CIRCUIT I.E. INTERNAL/RELATIVE CONSISTENCY REQUIRED ONLY)
  - FOR ALL OTHER ASSETS +/-20MM (E.G. MANHOLE COVERS, EARTHWORKS)

NAME: REECE MOODY  
SIGNED: *Reece Moody*  
Registration Number: 1161724 DATE: 06/11/2024  
CONTACT PHONE: 09 242 2717  
EMAIL: reecem@maven.co.nz

DATE: 11/13/24 FILE PATH: \\MVEN\MVENCONSULTING\CO\2024\CURRENT\WAVE\PROJECTS\194006\CLEVEDON MEADOWS - C950 LANDSCAPE ASBUILT.DWG

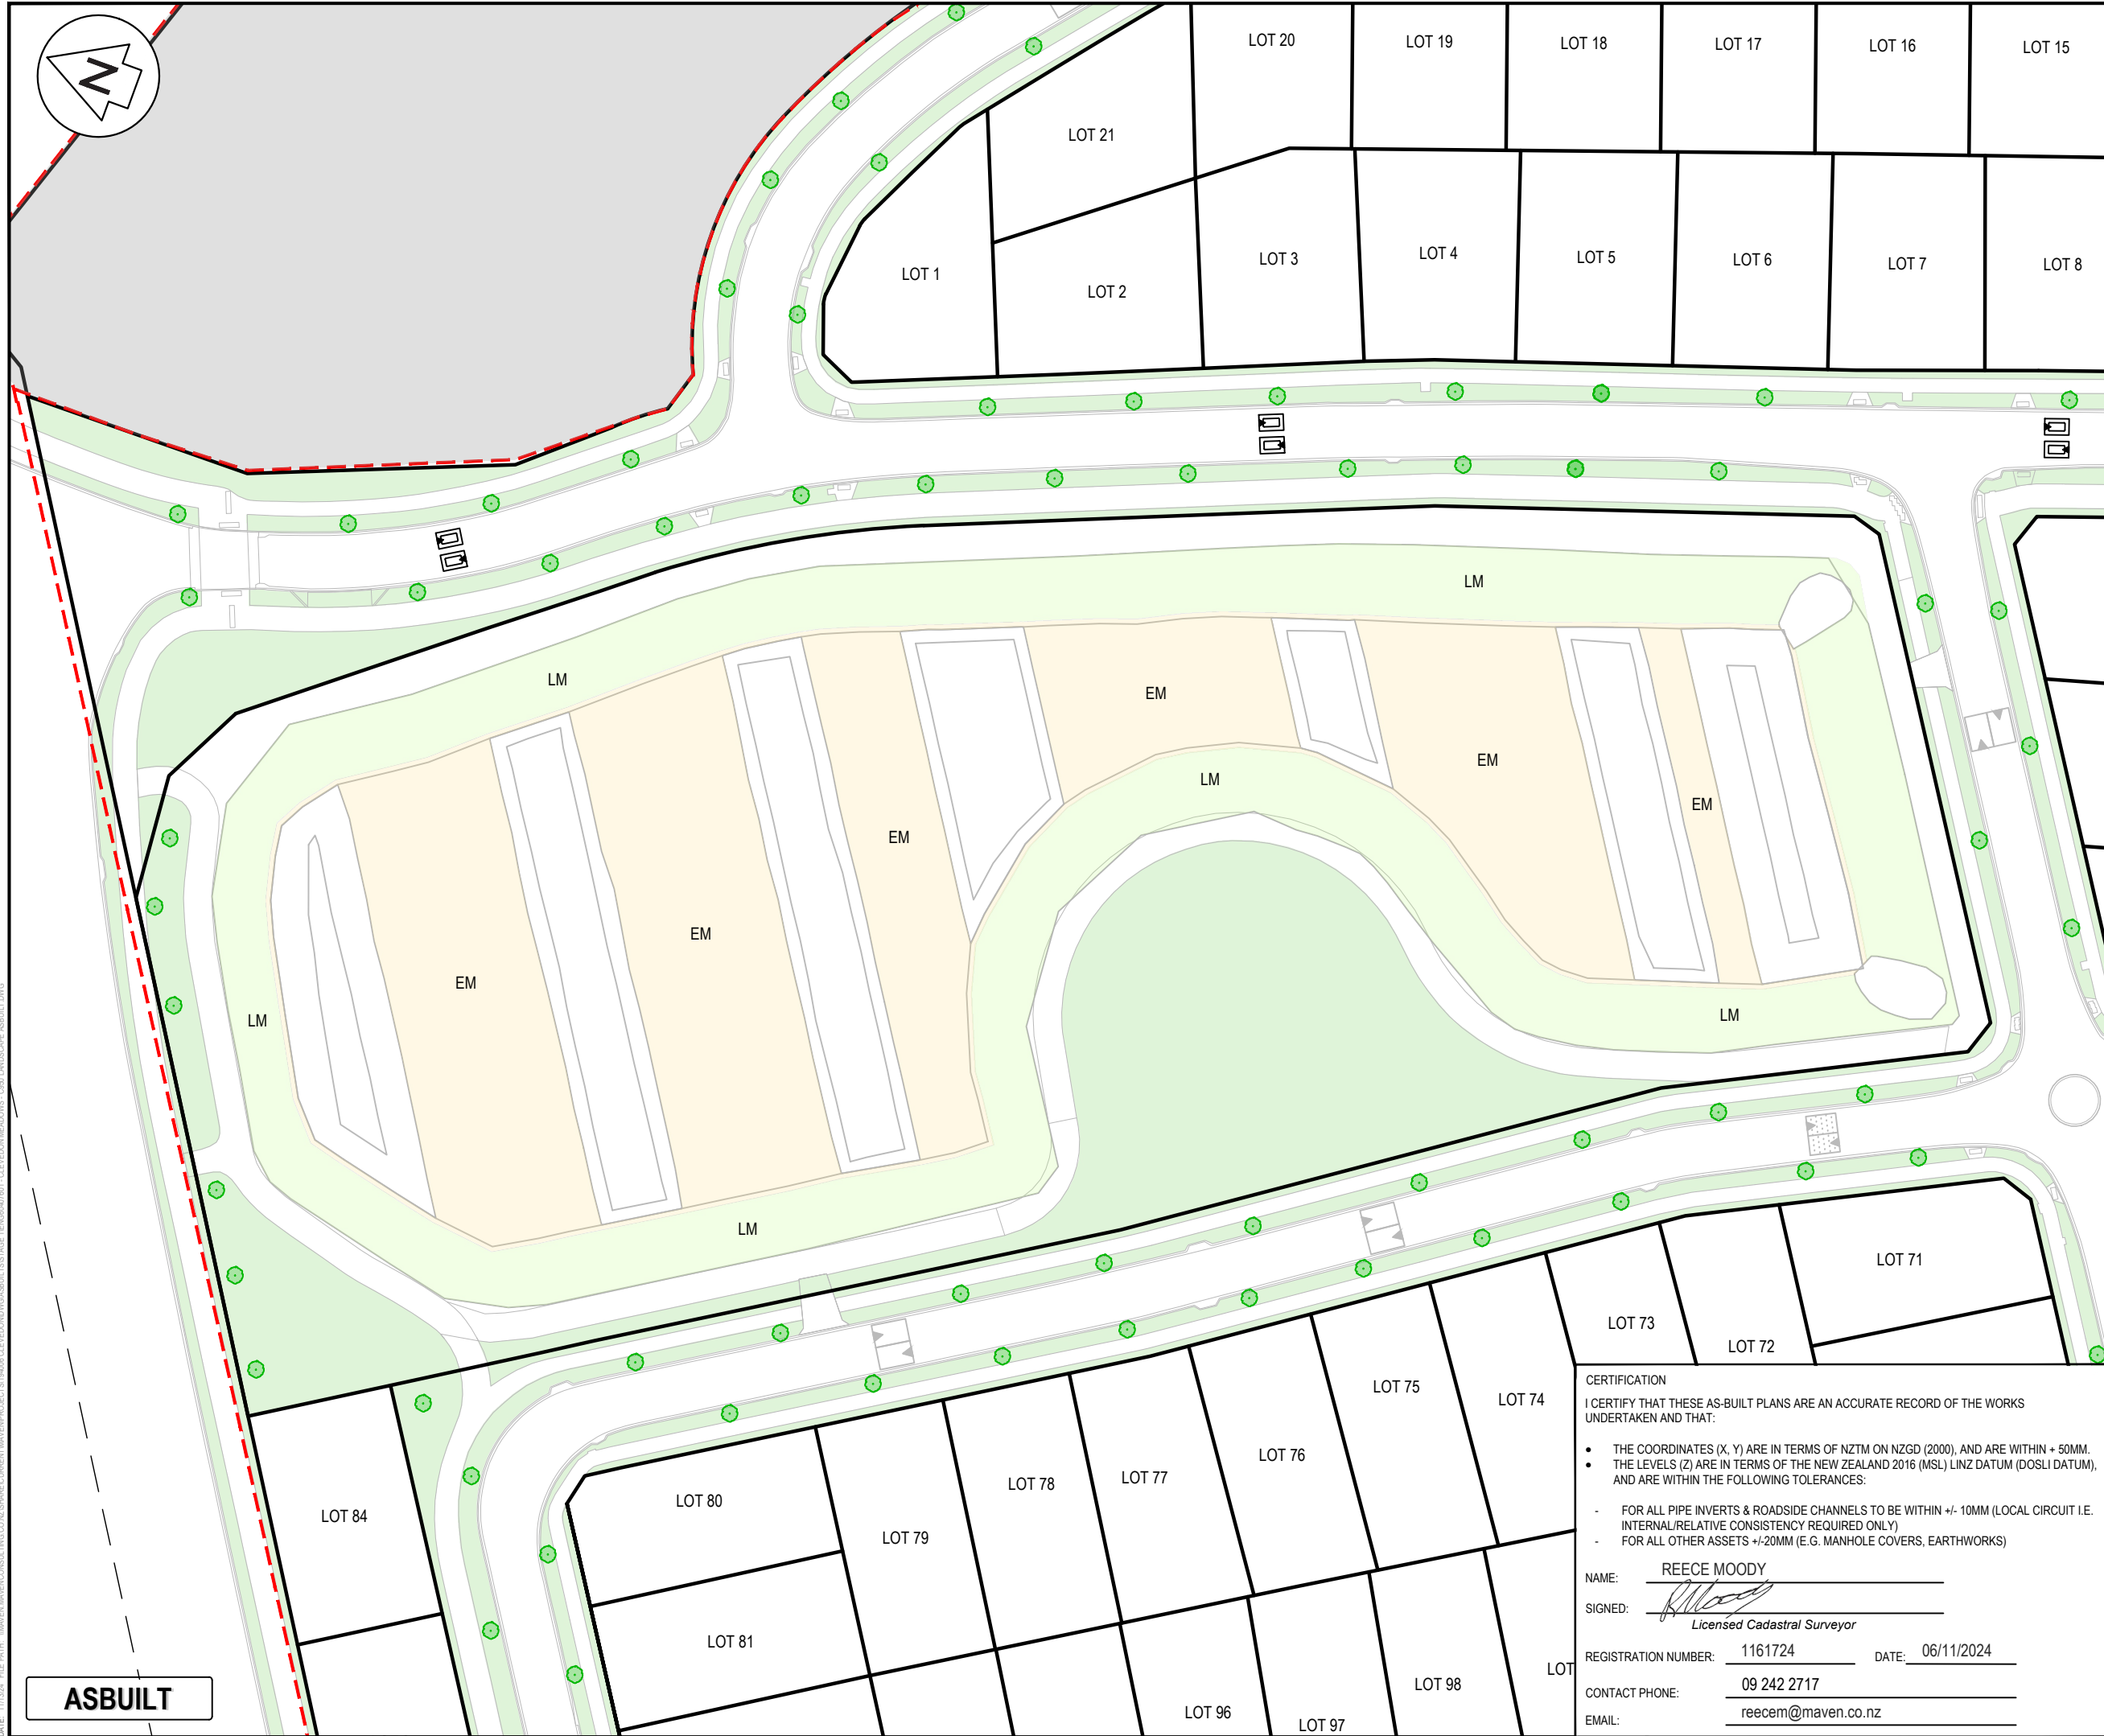

NOTES

- ALL WORKS TO BE IN ACCORDANCE WITH AUCKLAND COUNCIL STANDARDS.
- COORDINATES IN TERMS OF NEW ZEALAND TRANSVERSE MERCATOR 2000 (NZTM 2000).
- LEVELS IN TERMS OF NEW ZEALAND VERTICAL DATUM 2016 (NZVD2016).  
ORIGIN OF LEVELS = RM 5846 SO 58211
- PUBLISHED RL=10.309, SOURCED FROM THE LINZ DIGITAL GEODETIC DATABASE. BOTANICAL SPECIES NAMES/ COMMON NAMES ARE:  
CB: CARPINUS BETULUS 'FASTIGIATA' / UPRIGHT EUROPEAN HORNBEAM  
DS: DYSOXYLUM SPECTABILE / KOHEKOHE  
AE: ALECTRYON EXCELSUS / TITOKI  
BT: BEILSCHMIEDIA TARAIRE / TARAIRE  
VL: VITEX LUCENS / PURIRI  
EU: EUGENIA VENTENATI / LILLY PILLY

Legend

- EX BDY
- AB BDY
- STAGE BDY
- AB TREES
- AB BERM
- AB Wetland Emergent Zone Planting Mix (EM)
  - 25% Eleocharis acuta
  - 25% Machaerina rubiginosa
  - 25% Machaerina teretifolia
  - 25% Bolboschoenus fluviatilis
- AB Wetland Littoral Zone Planting Mix (LM)
  - 30% Carex virgata
  - 15% Machaerina juncea
  - 15% Juncus pallidus
  - 15% Carex secta
  - 15% Phormium tenax
  - 10% Cyperus ustulatus

|         |              |    |         |
|---------|--------------|----|---------|
|         |              |    |         |
|         |              |    |         |
|         |              |    |         |
| A       | ASBUILT      | ML | 10/2024 |
| Rev     | Description  | By | Date    |
|         |              | By | Date    |
| Survey  | DEMPSEY WOOD |    | 08/2024 |
| Design  | ML           |    | 08/2024 |
| Drawn   | ML           |    | 09/2024 |
| Checked | JD           |    | 08/2024 |

**Maven Associates**  
09 571 0050  
info@maven.co.nz  
www.maven.co.nz  
5 Owens Road, Epsom  
Auckland 1023

Project

**62, 78 AND 80 PAPAKURA - CLEVEDON ROAD, CLEVEDON, AUCKLAND FOR CLEVEDON PROPERTIES LTD**

Title

**ENG60407601 STAGE 1 WETLAND LANDSCAPE ASBUILT PLAN**

|             |                                                             |
|-------------|-------------------------------------------------------------|
| Project no. | 194006                                                      |
| Scale       | 1:750 @ A3                                                  |
| Cad file    | ENG60407601 - CLEVEDON MEADOWS - C950 LANDSCAPE ASBUILT.DWG |
| Drawing no. | STG_1 C959                                                  |
| Rev         | <b>A</b>                                                    |

CERTIFICATION

I CERTIFY THAT THESE AS-BUILT PLANS ARE AN ACCURATE RECORD OF THE WORKS UNDERTAKEN AND THAT:

- THE COORDINATES (X, Y) ARE IN TERMS OF NZTM ON NZGD (2000), AND ARE WITHIN + 50MM.
- THE LEVELS (Z) ARE IN TERMS OF THE NEW ZEALAND 2016 (MSL) LINZ DATUM (DOSLI DATUM), AND ARE WITHIN THE FOLLOWING TOLERANCES:

- FOR ALL PIPE INVERTS & ROADSIDE CHANNELS TO BE WITHIN +/- 10MM (LOCAL CIRCUIT I.E. INTERNAL/RELATIVE CONSISTENCY REQUIRED ONLY)
- FOR ALL OTHER ASSETS +/-20MM (E.G. MANHOLE COVERS, EARTHWORKS)

NAME: REECE MOODY

SIGNED:

Licensed Cadastral Surveyor

REGISTRATION NUMBER: 1161724 DATE: 06/11/2024

CONTACT PHONE: 09 242 2717

EMAIL: reecem@maven.co.nz

ASBUILT

DATE: 11/13/24 FILE PATH: \\MAVEN\MAVENCONSULTING\CO\NZSHARED\CURRENT\WATER\PROJECTS\194006\CLEVEDON MEADOWS - C950 LANDSCAPE ASBUILT.DWG

DATE: 11/13/24 FILE PATH: \\MAVEN\MAVENCONSULTING\CO\_NZSHARED\PROJECTS\19406\_CLEVEDON\ASBUILT\STAGE\_1\ENG60407601 - CLEVEDON MEADOWS - C950 LANDSCAPE ASBUILT.DWG

| TABLE OF CO-ORDINATES (NZTM) |              |              |                |
|------------------------------|--------------|--------------|----------------|
| Street Tree #                | Northing     | Easting      | BOTANICAL NAME |
|                              | mN           | mE           |                |
|                              | mN           | mE           |                |
| 1                            | 5903365.10mN | 1781144.52mE | DS             |
| 2                            | 5903355.83mN | 1781144.48mE | DS             |
| 3                            | 5903364.66mN | 1781158.94mE | DS             |
| 4                            | 5903359.82mN | 1781171.06mE | DS             |
| 5                            | 5903352.80mN | 1781165.54mE | DS             |
| 6                            | 5903350.19mN | 1781186.21mE | DS             |
| 7                            | 5903339.80mN | 1781185.53mE | DS             |
| 8                            | 5903335.66mN | 1781204.07mE | DS             |
| 9                            | 5903325.97mN | 1781215.59mE | DS             |
| 10                           | 5903319.84mN | 1781209.12mE | DS             |
| 11                           | 5903312.67mN | 1781223.50mE | DS             |
| 12                           | 5903300.32mN | 1781218.80mE | DS             |
| 13                           | 5903294.93mN | 1781229.77mE | DS             |
| 14                           | 5903283.44mN | 1781224.81mE | DS             |
| 15                           | 5903276.95mN | 1781236.18mE | DS             |
| 16                           | 5903259.14mN | 1781242.43mE | DS             |
| 17                           | 5903247.36mN | 1781237.45mE | DS             |
| 18                           | 5903240.95mN | 1781248.84mE | DS             |
| 19                           | 5903228.71mN | 1781244.14mE | DS             |
| 20                           | 5903224.03mN | 1781254.88mE | DS             |
| 21                           | 5903211.58mN | 1781250.21mE | DS             |
| 22                           | 5903207.16mN | 1781260.87mE | DS             |
| 23                           | 5903193.04mN | 1781256.83mE | DS             |
| 24                           | 5903190.00mN | 1781266.91mE | DS             |
| 25                           | 5903173.27mN | 1781272.75mE | DS             |
| 26                           | 5903159.49mN | 1781279.05mE | DS             |
| 27                           | 5903151.35mN | 1781260.62mE | DS             |
| 28                           | 5903157.53mN | 1781253.50mE | DS             |
| 29                           | 5903151.88mN | 1781243.32mE | DS             |
| 30                           | 5903142.89mN | 1781244.63mE | DS             |
| 31                           | 5903144.19mN | 1781229.05mE | DS             |

| TABLE OF CO-ORDINATES (NZTM) |              |              |                |
|------------------------------|--------------|--------------|----------------|
| Street Tree #                | Northing     | Easting      | BOTANICAL NAME |
| 32                           | 5903133.43mN | 1781226.93mE | DS             |
| 33                           | 5903333.82mN | 1781130.24mE | CB             |
| 34                           | 5903329.91mN | 1781141.80mE | CB             |
| 35                           | 5903319.13mN | 1781136.37mE | CB             |
| 36                           | 5903313.20mN | 1781148.62mE | CB             |
| 37                           | 5903303.88mN | 1781142.53mE | CB             |
| 38                           | 5903296.79mN | 1781155.28mE | CB             |
| 39                           | 5903285.58mN | 1781149.86mE | CB             |
| 40                           | 5903276.38mN | 1781163.33mE | CB             |
| 41                           | 5903272.39mN | 1781155.18mE | CB             |
| 42                           | 5903259.16mN | 1781159.46mE | CB             |
| 43                           | 5903259.40mN | 1781169.27mE | CB             |
| 44                           | 5903242.48mN | 1781165.23mE | CB             |
| 45                           | 5903240.27mN | 1781175.72mE | CB             |
| 46                           | 5903204.87mN | 1781188.29mE | CB             |
| 47                           | 5903193.15mN | 1781182.64mE | CB             |
| 48                           | 5903187.96mN | 1781194.02mE | CB             |
| 49                           | 5903179.11mN | 1781187.47mE | CB             |
| 50                           | 5903162.86mN | 1781193.07mE | CB             |
| 51                           | 5903152.13mN | 1781206.81mE | CB             |
| 52                           | 5903145.77mN | 1781199.08mE | CB             |
| 53                           | 5903110.98mN | 1781208.23mE | CB             |
| 54                           | 5903083.46mN | 1781201.68mE | BT             |
| 55                           | 5903076.00mN | 1781187.84mE | BT             |
| 56                           | 5903064.66mN | 1781186.92mE | BT             |
| 57                           | 5903067.90mN | 1781172.73mE | BT             |
| 58                           | 5903052.53mN | 1781164.97mE | BT             |
| 59                           | 5903077.43mN | 1781140.93mE | AE             |
| 60                           | 5903087.25mN | 1781129.62mE | AE             |
| 61                           | 5903095.87mN | 1781136.36mE | AE             |
| 62                           | 5903111.28mN | 1781132.39mE | AE             |
| 63                           | 5903116.40mN | 1781122.17mE | AE             |
| 64                           | 5903132.75mN | 1781117.76mE | AE             |
| 65                           | 5903141.32mN | 1781124.34mE | AE             |
| 66                           | 5903148.15mN | 1781113.56mE | AE             |
| 67                           | 5903155.70mN | 1781120.25mE | AE             |
| 68                           | 5903182.32mN | 1781127.21mE | BT             |
| 69                           | 5903196.71mN | 1781133.46mE | BT             |
| 70                           | 5903194.86mN | 1781146.54mE | BT             |
| 71                           | 5903204.15mN | 1781160.89mE | BT             |

| TABLE OF CO-ORDINATES (NZTM) |              |              |                |
|------------------------------|--------------|--------------|----------------|
| Street Tree #                | Northing     | Easting      | BOTANICAL NAME |
| 72                           | 5903212.98mN | 1781158.64mE | BT             |
| 73                           | 5903190.38mN | 1781094.15mE | AE             |
| 74                           | 5903199.26mN | 1781099.23mE | AE             |
| 75                           | 5903202.87mN | 1781087.82mE | AE             |
| 76                           | 5903215.46mN | 1781090.96mE | AE             |
| 77                           | 5903222.99mN | 1781076.49mE | AE             |
| 78                           | 5903230.09mN | 1781082.02mE | AE             |
| 79                           | 5903237.55mN | 1781066.41mE | AE             |
| 80                           | 5903247.16mN | 1781070.16mE | AE             |
| 81                           | 5903249.99mN | 1781057.87mE | AE             |
| 82                           | 5903264.58mN | 1781058.12mE | AE             |
| 83                           | 5903261.97mN | 1781049.64mE | AE             |
| 84                           | 5903274.79mN | 1781040.84mE | AE             |
| 85                           | 5903280.27mN | 1781047.55mE | AE             |
| 86                           | 5903288.11mN | 1781032.45mE | AE             |
| 87                           | 5903295.58mN | 1781037.93mE | AE             |
| 88                           | 5903301.94mN | 1781023.82mE | AE             |
| 89                           | 5903314.81mN | 1781025.77mE | AE             |
| 90                           | 5903317.30mN | 1781014.31mE | AE             |
| 91                           | 5903330.38mN | 1781016.27mE | AE             |
| 92                           | 5903353.23mN | 1781002.55mE | VL             |
| 93                           | 5903344.58mN | 1780996.15mE | VL             |
| 94                           | 5903332.41mN | 1780990.32mE | VL             |
| 95                           | 5903335.81mN | 1780979.07mE | VL             |
| 96                           | 5903324.21mN | 1780977.51mE | VL             |
| 97                           | 5903326.77mN | 1780964.77mE | VL             |
| 98                           | 5903315.50mN | 1780964.16mE | VL             |
| 99                           | 5903317.26mN | 1780950.23mE | VL             |
| 100                          | 5903306.79mN | 1780950.71mE | VL             |
| 101                          | 5903306.79mN | 1780937.76mE | VL             |
| 102                          | 5903287.09mN | 1780939.35mE | VL             |
| 103                          | 5903282.27mN | 1780952.59mE | VL             |
| 104                          | 5903269.34mN | 1780950.19mE | VL             |
| 105                          | 5903265.88mN | 1780962.67mE | VL             |
| 106                          | 5903249.74mN | 1780972.96mE | VL             |
| 107                          | 5903237.51mN | 1780969.59mE | VL             |
| 108                          | 5903234.52mN | 1780981.83mE | VL             |
| 109                          | 5903216.67mN | 1780955.64mE | VL             |
| 110                          | 5903210.49mN | 1780965.67mE | VL             |
| 111                          | 5903213.59mN | 1780993.75mE | AE             |

| TABLE OF CO-ORDINATES (NZTM) |              |              |                |
|------------------------------|--------------|--------------|----------------|
| Street Tree #                | Northing     | Easting      | BOTANICAL NAME |
| 112                          | 5903205.28mN | 1780988.79mE | AE             |
| 113                          | 5903197.43mN | 1781003.69mE | AE             |
| 114                          | 5903189.29mN | 1780998.66mE | AE             |
| 115                          | 5903185.48mN | 1781011.07mE | AE             |
| 116                          | 5903172.09mN | 1781009.22mE | AE             |
| 117                          | 5903169.98mN | 1781020.57mE | AE             |
| 118                          | 5903155.63mN | 1781019.11mE | AE             |
| 119                          | 5903154.74mN | 1781029.86mE | AE             |
| 120                          | 5903161.29mN | 1781078.88mE | BT             |
| 121                          | 5903154.33mN | 1781067.87mE | BT             |
| 122                          | 5903132.24mN | 1781049.68mE | BT             |
| 123                          | 5903118.88mN | 1781028.85mE | BT             |
| 124                          | 5903123.51mN | 1781018.71mE | BT             |
| 125                          | 5903108.94mN | 1781009.72mE | AE             |
| 126                          | 5903089.51mN | 1781024.83mE | AE             |
| 127                          | 5903077.47mN | 1781019.60mE | AE             |
| 128                          | 5903071.02mN | 1781030.56mE | AE             |
| 129                          | 5903056.19mN | 1781035.14mE | AE             |
| 130                          | 5903053.44mN | 1781027.02mE | AE             |
| 131                          | 5903039.15mN | 1781031.28mE | AE             |
| 132                          | 5903041.82mN | 1781039.59mE | AE             |
| 133                          | 5902987.98mN | 1781008.85mE | BT             |
| 134                          | 5902976.10mN | 1781005.10mE | BT             |
| 135                          | 5902980.59mN | 1781022.32mE | BT             |
| 136                          | 5903017.71mN | 1781079.48mE | BT             |
| 137                          | 5903014.66mN | 1781093.90mE | BT             |
| 138                          | 5903026.22mN | 1781095.51mE | BT             |
| 139                          | 5903024.41mN | 1781112.50mE | BT             |
| 140                          | 5903036.61mN | 1781114.61mE | BT             |
| 141                          | 5903036.79mN | 1781135.36mE | BT             |

CERTIFICATION

I CERTIFY THAT THESE AS-BUILT PLANS ARE AN ACCURATE RECORD OF THE WORKS UNDERTAKEN AND THAT:

- THE COORDINATES (X, Y) ARE IN TERMS OF NZTM ON NZGD (2000), AND ARE WITHIN + 50MM.
- THE LEVELS (Z) ARE IN TERMS OF THE NEW ZEALAND 2016 (MSL) LINZ DATUM (DOSLI DATUM), AND ARE WITHIN THE FOLLOWING TOLERANCES:

-

FOR ALL PIPE INVERTS & ROADSIDE CHANNELS TO BE WITHIN +/- 10MM (LOCAL CIRCUIT I.E. INTERNAL/RELATIVE CONSISTENCY REQUIRED ONLY)

-

FOR ALL OTHER ASSETS +/-20MM (E.G. MANHOLE COVERS, EARTHWORKS)

NAME: REECE MOODY

SIGNED: 

Licensed Cadastral Surveyor

REGISTRATION NUMBER: 1161724

DATE: 06/11/2024

CONTACT PHONE: 09 242 2717

EMAIL: reecem@maven.co.nz

NOTES

- ALL WORKS TO BE IN ACCORDANCE WITH AUCKLAND COUNCIL STANDARDS.
- COORDINATES IN TERMS OF NEW ZEALAND TRANSVERSE MERCATOR 2000 (NZTM 2000).
- LEVELS IN TERMS OF NEW ZEALAND VERTICAL DATUM 2016 (NZVD2016).  
ORIGIN OF LEVELS = RM 5846 SO 58211
- PUBLISHED RL=10.309, SOURCED FROM THE LINZ DIGITAL GEODETIC DATABASE.BOTANICAL SPECIES NAMES/ COMMON NAMES ARE:  
CB: CARPINUS BETULUS 'FASTIGIATA' / UPRIGHT EUROPEAN HORNBEAM  
DS: DYSOXYLUM SPECTABILE / KOHEKOHE  
AE: ALECTRYON EXCELSUS / TITOKI  
BT: BEILSCHMIEDIA TARAIRE / TARAIRE  
VL: VITEX LUCENS / PURIRI  
EU: EUGENIA VENTENATI / LILLY PILLY

|         |              |         |         |
|---------|--------------|---------|---------|
|         |              |         |         |
|         |              |         |         |
|         |              |         |         |
| A       | ASBUILT      | ML      | 10/2024 |
| Rev     | Description  | By      | Date    |
|         | By           | Date    |         |
| Survey  | DEMPSEY WOOD | 08/2024 |         |
| Design  | ML           | 08/2024 |         |
| Drawn   | ML           | 09/2024 |         |
| Checked | JD           | 08/2024 |         |

M A V E N

Maven Associates

09 571 0050

info@maven.co.nz

www.maven.co.nz

5 Owens Road, Epsom

Auckland 1023

Project

**62, 78 AND 80 PAPAKURA - CLEVEDON ROAD, CLEVEDON, AUCKLAND FOR CLEVEDON PROPERTIES LTD**

Title

**ENG60407601 STAGE 1 LANDSCAPE ASBUILT TABLE**

|             |                                                 |     |          |
|-------------|-------------------------------------------------|-----|----------|
| Project no. | 194006                                          |     |          |
| Scale       | NTS                                             |     |          |
| Cad file    | ENG60407601 - CLEVEDON MEADOWS - C950 LANDSCAPE |     |          |
| Drawing no. | STG_1 C959A                                     | Rev | <b>A</b> |