

CERTIFICATION

I CERTIFY THAT THESE AS-BUILT PLANS ARE AN ACCURATE RECORD OF THE WORKS UNDERTAKEN AND THAT:

THE COORDINATES (X, Y) ARE IN TERMS OF NZTM ON NZGD (2000), AND ARE WITHIN + 50MM.

THE LEVELS (Z) ARE IN TERMS OF THE NEW ZEALAND 2016 (MSL) LINZ DATUM (DOSLI DATUM), AND ARE WITHIN THE FOLLOWING TOLERANCES:


FOR ALL PIPE INVERTS & ROADSIDE CHANNELS TO BE WITHIN +/- 10MM (LOCAL CIRCUIT I.E. INTERNAL/RELATIVE CONSISTENCY REQUIRED ONLY)

FOR ALL OTHER ASSETS +/-20MM (E.G. MANHOLE COVERS, EARTHWORKS)

NAME:

REECE MOODY

SIGNED:

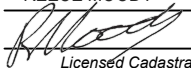
Licensed Cadastral Surveyor

REGISTRATION NUMBER:

1161724

DATE:

06/11/2024

CONTACT PHONE:

09 242 2717

EMAIL:

reecem@maven.co.nz

- NOTES
1.

ALL WORKS TO BE IN ACCORDANCE WITH AUCKLAND COUNCIL STANDARDS.
2.

COORDINATES IN TERMS OF NEW ZEALAND TRANSVERSE MERCATOR 2000 (NZTM 2000).
3.

LEVELS IN TERMS OF NEW ZEALAND VERTICAL DATUM 2016 (NZVD2016).
4.

ORIGIN OF LEVELS = RM 5846 SO 58211(BB2R) PUBLISHED RL=10.31, SOURCED FROM THE LINZ DIGITAL GEODETIC DATABASE.

- STAGE 1
- STAGE 2
- STAGE 3
- STAGE 4

- Legend
- EX BDY
- AB BDY
- STAGE BDY
- LV POWER 100
- HV POWER 140
- STREETLIGHT LINE
- LINK PILLAR
- POWER SERVICE PIT
- STREET LIGHT
- TRANSFORMER/ SWITCHGEAR

A	ASBUILT	ML	10/2024
Rev	Description	By	Date
		By	Date
Survey	DEMPSEY WOOD	08/2024	
Design	OMEXOM	08/2024	
Drawn	ML	10/2024	
Checked	JD	08/2024	

M

A

E

N

Maven Associates

09 571 0050

info@maven.co.nz

www.maven.co.nz

5 Owens Road, Epsom

Auckland 1023

Project

62, 78 AND 80 PAKAKURA - CLEVEDON ROAD, CLEVEDON, AUCKLAND FOR CLEVEDON PROPERTIES LTD

Title

ENG60407601 STAGE 1 POWER SUPPLY ASBUILT PLAN

Project no.	194006
Scale	1:3500 @ A3
Cad file	ENG60407601 - CLEVEDON MEADOWS - C990 POWER, ASBUILT.DWG
Drawing no.	STG_1 C990
Rev	A

73R MONUMENT ROAD
LOT 2 DP 176480, LOT 2 DP 67978, PT
ALLT 3 PARO WAIROA, LOT 1 DP 67852,
LOT 2 DP 67852, LOT 1 DP 176480

144 PAKAKURA-CLEVEDON ROAD
LOT 2 DP 142381, LOT 3 DP 142381,
LOT 2 DP 186158

PAKAKURA CLEVEDON ROAD

ASBUILT

DATE: 11/02/24 FILE PATH: F:\MAVEN\PROJECTS\194006 CLEVEDON MEADOWS ASBUILT\TS\STAGE 1\ENG60407601 - CLEVEDON MEADOWS - C990 POWER ASBUILT.DWG

DATE: 11/6/24 FILE PATH: F:\MAVEN\PROJECTS\194006 CLEVEDON\ASBUILT\TS\STAGE 1\ENG60407601 - CLEVEDON MEADOWS - C990 POWER ASBUILT.DWG



STAGE 4

AB SL

ACORN PARISH LANE (ROAD 2)

AB LV 100

LOT 1

LOT 2

1 TUD

2 TUD

AB HV 140 &
AB SL

100mm DUCT

100mm DUCT

AB SL

AB HV 140 & AB LV 100

MEADOWS DRIVE (ROAD 1)

AB HV 140

MEADOWS DRIVE (ROAD 1)

150mm DUCT

150mm DUCT

86 TUD

150mm DUCT

PAPAKIRA-CLEVEDON ROAD

NOTES

1. ALL WORKS TO BE IN ACCORDANCE WITH AUCKLAND COUNCIL STANDARDS.
2. COORDINATES IN TERMS OF NEW ZEALAND TRANSVERSE MERCATOR 2000 (NZTM 2000).
3. LEVELS IN TERMS OF NEW ZEALAND VERTICAL DATUM 2016 (NZVD2016).
4. ORIGIN OF LEVELS = RM 5846 SO 58211(BB2R) PUBLISHED RL=10.31, SOURCED FROM THE LINZ DIGITAL GEODETIC DATABASE.

Legend

- EX BDY
- AB BDY
- STAGE BDY
- LV POWER 100
- HV POWER 140
- STREETLIGHT LINE
- LINK PILLAR
- POWER SERVICE PIT
- STREET LIGHT
- TRANSFORMER/ SWITCHGEAR

A	ASBUILT	ML	10/2024
Rev	Description	By	Date
		By	Date
Survey	DEMPSEY WOOD	08/2024	
Design	OMEXOM	08/2024	
Drawn	ML	10/2024	
Checked	JD	08/2024	



Project
**62, 78 AND 80 PAPAKURA -
CLEVEDON ROAD,
CLEVEDON, AUCKLAND
FOR CLEVEDON
PROPERTIES LTD**


Title
**ENG60407601 STAGE 1
POWER SUPPLY
ASBUILT PLAN**

Project no.	194006
Scale	1:500 @ A3
Cad file	ENG60407601 - CLEVEDON MEADOWS - C990 POWER ASBUILT.DWG
Drawing no.	STG_1 C991
Rev	A


CERTIFICATION

I CERTIFY THAT THESE AS-BUILT PLANS ARE AN ACCURATE RECORD OF THE WORKS UNDERTAKEN AND THAT:

- THE COORDINATES (X, Y) ARE IN TERMS OF NZTM ON NZGD (2000), AND ARE WITHIN + 50MM.
- THE LEVELS (Z) ARE IN TERMS OF THE NEW ZEALAND 2016 (MSL) LINZ DATUM (DOSLI DATUM), AND ARE WITHIN THE FOLLOWING TOLERANCES:
 - FOR ALL PIPE INVERTS & ROADSIDE CHANNELS TO BE WITHIN +/- 10MM (LOCAL CIRCUIT I.E. INTERNAL/RELATIVE CONSISTENCY REQUIRED ONLY)
 - FOR ALL OTHER ASSETS +/-20MM (E.G. MANHOLE COVERS, EARTHWORKS)

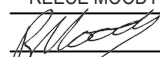NAME: REECE MOODY
SIGNED: 
Licensed Cadastral Surveyor
REGISTRATION NUMBER: 1161724 DATE: 06/11/2024
CONTACT PHONE: 09 242 2717
EMAIL: reecem@maven.co.nz

ASBUILT

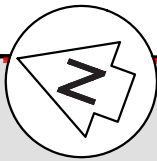

CERTIFICATION

I CERTIFY THAT THESE AS-BUILT PLANS ARE AN ACCURATE RECORD OF THE WORKS UNDERTAKEN AND THAT:

- THE COORDINATES (X, Y) ARE IN TERMS OF NZTM ON NZGD (2000), AND ARE WITHIN + 50MM.
- THE LEVELS (Z) ARE IN TERMS OF THE NEW ZEALAND 2016 (MSL) LINZ DATUM (DOSLI DATUM), AND ARE WITHIN THE FOLLOWING TOLERANCES:
 - FOR ALL PIPE INVERTS & ROADSIDE CHANNELS TO BE WITHIN +/- 10MM (LOCAL CIRCUIT I.E. INTERNAL/RELATIVE CONSISTENCY REQUIRED ONLY)
 - FOR ALL OTHER ASSETS +/-20MM (E.G. MANHOLE COVERS, EARTHWORKS)

NAME: REECE MOODY

SIGNED:

[Signature]

Licensed Cadastral Surveyor

REGISTRATION NUMBER: 1161724

DATE: 06/11/2024

CONTACT PHONE: 09 242 2717

EMAIL: reecem@maven.co.nz

NOTES

1. ALL WORKS TO BE IN ACCORDANCE WITH AUCKLAND COUNCIL STANDARDS.
2. COORDINATES IN TERMS OF NEW ZEALAND TRANSVERSE MERCATOR 2000 (NZTM 2000).
3. LEVELS IN TERMS OF NEW ZEALAND VERTICAL DATUM 2016 (NZVD2016).
4. ORIGIN OF LEVELS = RM 5846 SO 58211(BB2R) PUBLISHED RL=10.31, SOURCED FROM THE LINZ DIGITAL GEODETIC DATABASE.

Legend

- EX BDY
- AB BDY
- STAGE BDY
- LV POWER 100
- HV POWER 140
- STREETLIGHT LINE
- LINK PILLAR
- POWER SERVICE PIT
- STREET LIGHT
- TRANSFORMER/ SWITCHGEAR

A	ASBUILT	ML	10/2024
Rev	Description	By	Date
		By	Date
Survey	DEMPSEY WOOD	08/2024	
Design	OMEXOM	08/2024	
Drawn	ML	10/2024	
Checked	JD	08/2024	




Project
**62, 78 AND 80 PAKURA -
CLEVEDON ROAD,
CLEVEDON, AUCKLAND
FOR CLEVEDON
PROPERTIES LTD**

Title
**ENG60407601 STAGE 1
POWER SUPPLY
ASBUILT PLAN**

Project no.	194006
Scale	1:500 @ A3
Cad file	ENG60407601 - CLEVEDON MEADOWS - C990 POWER, ASBUILT.DWG
Drawing no.	STG_1 C992
Rev	A

DATE: 11/06/24 FILE PATH: F:\MAVEN\PROJECTS\194006 CLEVEDON MEADOWS ASBUILT\TS\STAGE 1\ENG60407601 - CLEVEDON MEADOWS - C990 POWER ASBUILT.DWG

ASBUILT

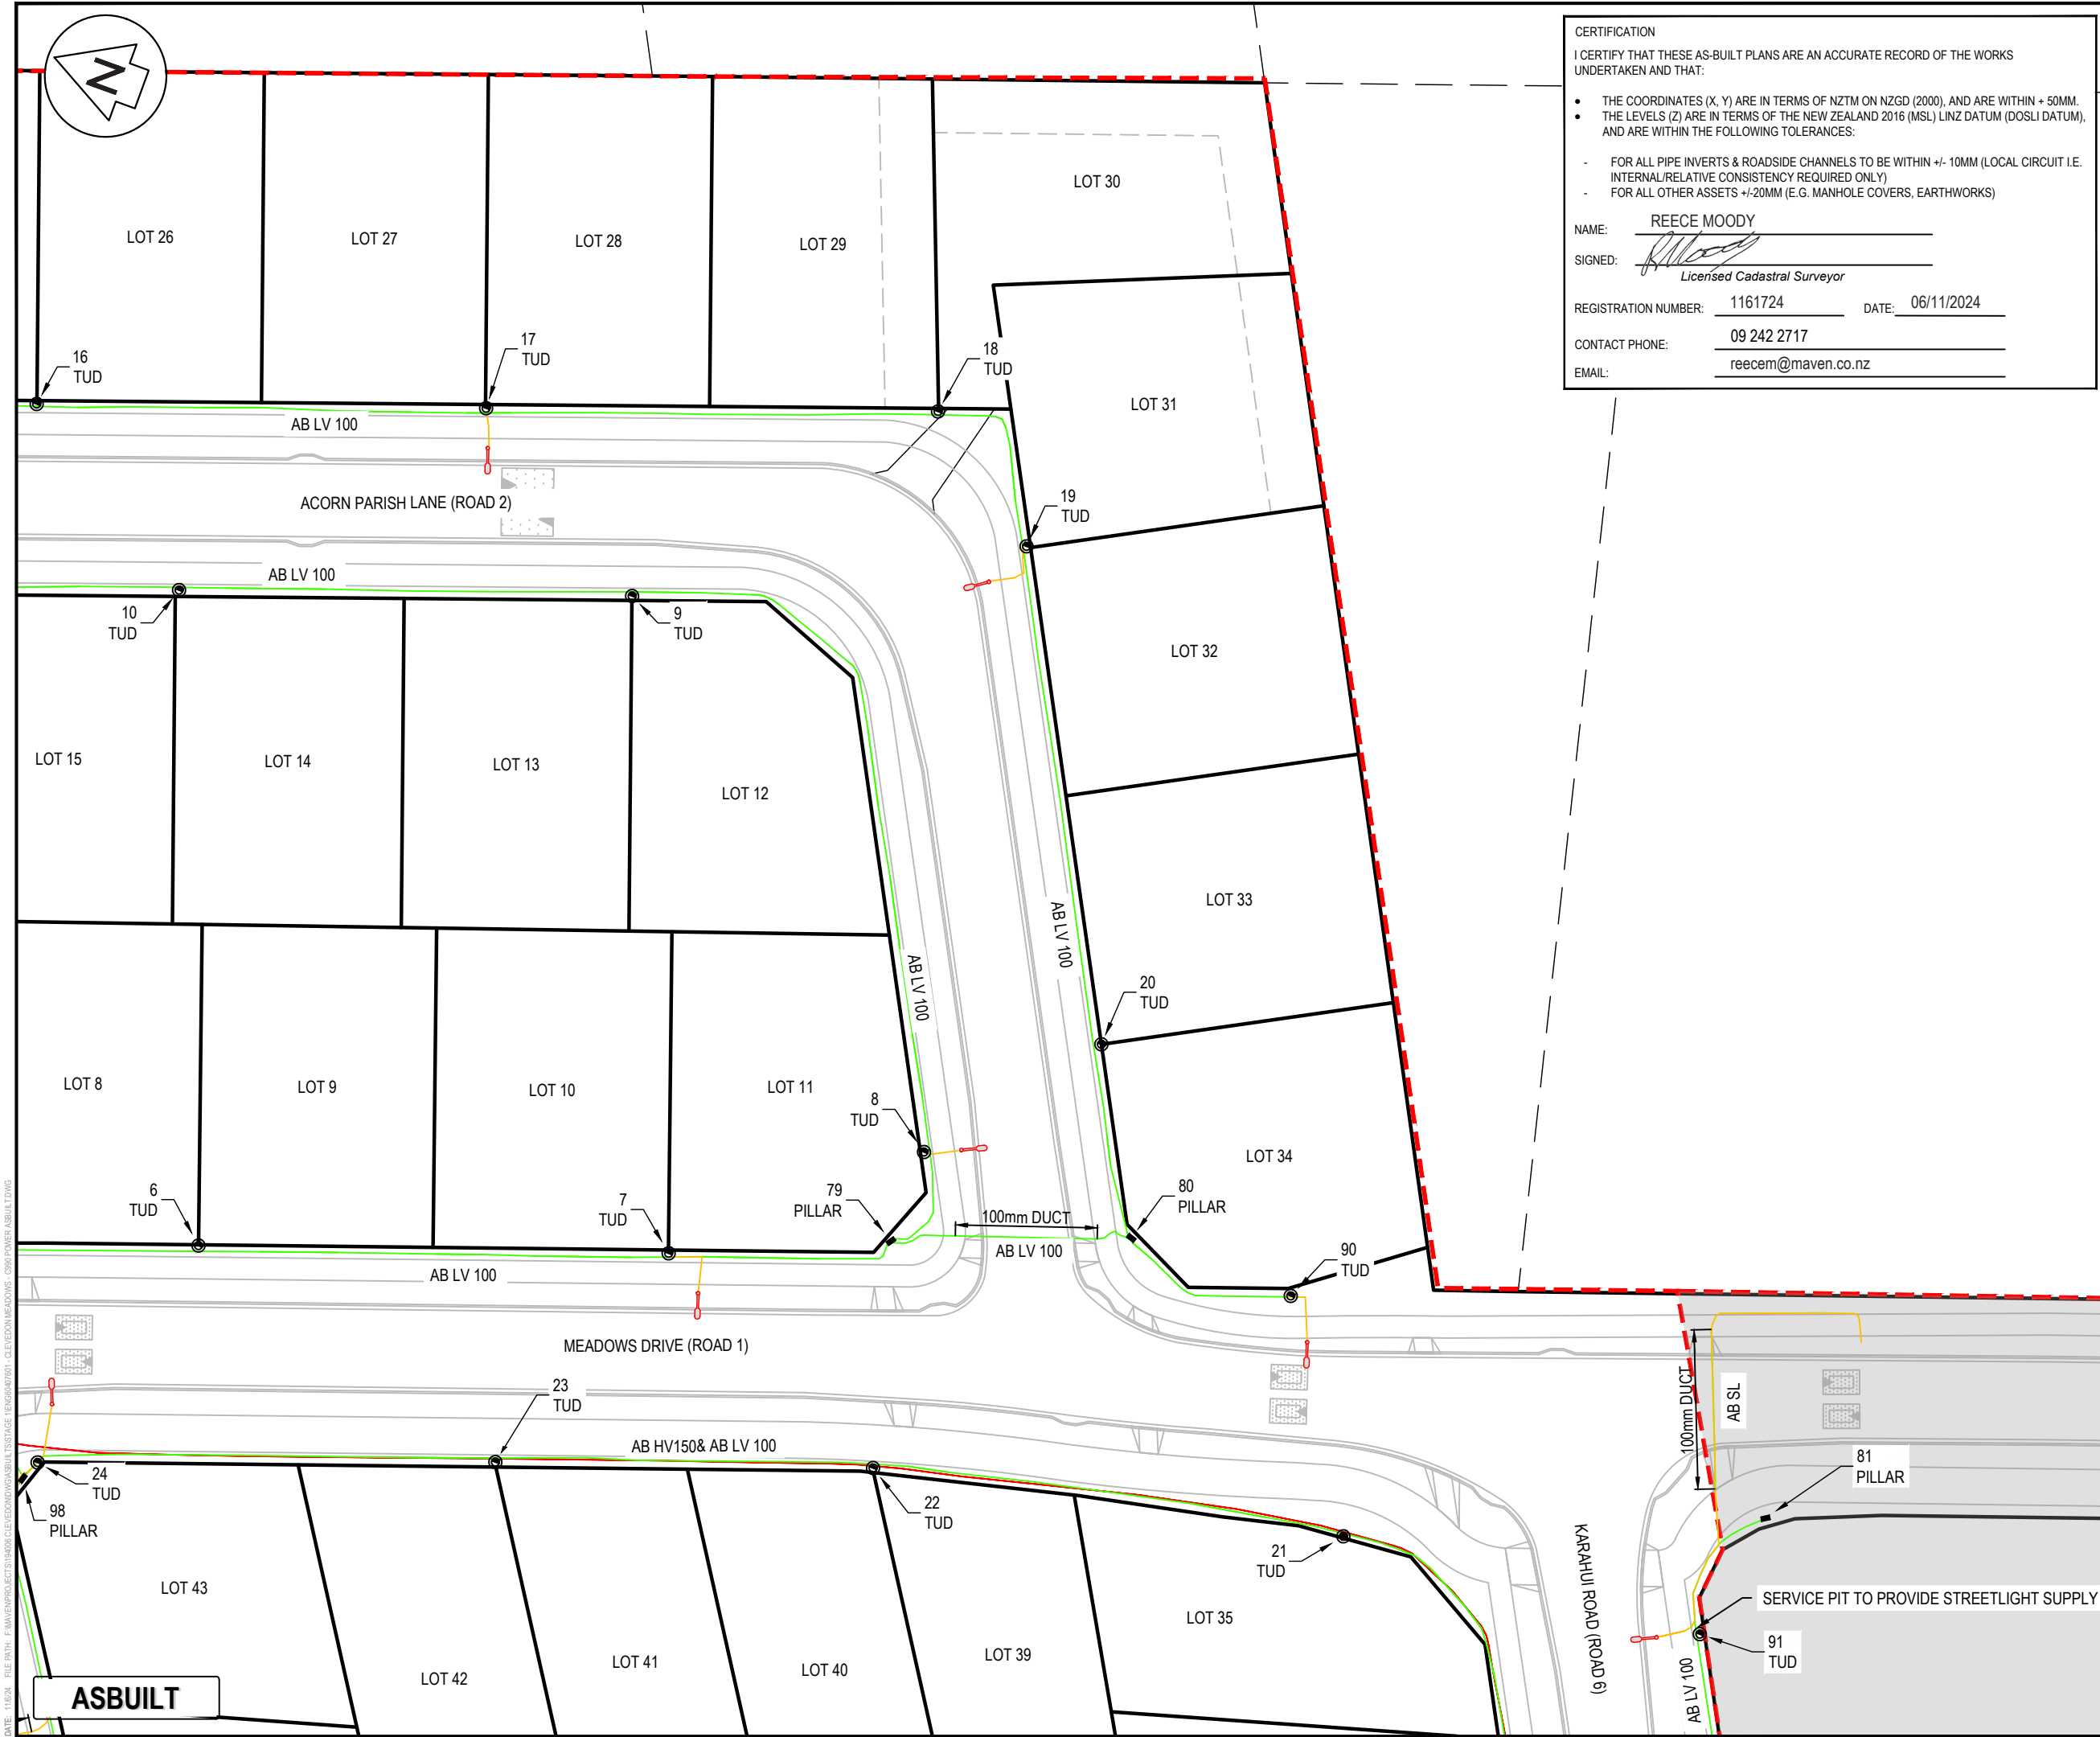

CERTIFICATION

I CERTIFY THAT THESE AS-BUILT PLANS ARE AN ACCURATE RECORD OF THE WORKS UNDERTAKEN AND THAT:

- THE COORDINATES (X, Y) ARE IN TERMS OF NZTM ON NZGD (2000), AND ARE WITHIN + 50MM.
- THE LEVELS (Z) ARE IN TERMS OF THE NEW ZEALAND 2016 (MSL) LINZ DATUM (DOSLI DATUM), AND ARE WITHIN THE FOLLOWING TOLERANCES:

- FOR ALL PIPE INVERTS & ROADSIDE CHANNELS TO BE WITHIN +/- 10MM (LOCAL CIRCUIT I.E. INTERNAL/RELATIVE CONSISTENCY REQUIRED ONLY)
- FOR ALL OTHER ASSETS +/-20MM (E.G. MANHOLE COVERS, EARTHWORKS)

NAME: REECE MOODY

SIGNED: *[Signature]*
Licensed Cadastral Surveyor

REGISTRATION NUMBER: 1161724 DATE: 06/11/2024

CONTACT PHONE: 09 242 2717

EMAIL: reecem@maven.co.nz

- NOTES
1. ALL WORKS TO BE IN ACCORDANCE WITH AUCKLAND COUNCIL STANDARDS.
 2. COORDINATES IN TERMS OF NEW ZEALAND TRANSVERSE MERCATOR 2000 (NZTM 2000).
 3. LEVELS IN TERMS OF NEW ZEALAND VERTICAL DATUM 2016 (NZVD2016).
 4. ORIGIN OF LEVELS = RM 5846 SO 58211(BB2R) PUBLISHED RL=10.31, SOURCED FROM THE LINZ DIGITAL GEODETIC DATABASE.

- Legend
- EX BDY
 - AB BDY
 - STAGE BDY
 - LV POWER 100
 - HV POWER 140
 - STREETLIGHT LINE
 - LINK PILLAR
 - POWER SERVICE PIT
 - STREET LIGHT
 - TRANSFORMER/ SWITCHGEAR

A	ASBUILT	ML	10/2024
Rev	Description	By	Date
		By	Date
Survey	DEMPSEY WOOD	08/2024	
Design	OMEXOM	08/2024	
Drawn	ML	10/2024	
Checked	JD	08/2024	


M **Maven Associates**
09 571 0050
info@maven.co.nz
www.maven.co.nz
5 Owens Road, Epsom
Auckland 1023

Project
62, 78 AND 80 PAPAURA - CLEVEDON ROAD, CLEVEDON, AUCKLAND FOR CLEVEDON PROPERTIES LTD

Title
ENG60407601 STAGE 1 POWER SUPPLY ASBUILT PLAN

Project no.	194006
Scale	1:500 @ A3
Cad file	ENG60407601 - CLEVEDON MEADOWS - C990 POWER, ASBUILT.DWG
Drawing no.	STG_1 C993
Rev	A

DATE: 11/02/24 FILE PATH: F:\MAVEN\PROJECTS\194006 CLEVEDON MEADOWS ASBUILT\STAGE 1 - CLEVEDON MEADOWS - C990 POWER ASBUILT.DWG

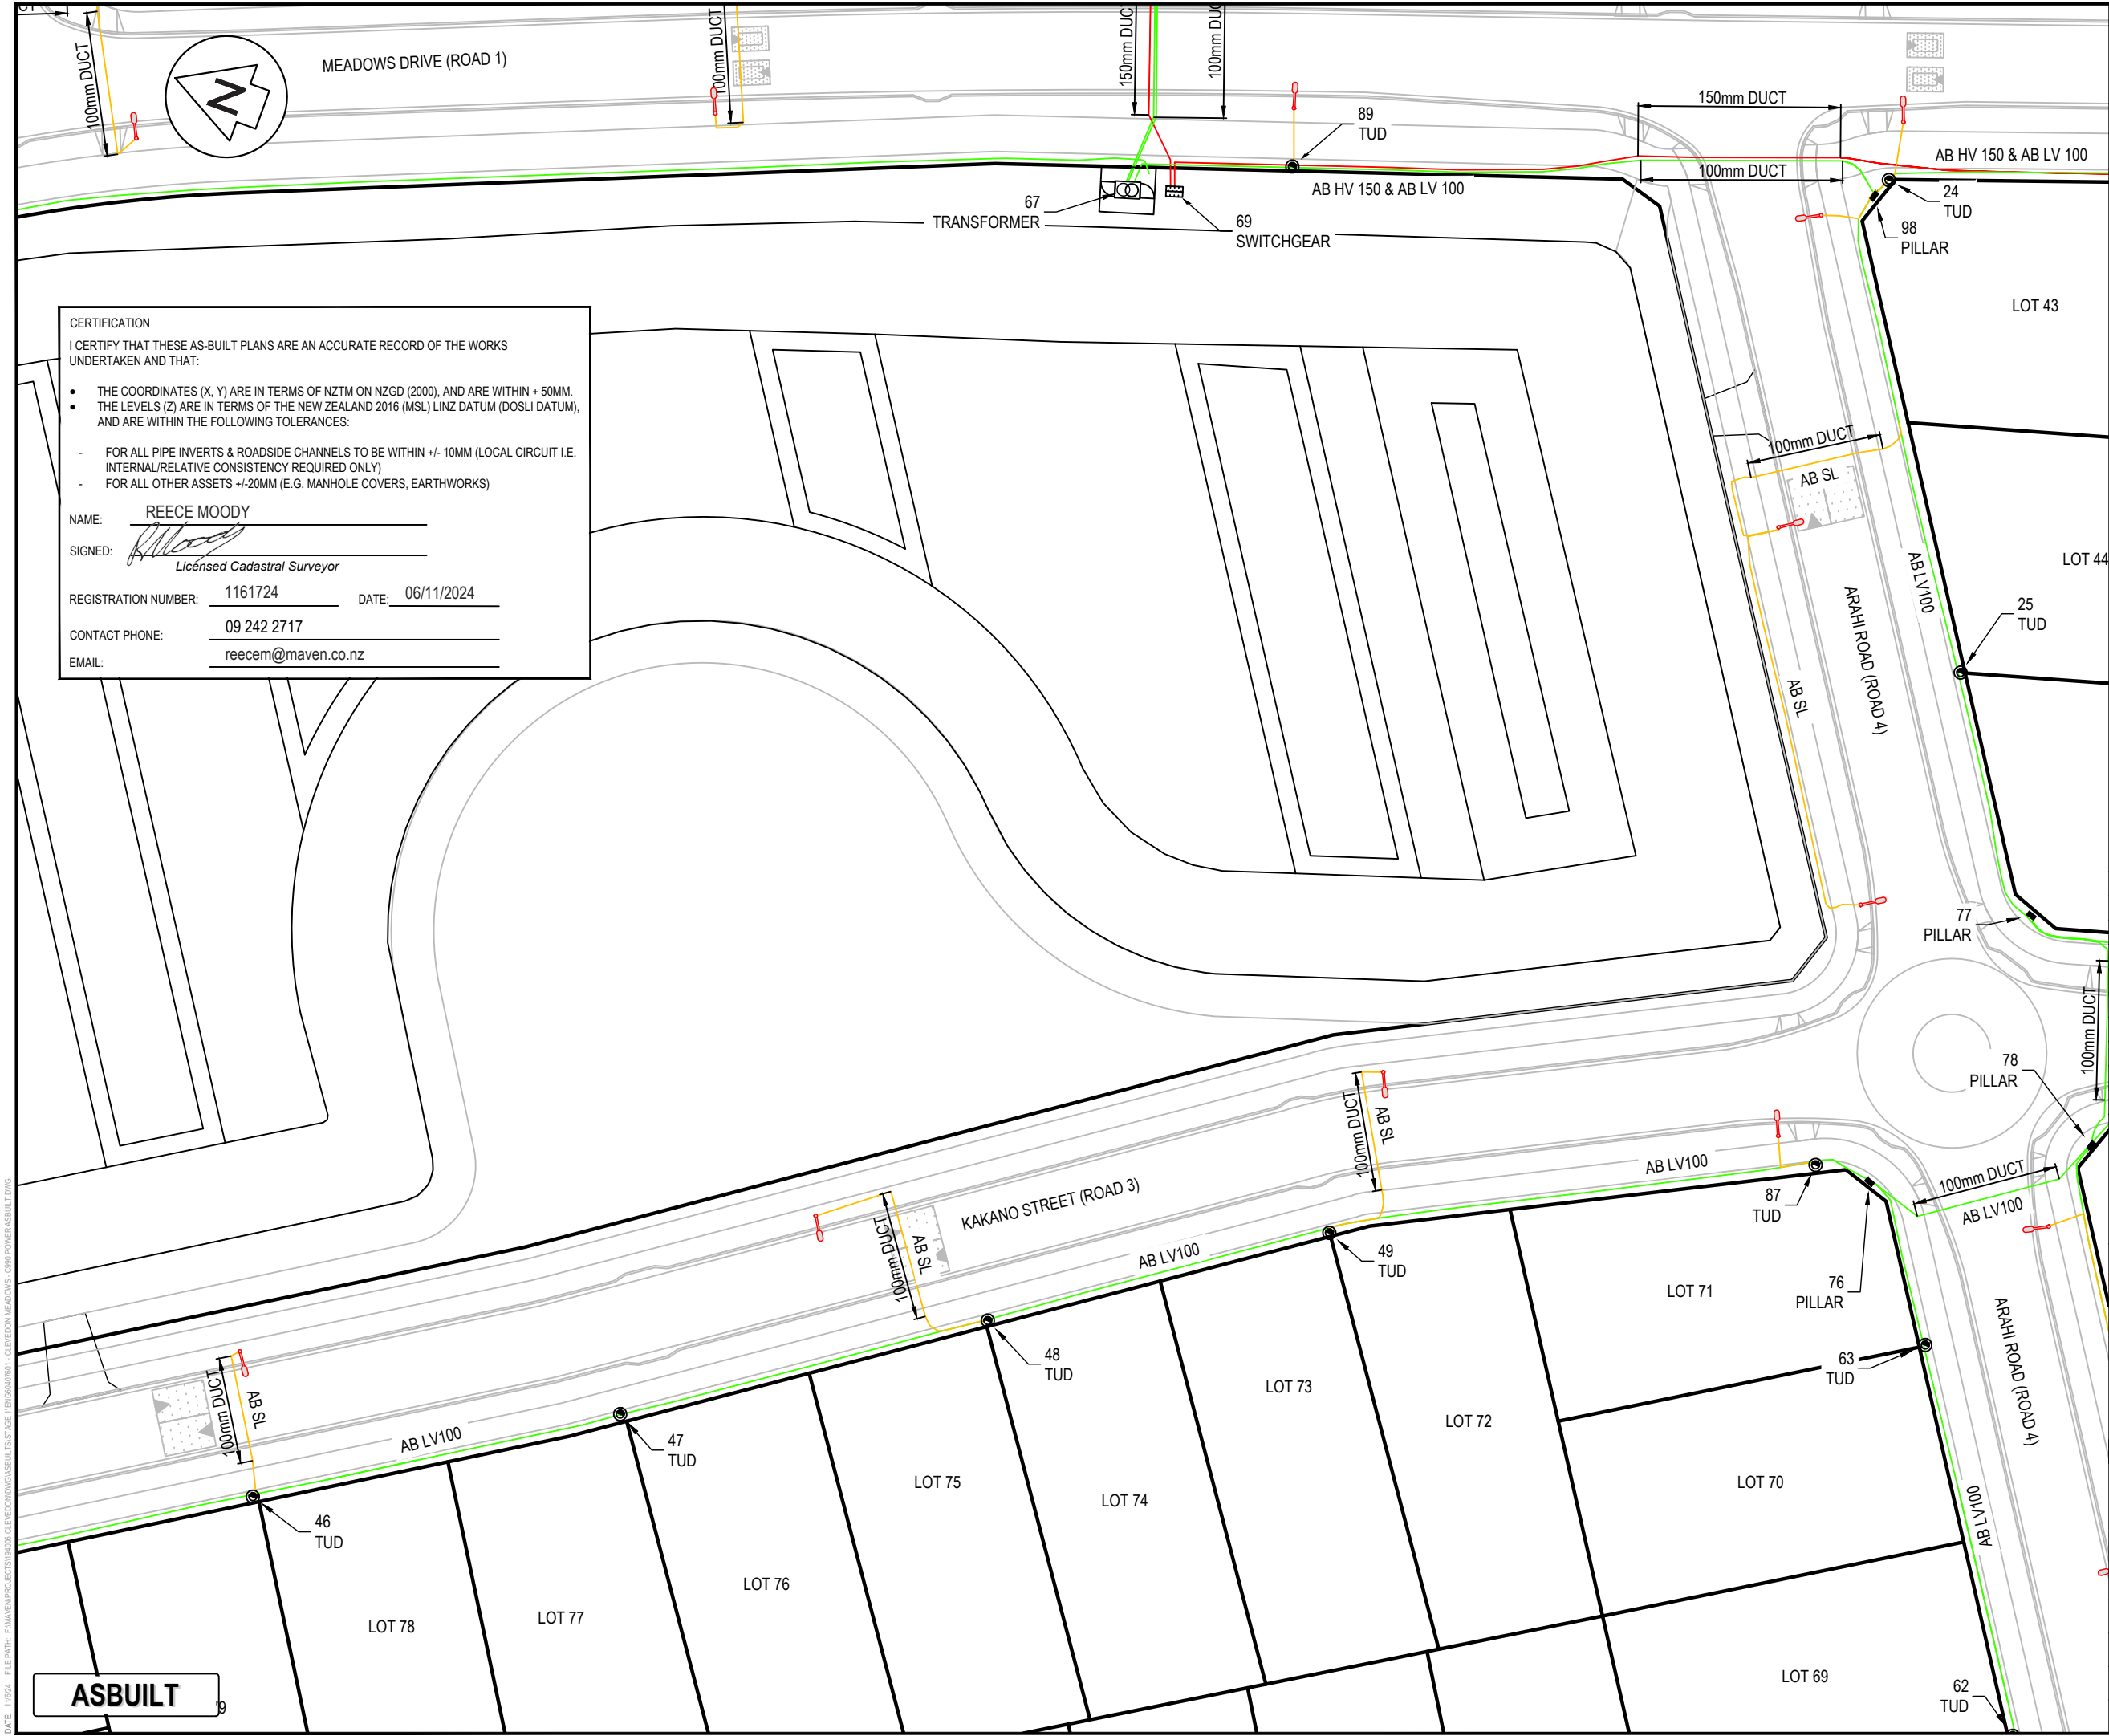

CERTIFICATION

I CERTIFY THAT THESE AS-BUILT PLANS ARE AN ACCURATE RECORD OF THE WORKS UNDERTAKEN AND THAT:

- THE COORDINATES (X, Y) ARE IN TERMS OF NZTM ON NZGD (2000), AND ARE WITHIN + 50MM.
- THE LEVELS (Z) ARE IN TERMS OF THE NEW ZEALAND 2016 (MSL) LINZ DATUM (DOSLI DATUM), AND ARE WITHIN THE FOLLOWING TOLERANCES:

- FOR ALL PIPE INVERTS & ROADSIDE CHANNELS TO BE WITHIN +/- 10MM (LOCAL CIRCUIT I.E. INTERNAL/RELATIVE CONSISTENCY REQUIRED ONLY)
- FOR ALL OTHER ASSETS +/-20MM (E.G. MANHOLE COVERS, EARTHWORKS)

NAME: REECE MOODY

SIGNED: *[Signature]*
Licensed Cadastral Surveyor

REGISTRATION NUMBER: 1161724 DATE: 06/11/2024

CONTACT PHONE: 09 242 2717

EMAIL: reecem@maven.co.nz

- NOTES
1. ALL WORKS TO BE IN ACCORDANCE WITH AUCKLAND COUNCIL STANDARDS.
 2. COORDINATES IN TERMS OF NEW ZEALAND TRANSVERSE MERCATOR 2000 (NZTM 2000).
 3. LEVELS IN TERMS OF NEW ZEALAND VERTICAL DATUM 2016 (NZVD2016).
 4. ORIGIN OF LEVELS = RM 5846 SO 58211(BB2R) PUBLISHED RL=10.31, SOURCED FROM THE LINZ DIGITAL GEODETIC DATABASE.

- Legend
- EX BDY
 - AB BDY
 - STAGE BDY
 - LV POWER 100
 - HV POWER 140
 - STREETLIGHT LINE
 - LINK PILLAR
 - POWER SERVICE PIT
 - STREET LIGHT
 - TRANSFORMER/ SWITCHGEAR

Rev	Description	By	Date
A	ASBUILT	ML	10/2024
Survey	DEMPSEY WOOD		08/2024
Design	OMEXOM		08/2024
Drawn	ML		10/2024
Checked	JD		08/2024


M **Maven Associates**
09 571 0050
info@maven.co.nz
www.maven.co.nz
5 Owens Road, Epsom
Auckland 1023

Project
**62, 78 AND 80 PAKAPURA -
CLEVEDON ROAD,
CLEVEDON, AUCKLAND
FOR CLEVEDON
PROPERTIES LTD**

Title
**ENG60407601 STAGE 1
POWER SUPPLY
ASBUILT PLAN**

Project no.	194006
Scale	1:500 @ A3
Cad file	ENG60407601 - CLEVEDON MEADOWS - C990 POWER - ASBUILT.DWG
Drawing no.	STG_1 C994
Rev	A

DATE: 11/02/24 FILE PATH: F:\MAVEN\PROJECTS\194006 CLEVEDON MEADOWS\ASBUILT\STAGE 1\ENG60407601 - CLEVEDON MEADOWS - C990 POWER ASBUILT.DWG

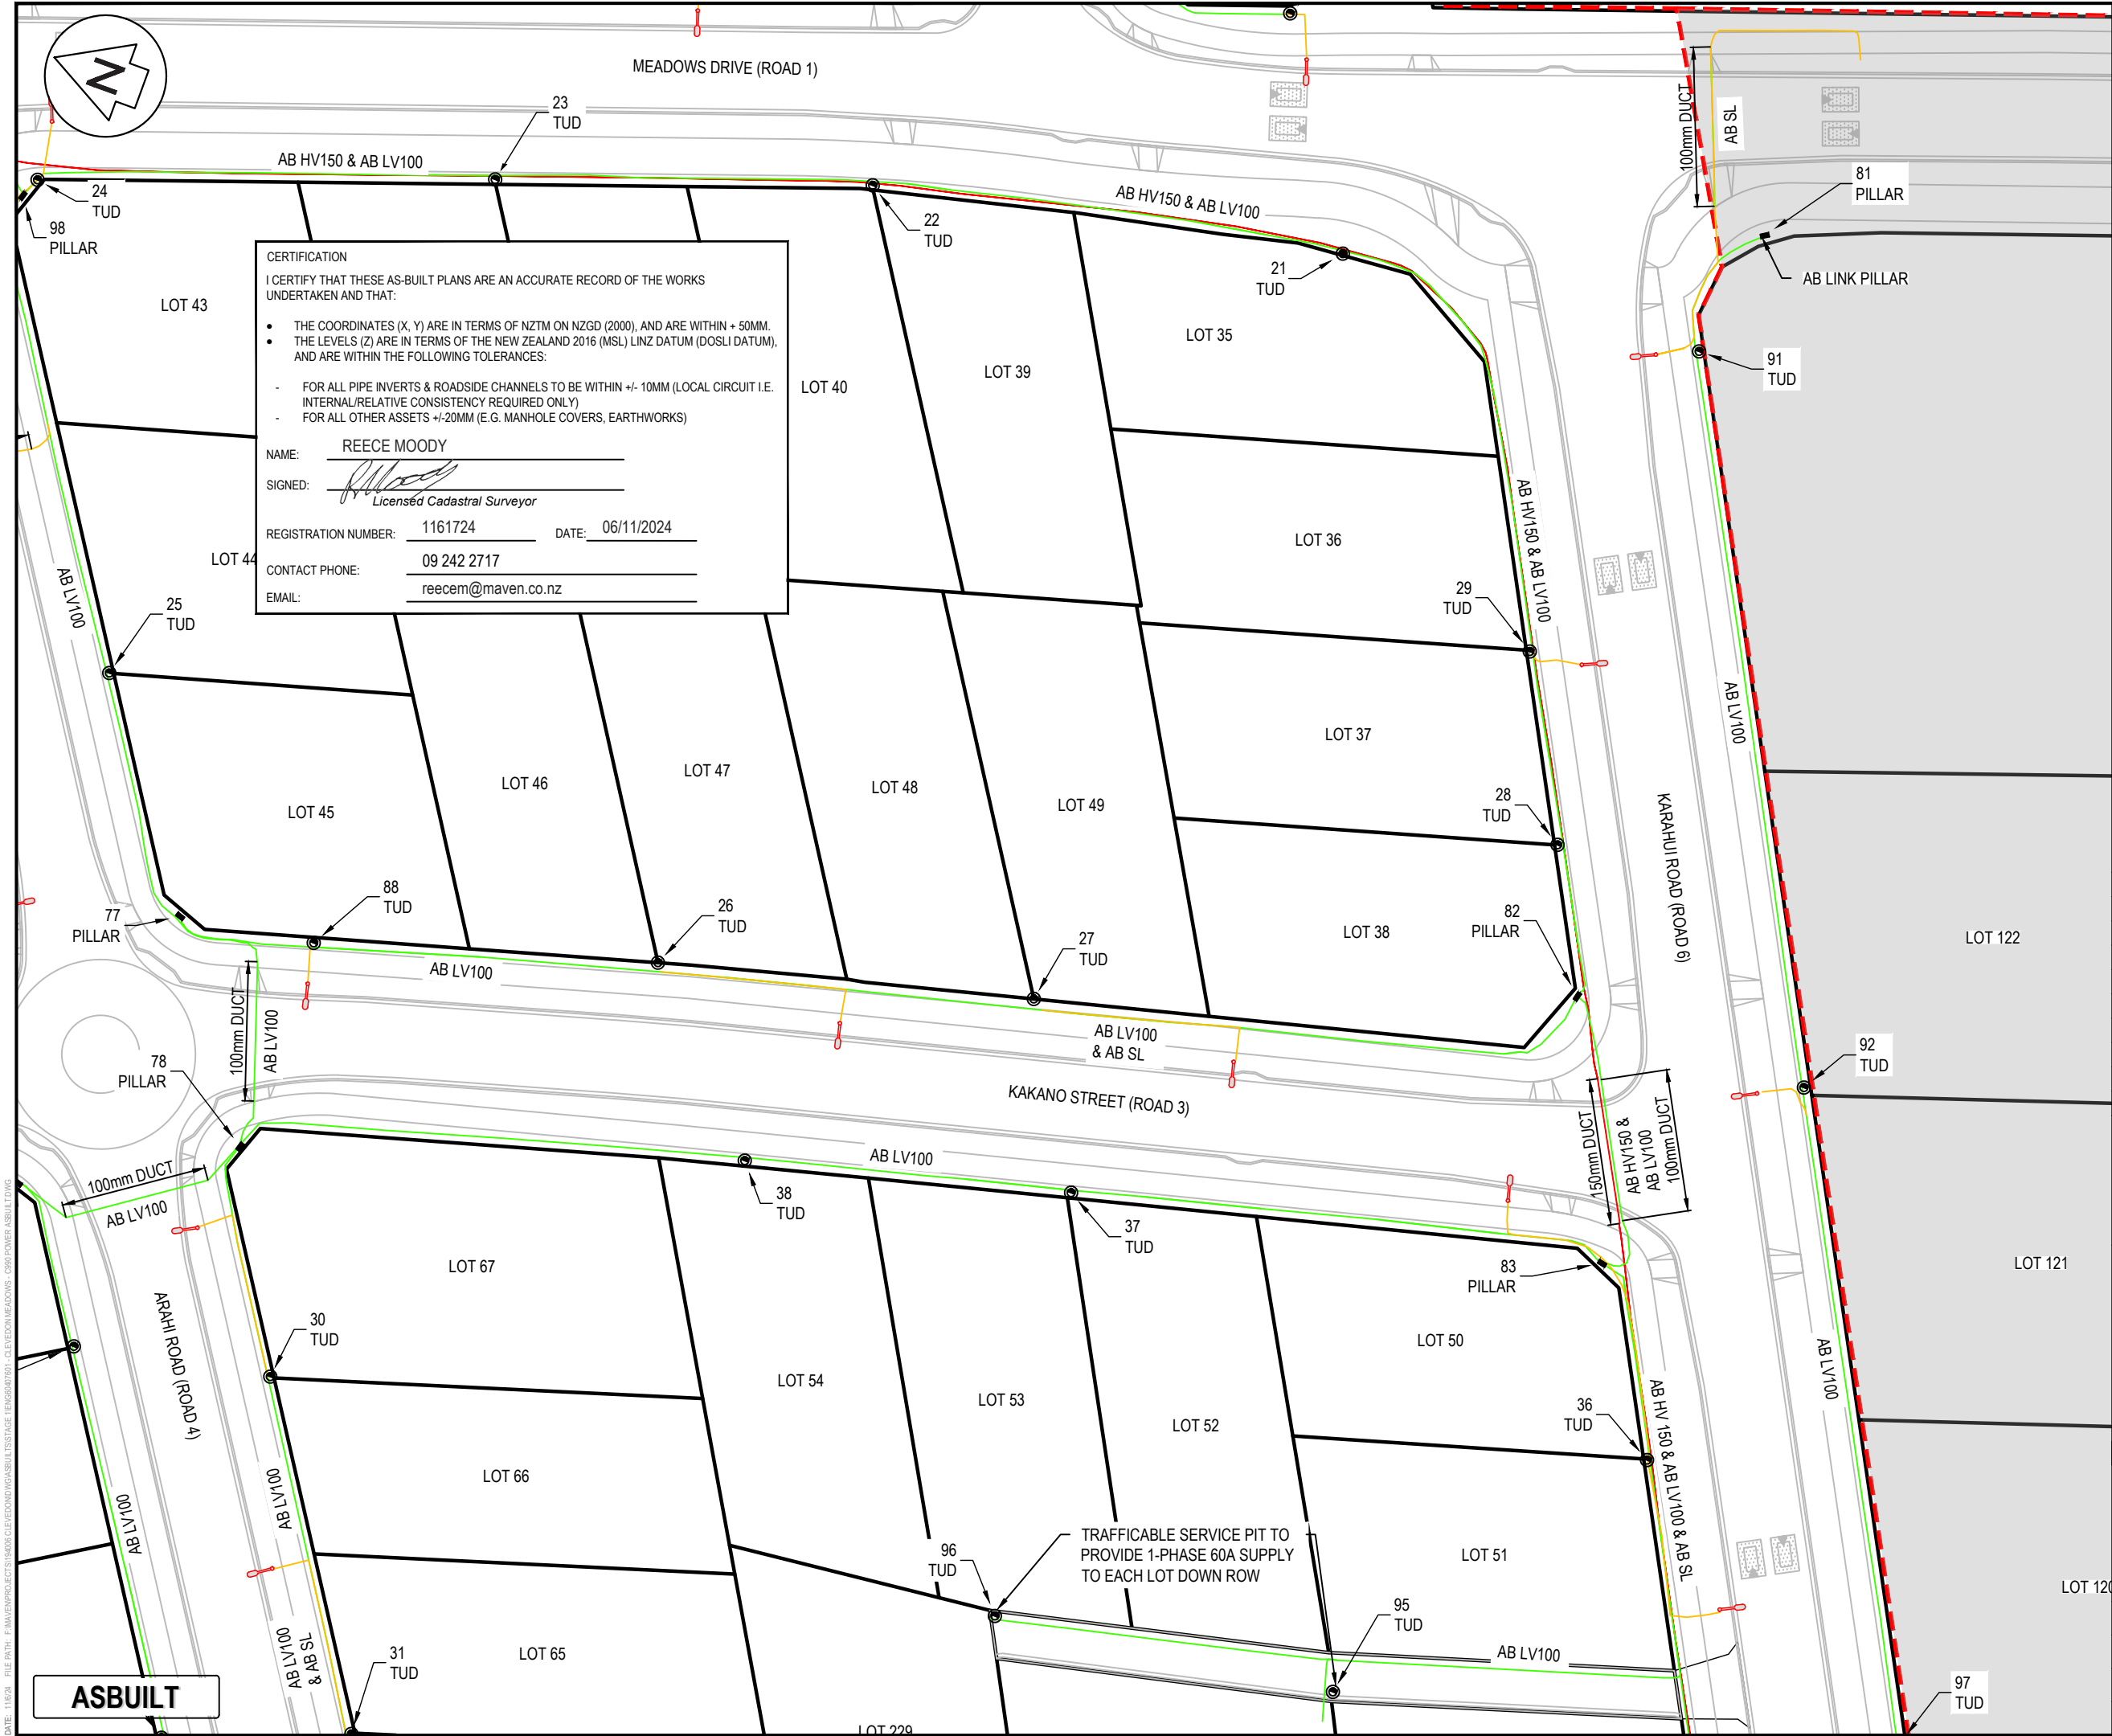

CERTIFICATION

I CERTIFY THAT THESE AS-BUILT PLANS ARE AN ACCURATE RECORD OF THE WORKS UNDERTAKEN AND THAT:

- THE COORDINATES (X, Y) ARE IN TERMS OF NZTM ON NZGD (2000), AND ARE WITHIN + 50MM.
- THE LEVELS (Z) ARE IN TERMS OF THE NEW ZEALAND 2016 (MSL) LINZ DATUM (DOSLI DATUM), AND ARE WITHIN THE FOLLOWING TOLERANCES:
 - FOR ALL PIPE INVERTS & ROADSIDE CHANNELS TO BE WITHIN +/- 10MM (LOCAL CIRCUIT I.E. INTERNAL/RELATIVE CONSISTENCY REQUIRED ONLY)
 - FOR ALL OTHER ASSETS +/-20MM (E.G. MANHOLE COVERS, EARTHWORKS)

NAME: REECE MOODY

SIGNED:

REGISTRATION NUMBER: 1161724 DATE: 06/11/2024

CONTACT PHONE: 09 242 2717

EMAIL: reecem@maven.co.nz

NOTES

- ALL WORKS TO BE IN ACCORDANCE WITH AUCKLAND COUNCIL STANDARDS.
- COORDINATES IN TERMS OF NEW ZEALAND TRANSVERSE MERCATOR 2000 (NZTM 2000).
- LEVELS IN TERMS OF NEW ZEALAND VERTICAL DATUM 2016 (NZVD2016).
- ORIGIN OF LEVELS = RM 5846 SO 58211(BB2R) PUBLISHED RL=10.31, SOURCED FROM THE LINZ DIGITAL GEODETIC DATABASE.

Legend

EX BDY

AB BDY

STAGE BDY

LV POWER 100

HV POWER 140

STREETLIGHT LINE

LINK PILLAR

POWER SERVICE PIT

STREET LIGHT

TRANSFORMER/ SWITCHGEAR

A	ASBUILT	ML	10/2024
Rev	Description	By	Date
		By	Date
Survey	DEMPSEY WOOD	08/2024	
Design	OMEXOM	08/2024	
Drawn	ML	10/2024	
Checked	JD	08/2024	

Maven Associates
09 571 0050
info@maven.co.nz
www.maven.co.nz
5 Owens Road, Epsom
Auckland 1023

Project

62, 78 AND 80 PAPAURA - CLEVEDON ROAD, CLEVEDON, AUCKLAND FOR CLEVEDON PROPERTIES LTD

Title

ENG60407601 STAGE 1 POWER SUPPLY ASBUILT PLAN

Project no.	194006		
Scale	1:500 @ A3		
Cad file	ENG60407601 - CLEVEDON MEADOWS - C990 POWER, ASBUILT.DWG		
Drawing no.	STG_1 C995	Rev	A

DATE: 11/02/24 FILE PATH: F:\MAVEN\PROJECTS\194006 CLEVEDON MEADOWS ASBUILT STAGE 1\ENG60407601 - CLEVEDON MEADOWS - C990 POWER ASBUILT.DWG

DATE: 11/02/24 FILE PATH: F:\MAVEN\PROJECTS\194006 CLEVEDON MEADOWS\ASBUILT - C990 POWER\ASBUILT.DWG



NOTES

- ALL WORKS TO BE IN ACCORDANCE WITH AUCKLAND COUNCIL STANDARDS.
- COORDINATES IN TERMS OF NEW ZEALAND TRANSVERSE MERCATOR 2000 (NZTM 2000).
- LEVELS IN TERMS OF NEW ZEALAND VERTICAL DATUM 2016 (NZVD2016).
- ORIGIN OF LEVELS = RM 5846 SO 58211(BB2R) PUBLISHED RL=10.31, SOURCED FROM THE LINZ DIGITAL GEODETIC DATABASE.

Legend

- EX BDY
- AB BDY
- STAGE BDY
- LV POWER 100
- HV POWER 140
- STREETLIGHT LINE
- LINK PILLAR
- POWER SERVICE PIT
- STREET LIGHT
- TRANSFORMER/ SWITCHGEAR

A	ASBUILT	ML	10/2024
Rev	Description	By	Date
Survey	DEMPSEY WOOD	08/2024	
Design	OMEXOM	08/2024	
Drawn	ML	10/2024	
Checked	JD	08/2024	

Maven Associates
09 571 0050
info@maven.co.nz
www.maven.co.nz
5 Owens Road, Epsom
Auckland 1023

Project
62, 78 AND 80 PAKAPURA - CLEVEDON ROAD, CLEVEDON, AUCKLAND FOR CLEVEDON PROPERTIES LTD

Title
ENG60407601 STAGE 1 POWER SUPPLY ASBUILT PLAN

Project no.	194006
Scale	1:500 @ A3
Cad file	ENG60407601 - CLEVEDON MEADOWS - C990 POWER, ASBUILT.DWG
Drawing no.	STG_1 C996
Rev	A

CERTIFICATION

I CERTIFY THAT THESE AS-BUILT PLANS ARE AN ACCURATE RECORD OF THE WORKS UNDERTAKEN AND THAT:

- THE COORDINATES (X, Y) ARE IN TERMS OF NZTM ON NZGD (2000), AND ARE WITHIN + 50MM.
- THE LEVELS (Z) ARE IN TERMS OF THE NEW ZEALAND 2016 (MSL) LINZ DATUM (DOSLI DATUM), AND ARE WITHIN THE FOLLOWING TOLERANCES:

- FOR ALL PIPE INVERTS & ROADSIDE CHANNELS TO BE WITHIN +/- 10MM (LOCAL CIRCUIT I.E. INTERNAL/RELATIVE CONSISTENCY REQUIRED ONLY)
- FOR ALL OTHER ASSETS +/-20MM (E.G. MANHOLE COVERS, EARTHWORKS)

NAME: **REECE MOODY**

SIGNED:

REGISTRATION NUMBER: **1161724** DATE: **06/11/2024**

CONTACT PHONE: **09 242 2717**

EMAIL: **reecem@maven.co.nz**

ASBUILT



NOTES

- ALL WORKS TO BE IN ACCORDANCE WITH AUCKLAND COUNCIL STANDARDS.
- COORDINATES IN TERMS OF NEW ZEALAND TRANSVERSE MERCATOR 2000 (NZTM 2000).
- LEVELS IN TERMS OF NEW ZEALAND VERTICAL DATUM 2016 (NZVD2016).
- ORIGIN OF LEVELS = RM 5846 SO 58211(BB2R) PUBLISHED RL=10.31, SOURCED FROM THE LINZ DIGITAL GEODETIC DATABASE.

Legend

- EX BDY
- AB BDY
- STAGE BDY
- LV POWER 100
- HV POWER 140
- STREETLIGHT LINE
- LINK PILLAR
- POWER SERVICE PIT
- STREET LIGHT
- TRANSFORMER/ SWITCHGEAR

A	ASBUILT	ML	10/2024
Rev	Description	By	Date
Survey	DEMPSEY WOOD	08/2024	
Design	OMEXOM	08/2024	
Drawn	ML	10/2024	
Checked	JD	08/2024	

M **Maven Associates**
09 571 0050
info@maven.co.nz
www.maven.co.nz
5 Owens Road, Epsom
Auckland 1023

Project
62, 78 AND 80 PAPA KURA - CLEVEDON ROAD, CLEVEDON, AUCKLAND FOR CLEVEDON PROPERTIES LTD

Title
ENG60407601 STAGE 1 POWER SUPPLY ASBUILT PLAN

Project no.	194006
Scale	1:500 @ A3
Cad file	ENG60407601 - CLEVEDON MEADOWS - C990 POWER, ASBUILT.DWG
Drawing no.	STG_1 C997
Rev	A

CERTIFICATION

I CERTIFY THAT THESE AS-BUILT PLANS ARE AN ACCURATE RECORD OF THE WORKS UNDERTAKEN AND THAT:

- THE COORDINATES (X, Y) ARE IN TERMS OF NZTM ON NZGD (2000), AND ARE WITHIN + 50MM.
- THE LEVELS (Z) ARE IN TERMS OF THE NEW ZEALAND 2016 (MSL) LINZ DATUM (DOSLI DATUM), AND ARE WITHIN THE FOLLOWING TOLERANCES:

- FOR ALL PIPE INVERTS & ROADSIDE CHANNELS TO BE WITHIN +/- 10MM (LOCAL CIRCUIT I.E. INTERNAL/RELATIVE CONSISTENCY REQUIRED ONLY)
- FOR ALL OTHER ASSETS +/-20MM (E.G. MANHOLE COVERS, EARTHWORKS)

NAME: REECE MOODY

SIGNED: *[Signature]*
Licensed Cadastral Surveyor

REGISTRATION NUMBER: 1161724 DATE: 06/11/2024

CONTACT PHONE: 09 242 2717

EMAIL: reecem@maven.co.nz

DATE: 11/6/24 FILE PATH: F:\MAVEN\PROJECTS\194006 CLEVEDON MEADOWS\STAGE 1\ENG60407601 - CLEVEDON MEADOWS - C990 POWER ASBUILT.DWG

ASBUILT



- NOTES
1. ALL WORKS TO BE IN ACCORDANCE WITH AUCKLAND COUNCIL STANDARDS.
 2. COORDINATES IN TERMS OF NEW ZEALAND TRANSVERSE MERCATOR 2000 (NZTM 2000).
 3. LEVELS IN TERMS OF NEW ZEALAND VERTICAL DATUM 2016 (NZVD2016).
 4. ORIGIN OF LEVELS = RM 5846 SO 58211(BB2R) PUBLISHED RL=10.31, SOURCED FROM THE LINZ DIGITAL GEODETIC DATABASE.

Legend

---	EX BDY
---	AB BDY
---	STAGE BDY
---	LV POWER 100
---	HV POWER 140
---	STREETLIGHT LINE
---	LINK PILLAR
---	POWER SERVICE PIT
---	STREET LIGHT
---	TRANSFORMER/ SWITCHGEAR

A	ASBUILT	ML	10/2024
Rev	Description	By	Date
		By	Date
Survey	DEMPSEY WOOD	08/2024	
Design	OMEXOM	08/2024	
Drawn	ML	10/2024	
Checked	JD	08/2024	



Project
62, 78 AND 80 PAKURA - CLEVEDON ROAD, CLEVEDON, AUCKLAND FOR CLEVEDON PROPERTIES LTD

Title
ENG60407601 STAGE 1 POWER SUPPLY ASBUILT PLAN

Project no.	194006
Scale	1:500 @ A3
Cad file	ENG60407601 - CLEVEDON MEADOWS - C990 POWER, ASBUILT.DWG
Drawing no.	STG_1 C998
Rev	A

CERTIFICATION
I CERTIFY THAT THESE AS-BUILT PLANS ARE AN ACCURATE RECORD OF THE WORKS UNDERTAKEN AND THAT:

- THE COORDINATES (X, Y) ARE IN TERMS OF NZTM ON NZGD (2000), AND ARE WITHIN + 50MM.
- THE LEVELS (Z) ARE IN TERMS OF THE NEW ZEALAND 2016 (MSL) LINZ DATUM (DOSLI DATUM), AND ARE WITHIN THE FOLLOWING TOLERANCES:
 - FOR ALL PIPE INVERTS & ROADSIDE CHANNELS TO BE WITHIN +/- 10MM (LOCAL CIRCUIT I.E. INTERNAL/RELATIVE CONSISTENCY REQUIRED ONLY)
 - FOR ALL OTHER ASSETS +/-20MM (E.G. MANHOLE COVERS, EARTHWORKS)

NAME: REECE MOODY
SIGNED: *[Signature]*
REGISTRATION NUMBER: 1161724 DATE: 06/11/2024
CONTACT PHONE: 09 242 2717
EMAIL: reecem@maven.co.nz

ASBUILT

DATE: 11/02/24 FILE PATH: F:\MAVEN\PROJECTS\194006 CLEVEDON\DWG\ASBUILT\194006 CLEVEDON MEADOWS - C990 POWER ASBUILT.DWG

ASBUILT

TABLE OF CO-ORDINATES (NZTM)			
Point #	Description	Northing	Easting
1	TUD	5903349.34mN	1781139.74mE
2	TUD	5903330.09mN	1781145.53mE
3	TUD	5903302.44mN	1781156.92mE
4	TUD	5903270.56mN	1781169.16mE
5	TUD	5903234.62mN	1781181.29mE
6	TUD	5903197.88mN	1781194.51mE
7	TUD	5903161.33mN	1781207.16mE
8	TUD	5903144.44mN	1781222.18mE
9	TUD	5903182.66mN	1781256.91mE
10	TUD	5903217.84mN	1781244.60mE
11	TUD	5903253.84mN	1781231.54mE
12	TUD	5903289.62mN	1781218.91mE
13	TUD	5903324.07mN	1781199.29mE
14	TUD	5903300.85mN	1781231.42mE
15	TUD	5903268.87mN	1781242.54mE
16	TUD	5903234.09mN	1781254.97mE
17	TUD	5903199.23mN	1781267.30mE
18	TUD	5903164.20mN	1781279.78mE
19	TUD	5903153.57mN	1781271.86mE
20	TUD	5903133.76mN	1781235.50mE
21	TUD	5903101.20mN	1781204.30mE
22	TUD	5903139.48mN	1781196.33mE
23	TUD	5903168.84mN	1781186.15mE
24	TUD	5903204.22mN	1781173.22mE
25	TUD	5903184.78mN	1781137.12mE
26	TUD	5903134.18mN	1781130.19mE
27	TUD	5903104.10mN	1781137.98mE
28	TUD	5903067.95mN	1781164.65mE
29	TUD	5903075.53mN	1781178.82mE
30	TUD	5903152.50mN	1781087.27mE
31	TUD	5903136.17mN	1781061.93mE
32	TUD	5903119.38mN	1781035.87mE
33	TUD	5903065.22mN	1781035.96mE

TABLE OF CO-ORDINATES (NZTM)			
Point #	Description	Northing	Easting
34	TUD	5903050.26mN	1781040.48mE
35	TUD	5903025.18mN	1781085.25mE
36	TUD	5903043.68mN	1781119.62mE
37	TUD	5903095.76mN	1781124.05mE
38	TUD	5903121.90mN	1781117.34mE
39	TUD	5902995.41mN	1781020.50mE
40	TUD	5903031.43mN	1781030.47mE
41	TUD	5903056.06mN	1781022.80mE
42	TUD	5903063.08mN	1781020.51mE
43	TUD	5903086.93mN	1781013.15mE
44	TUD	5903093.71mN	1781010.92mE
45	TUD	5903115.38mN	1781004.08mE
46	TUD	5903293.78mN	1781025.12mE
47	TUD	5903267.66mN	1781041.89mE
48	TUD	5903241.84mN	1781059.50mE
49	TUD	5903217.85mN	1781075.93mE
50	TUD	5903144.97mN	1781021.80mE
51	TUD	5903163.57mN	1781010.39mE
52	TUD	5903195.81mN	1780990.56mE
53	TUD	5903197.88mN	1780950.95mE
54	TUD	5903243.73mN	1780960.00mE
55	TUD	5903274.11mN	1780941.00mE
56	TUD	5903290.56mN	1780931.19mE
57	TUD	5903308.49mN	1780959.44mE
58	TUD	5903259.58mN	1780970.66mE
59	TUD	5903233.06mN	1780986.57mE
60	TUD	5903206.42mN	1781002.08mE
61	TUD	5903181.07mN	1781017.73mE
62	TUD	5903150.74mN	1781056.29mE
63	TUD	5903168.54mN	1781084.07mE
64	TUD	5903325.59mN	1780986.12mE
65	TUD	5903342.38mN	1780979.99mE
66	TUD	5903311.01mN	1780931.25mE

TABLE OF CO-ORDINATES (NZTM)			
Point #	Description	Northing	Easting
67	TRANSFORMER	5903262.91mN	1781150.98mE
68	TRANSFORMER	5903037.18mN	1781051.31mE
69	SWITCHGEAR	5903259.21mN	1781152.17mE
70	SWITCHGEAR	5903035.52mN	1781048.21mE
71	PILLAR	5903295.08mN	1780948.90mE
72	PILLAR	5903231.01mN	1780966.64mE
73	PILLAR	5903209.32mN	1780977.79mE
74	PILLAR	5903144.08mN	1781041.67mE
75	PILLAR	5903128.51mN	1781050.02mE
76	PILLAR	5903177.49mN	1781095.13mE
77	PILLAR	5903172.45mN	1781120.32mE
78	PILLAR	5903161.31mN	1781104.19mE
79	PILLAR	5903144.50mN	1781214.38mE
80	PILLAR	5903125.98mN	1781221.38mE
81	PILLAR	5903069.09mN	1781217.60mE
82	PILLAR	5903062.15mN	1781153.49mE
83	PILLAR	5903052.73mN	1781133.56mE
84	PILLAR	5903035.75mN	1781028.96mE
85	PILLAR	5902994.50mN	1781065.52mE
86	TUD	5903404.56mN	1781074.85mE
87	TUD	5903182.11mN	1781094.92mE
88	TUD	5903161.36mN	1781122.02mE
89	TUD	5903250.81mN	1781157.43mE
90	TUD	5903112.03mN	1781221.39mE
91	TUD	5903070.90mN	1781206.79mE
92	TUD	5903042.05mN	1781152.84mE
93	TUD	5903015.48mN	1781067.27mE
94	TUD	5903001.00mN	1781077.23mE
95	TUD	5903061.44mN	1781092.85mE
96	TUD	5903089.73mN	1781089.18mE
97	TUD	5903016.12mN	1781104.98mE
98	PILLAR	5903204.91mN	1781171.57mE

CERTIFICATION

I CERTIFY THAT THESE AS-BUILT PLANS ARE AN ACCURATE RECORD OF THE WORKS UNDERTAKEN AND THAT:

THE COORDINATES (X, Y) ARE IN TERMS OF NZTM ON NZGD (2000), AND ARE WITHIN + 50MM.

THE LEVELS (Z) ARE IN TERMS OF THE NEW ZEALAND 2016 (MSL) LINZ DATUM (DOSLI DATUM), AND ARE WITHIN THE FOLLOWING TOLERANCES:

FOR ALL PIPE INVERTS & ROADSIDE CHANNELS TO BE WITHIN +/- 10MM (LOCAL CIRCUIT I.E. INTERNAL/RELATIVE CONSISTENCY REQUIRED ONLY)

FOR ALL OTHER ASSETS +/-20MM (E.G. MANHOLE COVERS, EARTHWORKS)

NAME: REECE MOODY

SIGNED:

Licensed Cadastral Surveyor

REGISTRATION NUMBER: 1161724 DATE: 06/11/2024

CONTACT PHONE: 09 242 2717

EMAIL: reecem@maven.co.nz

- NOTES
- ALL WORKS TO BE IN ACCORDANCE WITH AUCKLAND COUNCIL STANDARDS.
 - COORDINATES IN TERMS OF NEW ZEALAND TRANSVERSE MERCATOR 2000 (NZTM 2000).
 - LEVELS IN TERMS OF NEW ZEALAND VERTICAL DATUM 2016 (NZVD2016).
 - ORIGIN OF LEVELS = RM 5846 SO 58211(BB2R) PUBLISHED RL=10.31, SOURCED FROM THE LINZ DIGITAL GEODETIC DATABASE.

A	ASBUILT	ML	10/2024
Rev	Description	By	Date
		By	Date
Survey	DEMPSEY WOOD		08/2024
Design	OMEXOM		08/2024
Drawn	ML		10/2024
Checked	JD		08/2024

M

MAVEN

Maven Associates

09 571 0050

info@maven.co.nz

www.maven.co.nz

5 Owens Road, Epsom

Auckland 1023

Project

62, 78 AND 80 PAPAKURA - CLEVEDON ROAD, CLEVEDON, AUCKLAND FOR CLEVEDON PROPERTIES LTD

Title

ENG60407601 STAGE 1 POWER SUPPLY ASBUILT PLAN

Project no.

194006

Scale

NTS

Cad file

ENG60407601 - CLEVEDON MEADOWS - C990 POWER ASBUILT.DWG

Drawing no.

STG_1 C999

Rev

A