



- NOTES
1. ALL WORKS TO BE IN ACCORDANCE WITH AUCKLAND COUNCIL STANDARDS.
 2. COORDINATES IN TERMS OF NZ GEODETIC DATUM MT EDEN 2000.
 3. LEVELS IN TERMS OF THE NEW ZEALAND VERTICAL DATUM 2016.
 4. ORIGIN OF LEVELS = RM 5846 SO 58211(BB2R) PUBLISHED RL=10.31, SOURCED FROM THE LINZ DIGITAL GEODETIC DATABASE.
 5. BOUNDARIES ARE SUBJECT TO FINAL SURVEY.

- LEGEND
- EX BDY
 - PROP BDY
 - WETLAND
 - AB STORMWATER
 - EX STORMWATER
 - AB FENCE
 - EX / AB SWMH
 - AB SWCP SINGLE
 - AB SWCP DOUBLE


Rev	Description	By	Date
A	ASBUILT	ARS	10/2024
Survey	DEMPSEY WOOD		10/2024
Design	ML		10/2024
Drawn	ARS		10/2024
Checked	RM		10/2024



Project
62, 78, AND 80 PAPAKURA-CLEVEDON ROAD, CLEVEDON, AUCKLAND FOR CLEVEDON PROPERTIES LTD

Title
ENG60407601 STAGE 1 STORMWATER WETLAND ASBUILT PLAN

Project no.	194006
Scale	1:1000 @ A3
Cad file	ENG60407601-CLEVEDON MEADOWS- C970 WETLAND ASBUILT.DWG
Drawing no.	C970
Rev	A

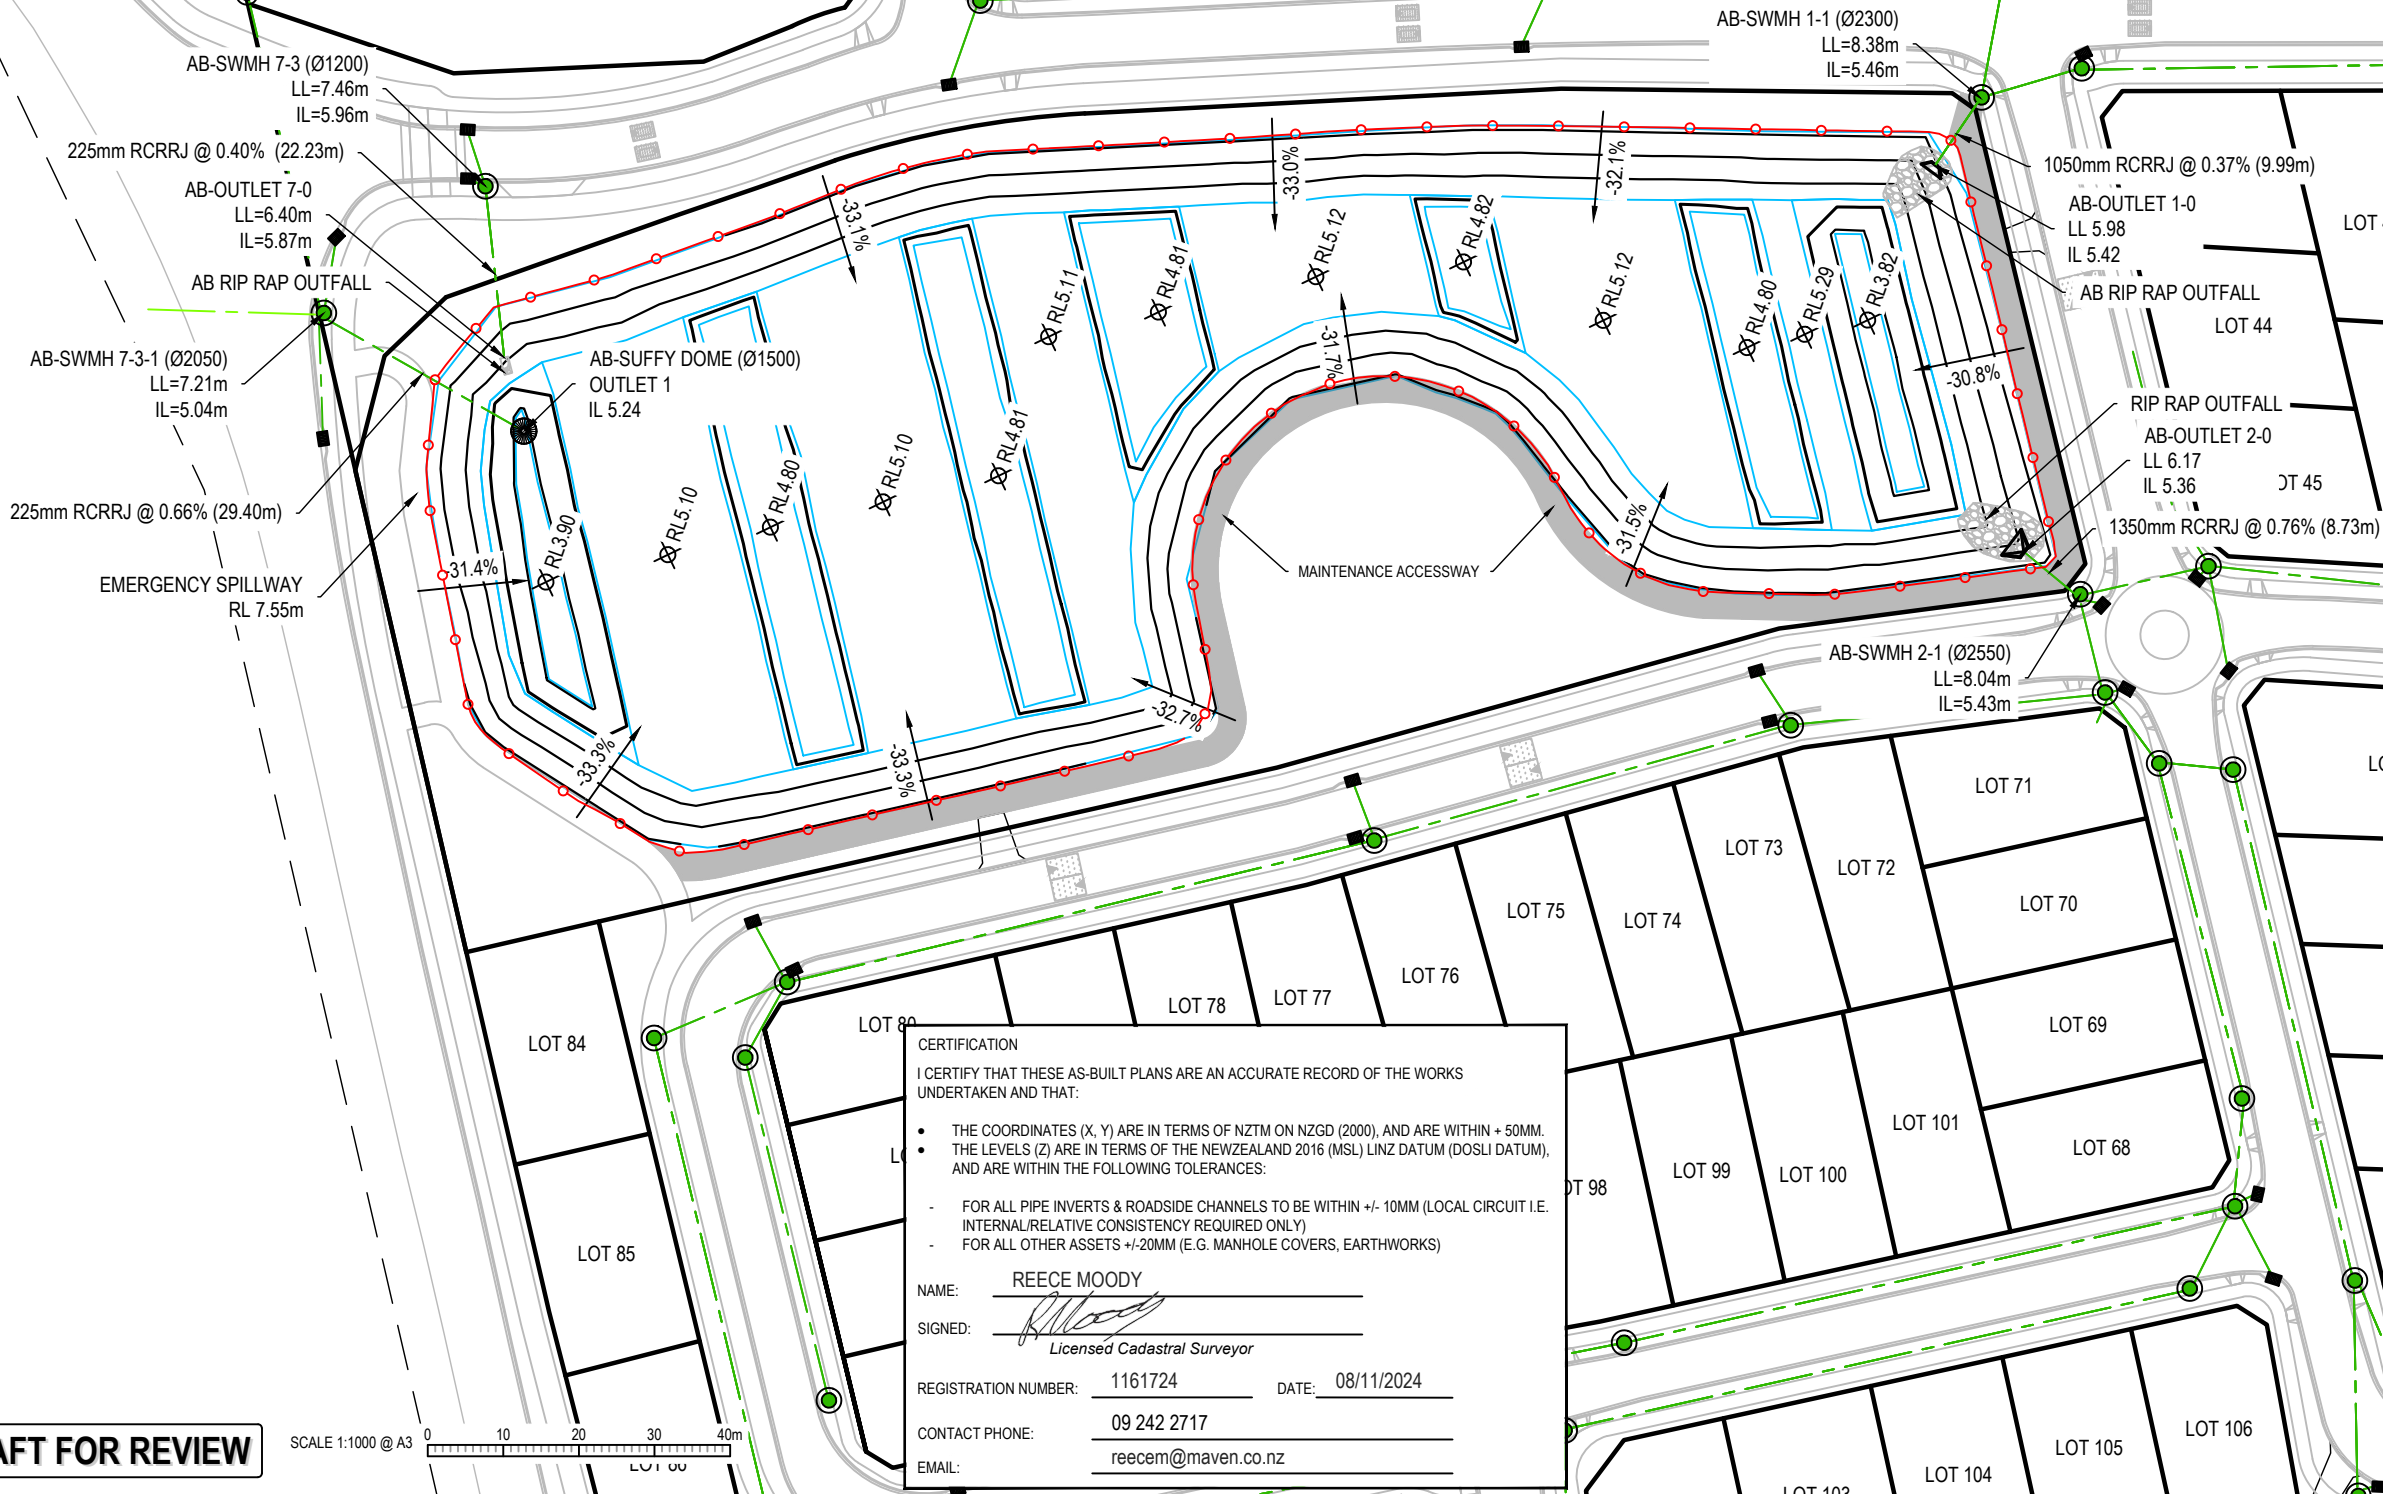

CERTIFICATION

I CERTIFY THAT THESE AS-BUILT PLANS ARE AN ACCURATE RECORD OF THE WORKS UNDERTAKEN AND THAT:

- THE COORDINATES (X, Y) ARE IN TERMS OF NZTM ON NZGD (2000), AND ARE WITHIN + 50MM.
- THE LEVELS (Z) ARE IN TERMS OF THE NEWZEALAND 2016 (MSL) LINZ DATUM (DOSLI DATUM), AND ARE WITHIN THE FOLLOWING TOLERANCES:
- FOR ALL PIPE INVERTS & ROADSIDE CHANNELS TO BE WITHIN +/- 10MM (LOCAL CIRCUIT I.E. INTERNAL/RELATIVE CONSISTENCY REQUIRED ONLY)
- FOR ALL OTHER ASSETS +/-20MM (E.G. MANHOLE COVERS, EARTHWORKS)

NAME: REECE MOODY


SIGNED: *[Signature]*
Licensed Cadastral Surveyor

REGISTRATION NUMBER: 1161724 DATE: 08/11/2024

CONTACT PHONE: 09 242 2717

EMAIL: reecem@maven.co.nz

DRAFT FOR REVIEW

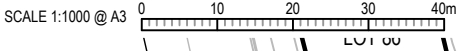

DATE: 11/04/24 FILE PATH: F:\Maven\PROJECTS\60407601-CLEVEDON MEADOWS- C970 WETLAND ASBUILT.DWG