



WATERCARE SERVICES LTD

Network As-built Approval

As-built Number: **COMP-259658**

Engineer: **G. Barlow**

Date: **21/07/2025**

CERTIFICATION

I CERTIFY THAT THESE AS-BUILT PLANS ARE AN ACCURATE RECORD OF THE WORKS UNDERTAKEN AND THAT:

- THE COORDINATES (X, Y) ARE IN TERMS OF NZTM ON NZGD (2000), AND ARE WITHIN + 50MM.
- THE LEVELS (Z) ARE IN TERMS OF THE NEW ZEALAND VERTICAL DATUM 2016 (NZVD16), AND ARE WITHIN THE FOLLOWING TOLERANCES:
 - FOR ALL PIPE INVERTS & ROADSIDE CHANNELS TO BE WITHIN +/- 10MM (LOCAL CIRCUIT I.E. INTERNAL/RELATIVE CONSISTENCY REQUIRED ONLY)
 - FOR ALL OTHER ASSETS +/-20MM (E.G. MANHOLE COVERS, EARTHWORKS)

NAME: **REECE MOODY**

SIGNED: 
Licensed Cadastral Surveyor

REGISTRATION NUMBER: **1161724** DATE: **06/09/2025**

CONTACT PHONE: **09 242 2717**

EMAIL: **reecem@maven.co.nz**

-  STAGE 1 (VESTED)
-  STAGE 2
-  STAGE 3
-  STAGE 4 (FUTURE EPA)

73R MONUMENT ROAD
LOT 2 DP 176480, LOT 2 DP 67978, PT
ALLT 3 PARO WAIROA, LOT 1 DP 67852,
LOT 2 DP 67852, LOT 1 DP 176480

REFER TO STG-2 C901

REFER TO STG-2 C902

REFER TO STG-2 C903

REFER TO STG-2 C904

144 PAPA KURA-CLEVEDON ROAD
LOT 2 DP 142381, LOT 3 DP 142381,
LOT 2 DP 186158

PAPAKURA CLEVEDON ROAD

ASBUILT

NOTES

- ALL WORKS TO BE IN ACCORDANCE WITH AUCKLAND COUNCIL STANDARDS.
- COORDINATES IN TERMS OF THE NEW ZEALAND TRANSVERSE MERACATOR (NZTM) LEVELS IN TERMS OF THE NEW ZEALAND VERTICAL DATUM (NZVD 2016).
- ORIGIN OF LEVELS = RM 5846 SO 58211 PUBLISHED RL=10.31m, SOURCED FROM THE LINZ DIGITAL GEODETIC DATABASE.
- WORKS CARRIED OUT BY DEMPSEY WOOD.
- SURVEY DATA PROVIDED BY DEMPSEY WOOD.
- WORKS COMPLETED IN SEPTEMBER 2024.
- CONSTRUCTED IN ACCORDANCE WITH AUCKLAND COUNCIL STANDARDS.
- ALL ASSETS TO BE CONSIDERED PUBLIC UNLESS SHOWN OTHERWISE.
- EPA NO. ENG60407601. WATERCARE COMP NO. 259658.
- ALL SERVICE LEADS SIZE ARE 25MM DN PE 100 PN12.5.

Legend

- EX BDY
- AB BDY
- STAGE BDY
- EX WATERMAIN
- EX/AB HYDRANT
- AB METER BOX
- EX SLUICE/PEET VALVE
- AB WATERMAIN
- AB SLUICE VALVE
- AB PEET VALVE


D	AS-BUILT	AL	06/2025
C	DRAFT	ML	03/2025
B	DRAFT	ML	03/2025
A	DRAFT	AL	01/2025
Rev	Description	By	Date
	By	Date	
Survey	DEMPSEY WOOD	12/2024	
Design	ML	12/2024	
Drawn	ML	12/2024	
Checked	JD	12/2024	



Project
**62, 78 AND 80 PAPA KURA -
CLEVEDON ROAD,
CLEVEDON, AUCKLAND
FOR CLEVEDON
PROPERTIES LTD**

Title
**ENG60407601 STAGE 2
WATER SUPPLY ASBUILT
OVERVIEW PLAN**

Project no.	194006
Scale	1:3500 @ A3
Cad file	ENG60407601 STG_2 - C960 WATER SUPPLY ASBUILT.DWG
Drawing no.	STG_2 C960
Rev	D

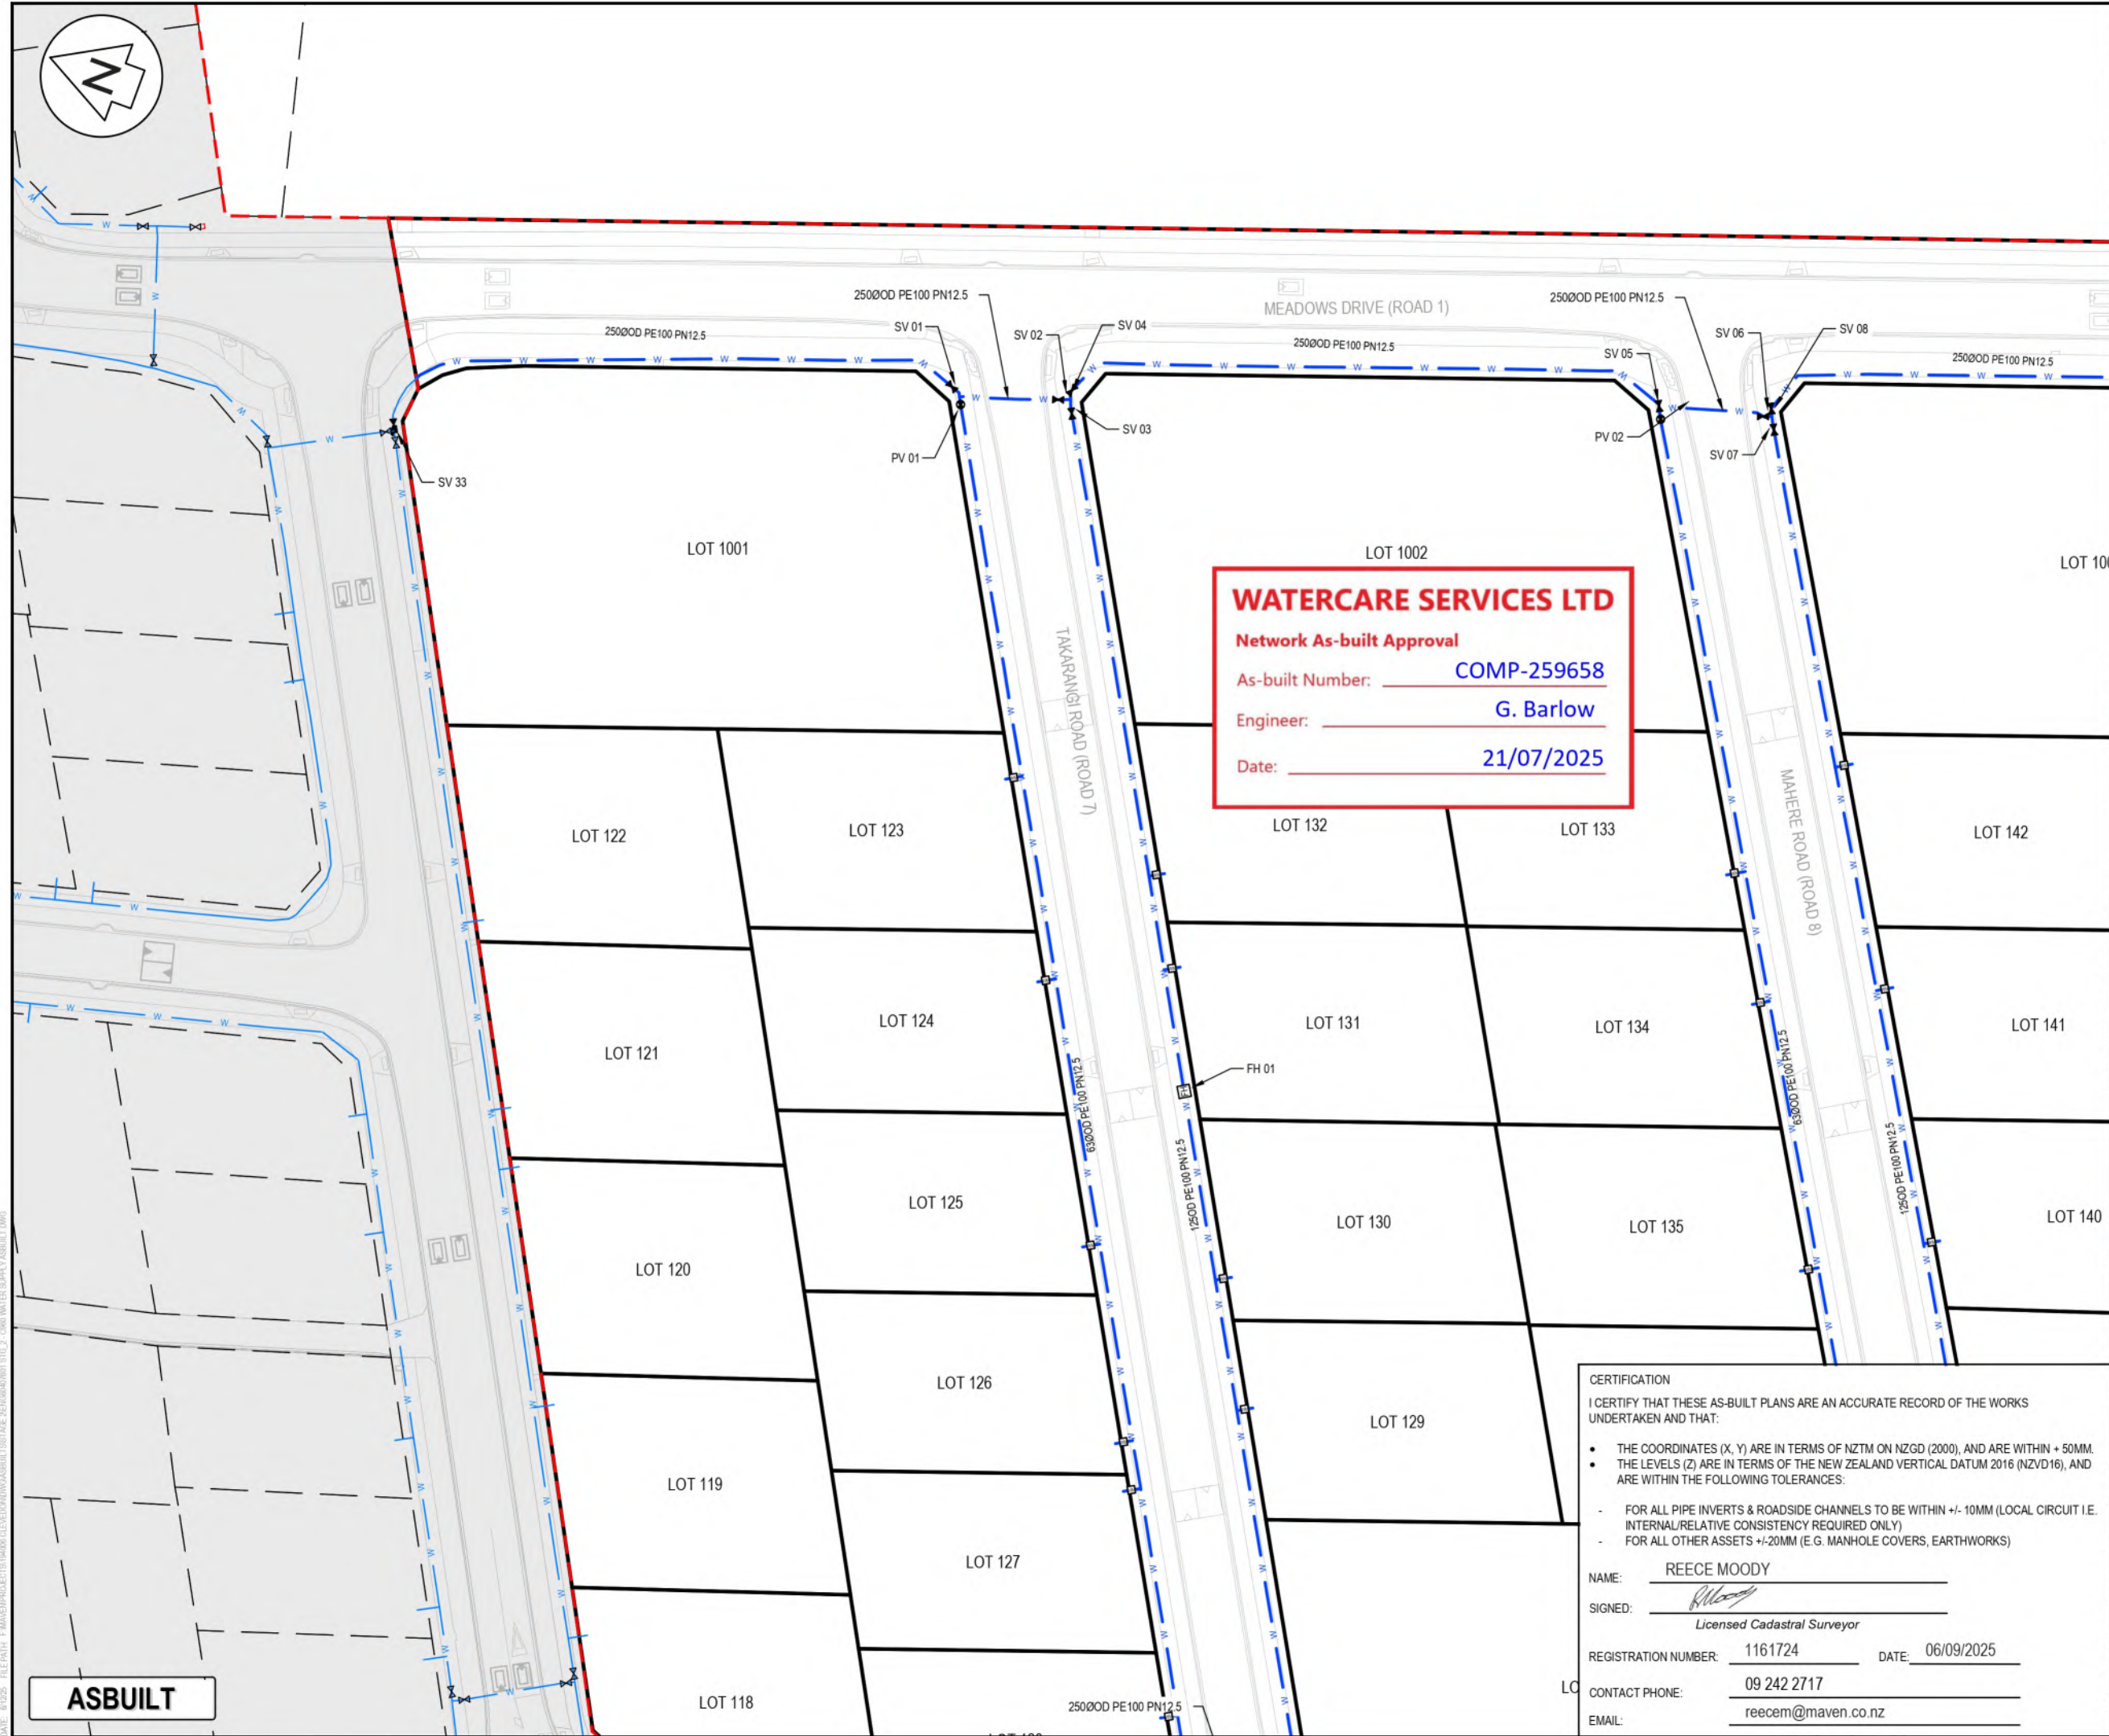

- NOTES
1. ALL WORKS TO BE IN ACCORDANCE WITH AUCKLAND COUNCIL STANDARDS.
 2. COORDINATES IN TERMS OF THE NEW ZEALAND TRANSVERSE MERACATOR (NZTM). LEVELS IN TERMS OF THE NEW ZEALAND VERTICAL DATUM (NZVD 2016).
 3. ORIGIN OF LEVELS = RM 5846 SO 58211 PUBLISHED RL=10.31m, SOURCED FROM THE LINZ DIGITAL GEODETIC DATABASE.
 4. WORKS CARRIED OUT BY DEMPSEY WOOD.
 5. SURVEY DATA PROVIDED BY DEMPSEY WOOD.
 6. WORKS COMPLETED IN SEPTEMBER 2024.
 7. CONSTRUCTED IN ACCORDANCE WITH AUCKLAND COUNCIL STANDARDS.
 8. ALL ASSETS TO BE CONSIDERED PUBLIC UNLESS SHOWN OTHERWISE.
 9. EPA NO. ENG60407601. WATERCARE COMP NO. 259658.
 10. ALL SERVICE LEADS SIZE ARE 25MM DN PE 100 PN12.5.

Legend

---	EX BDY
---	AB BDY
---	STAGE BDY
---	EX WATERMAIN
---	EX/AB HYDRANT
---	AB METER BOX
---	EX SLUICE/PEET VALVE
---	AB WATERMAIN
---	AB SLUICE VALVE
---	AB PEET VALVE

D	AS-BUILT	AL	06/2025
C	DRAFT	ML	03/2025
B	DRAFT	ML	03/2025
A	DRAFT	AL	01/2025
Rev	Description	By	Date
	Survey	DEMPSEY WOOD	12/2024
	Design	ML	12/2024
	Drawn	ML	12/2024
	Checked	JD	12/2024

M **Maven Associates**
09 571 0050
info@maven.co.nz
www.maven.co.nz
5 Owens Road, Epsom
Auckland 1023

Project
**62, 78 AND 80 PAPA KURA -
CLEVEDON ROAD,
CLEVEDON, AUCKLAND
FOR CLEVEDON
PROPERTIES LTD**

Title
**ENG60407601 STAGE 2
WATER SUPPLY ASBUILT
PLAN**

Project no.	194006
Scale	1:750 @ A3
Cad file	ENG60407601 STG_2 - C960 WATER SUPPLY ASBUILT.dwg
Drawing no.	STG_2 C961
Rev	D

WATERCARE SERVICES LTD
Network As-built Approval
As-built Number: **COMP-259658**
Engineer: **G. Barlow**
Date: **21/07/2025**

CERTIFICATION
I CERTIFY THAT THESE AS-BUILT PLANS ARE AN ACCURATE RECORD OF THE WORKS UNDERTAKEN AND THAT:


- THE COORDINATES (X, Y) ARE IN TERMS OF NZTM ON NZGD (2000), AND ARE WITHIN + 50MM.
- THE LEVELS (Z) ARE IN TERMS OF THE NEW ZEALAND VERTICAL DATUM 2016 (NZVD16), AND ARE WITHIN THE FOLLOWING TOLERANCES:

- FOR ALL PIPE INVERTS & ROADSIDE CHANNELS TO BE WITHIN +/- 10MM (LOCAL CIRCUIT I.E. INTERNAL/RELATIVE CONSISTENCY REQUIRED ONLY)
- FOR ALL OTHER ASSETS +/-20MM (E.G. MANHOLE COVERS, EARTHWORKS)

NAME: **REECE MOODY**
SIGNED: *[Signature]*
Registration Number: **1161724** DATE: **06/09/2025**
CONTACT PHONE: **09 242 2717**
EMAIL: **reecem@maven.co.nz**

DATE: 6/2025 FILE PATH: F:\Maven\Projects\62, 78 AND 80 PAPA KURA - CLEVEDON ROAD - C960 WATER SUPPLY ASBUILT.dwg

ASBUILT

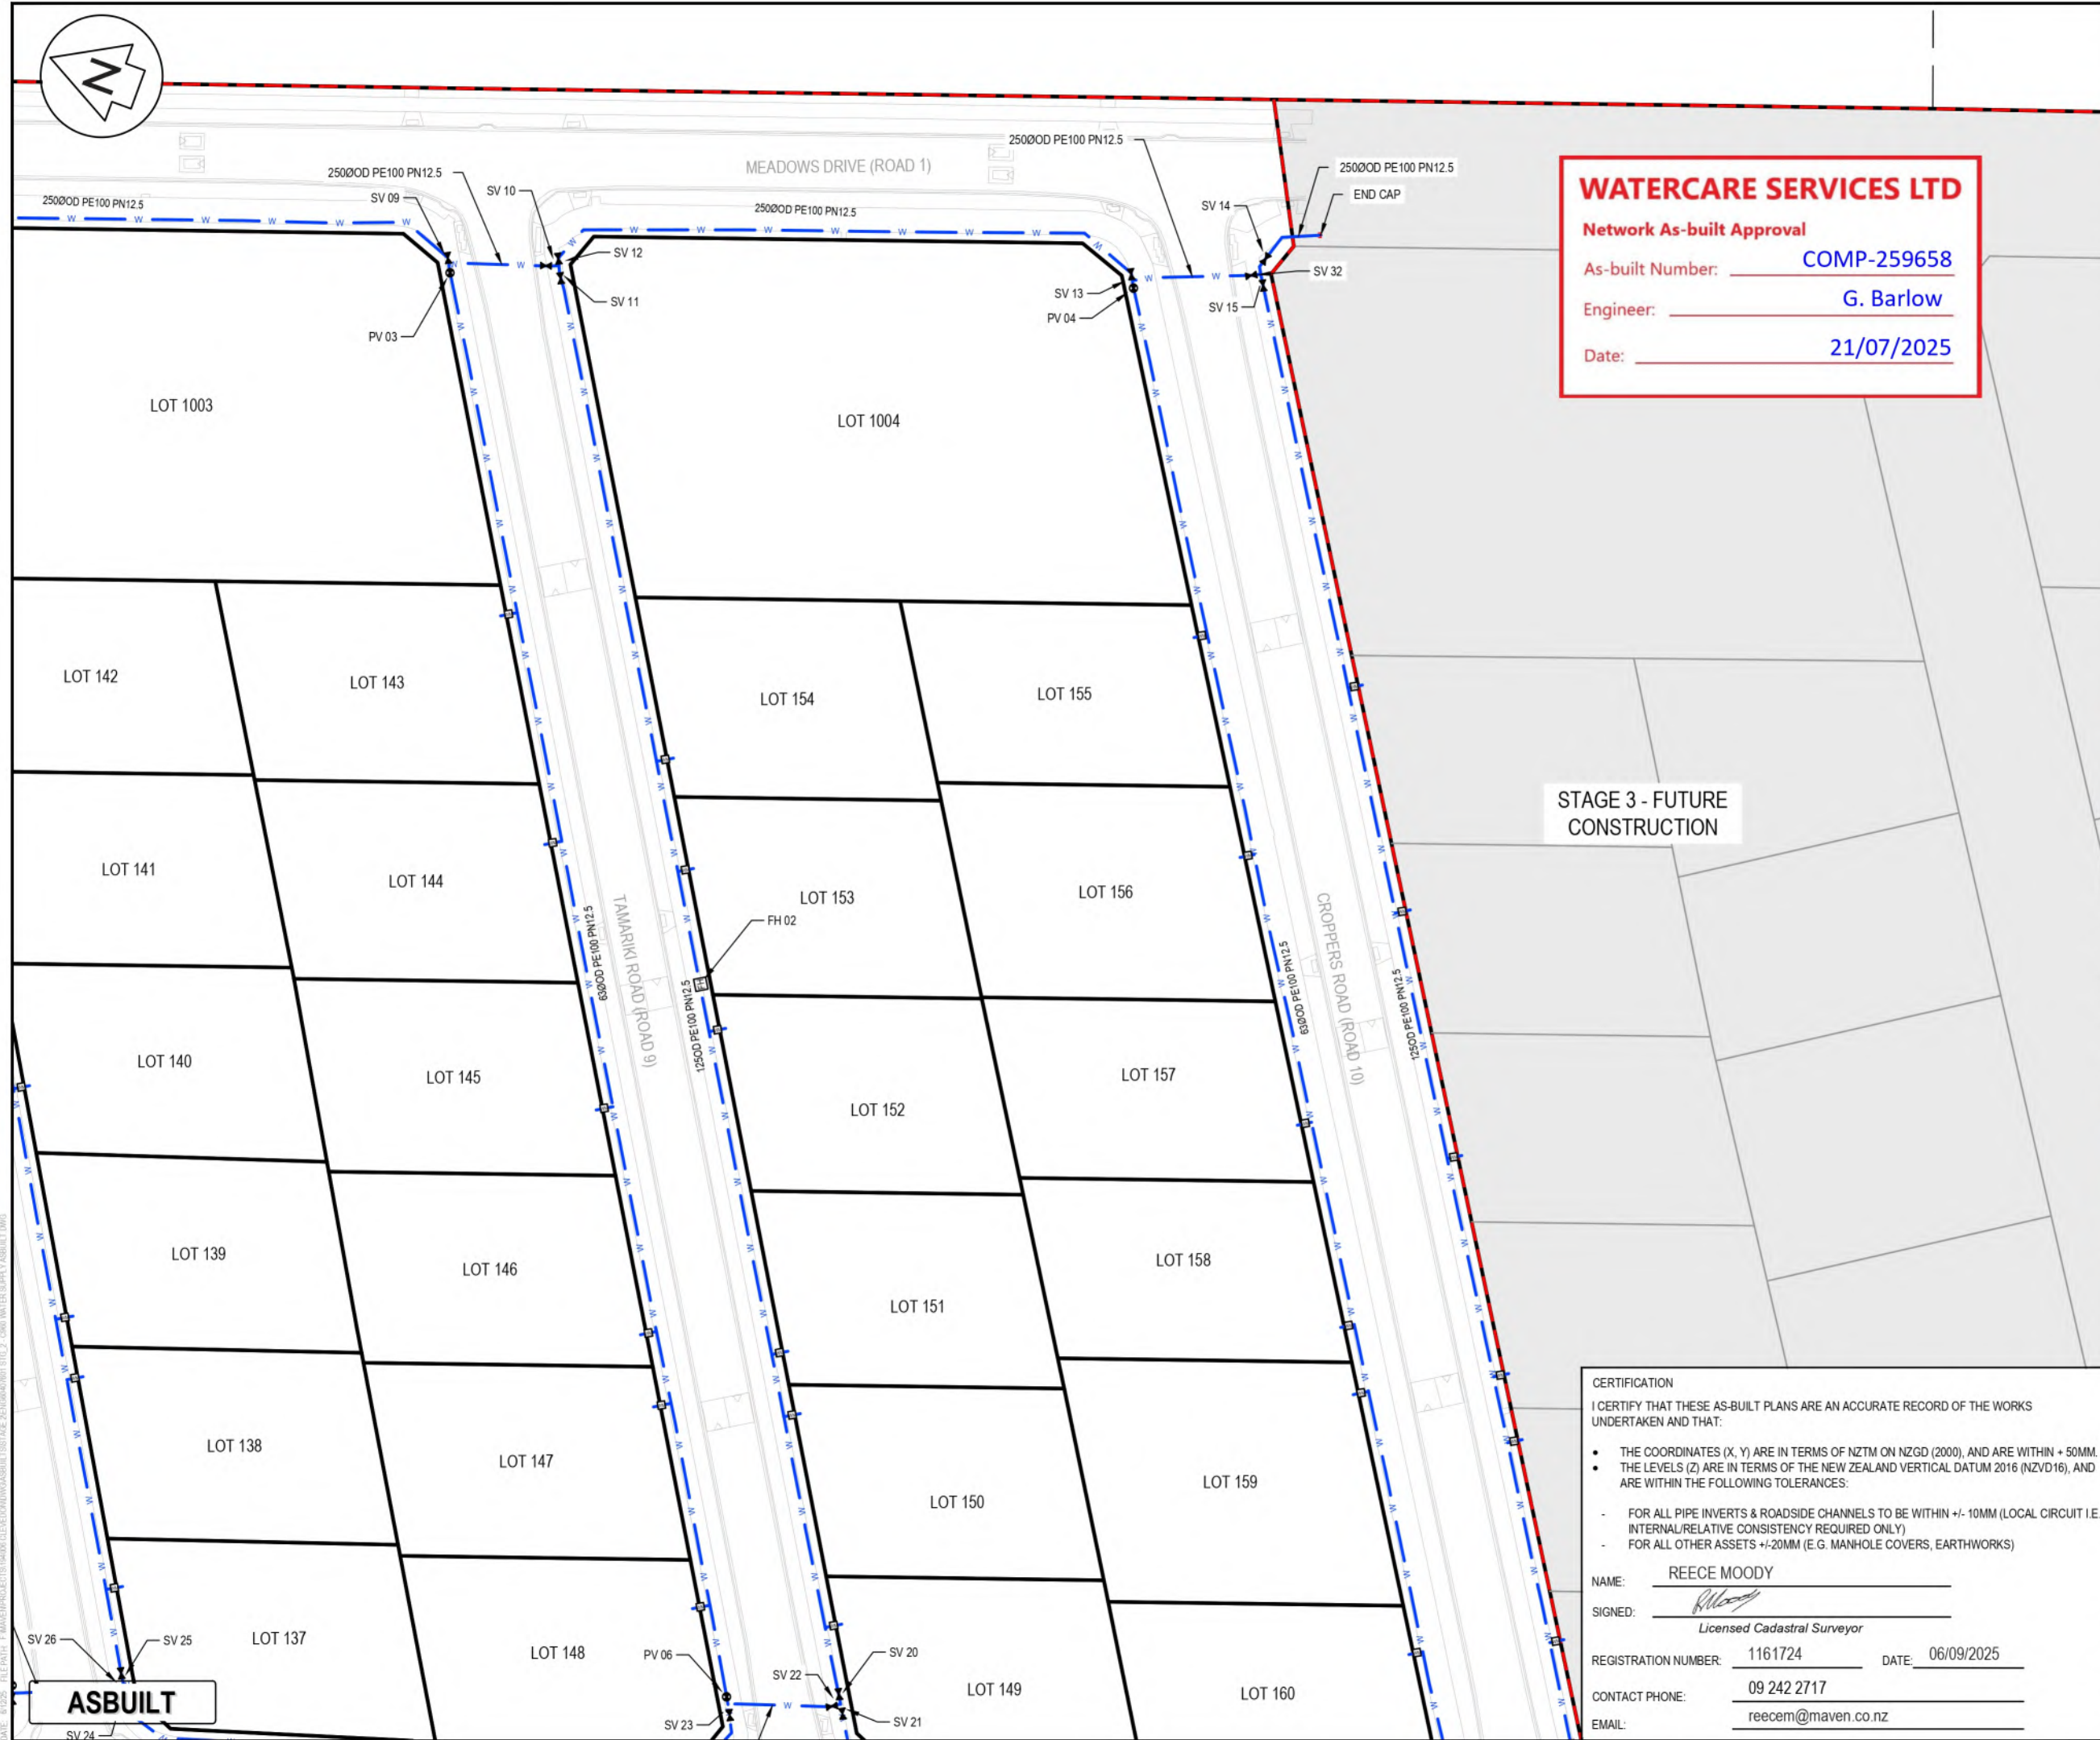

WATERCARE SERVICES LTD
Network As-built Approval

As-built Number: **COMP-259658**

Engineer: **G. Barlow**

Date: **21/07/2025**

NOTES

- ALL WORKS TO BE IN ACCORDANCE WITH AUCKLAND COUNCIL STANDARDS.
- COORDINATES IN TERMS OF THE NEW ZEALAND TRANSVERSE MERACATOR (NZTM). LEVELS IN TERMS OF THE NEW ZEALAND VERTICAL DATUM (NZVD 2016).
- ORIGIN OF LEVELS = RM 5846 SO 58211 PUBLISHED RL=10.31m, SOURCED FROM THE LINZ DIGITAL GEODETIC DATABASE.
- WORKS CARRIED OUT BY DEMPSEY WOOD.
- SURVEY DATA PROVIDED BY DEMPSEY WOOD.
- WORKS COMPLETED IN SEPTEMBER 2024.
- CONSTRUCTED IN ACCORDANCE WITH AUCKLAND COUNCIL STANDARDS.
- ALL ASSETS TO BE CONSIDERED PUBLIC UNLESS SHOWN OTHERWISE.
- EPA NO. ENG60407601. WATERCARE COMP NO 259658.
- ALL SERVICE LEADS SIZE ARE 25MM DN PE 100 PN12.5.

Legend

- EX BDY
- AB BDY
- STAGE BDY
- EX WATERMAIN
- EX/AB HYDRANT
- AB METER BOX
- EX SLUICE/PEET VALVE
- AB WATERMAIN
- AB SLUICE VALVE
- AB PEET VALVE

D	AS-BUILT	AL	06/2025
C	DRAFT	ML	03/2025
B	DRAFT	ML	03/2025
A	DRAFT	AL	01/2025
Rev	Description	By	Date
		By	Date
Survey	DEMPSEY WOOD		12/2024
Design	ML		12/2024
Drawn	ML		12/2024
Checked	JD		12/2024

Maven Associates
09 571 0050
info@maven.co.nz
www.maven.co.nz
5 Owens Road, Epsom
Auckland 1023

Project

62, 78 AND 80 PAPAURA - CLEVEDON ROAD, CLEVEDON, AUCKLAND FOR CLEVEDON PROPERTIES LTD

Title

ENG60407601 STAGE 2 WATER SUPPLY ASBUILT PLAN

Project no.	194006		
Scale	1:750 @ A3		
Cad file	ENG60407601 STG_2 - C960 WATER SUPPLY ASBUILT.DWG		
Drawing no.	STG_2 C962	Rev	D

CERTIFICATION

I CERTIFY THAT THESE AS-BUILT PLANS ARE AN ACCURATE RECORD OF THE WORKS UNDERTAKEN AND THAT:

- THE COORDINATES (X, Y) ARE IN TERMS OF NZTM ON NZGD (2000), AND ARE WITHIN + 50MM.
- THE LEVELS (Z) ARE IN TERMS OF THE NEW ZEALAND VERTICAL DATUM 2016 (NZVD16), AND ARE WITHIN THE FOLLOWING TOLERANCES:
 - FOR ALL PIPE INVERTS & ROADSIDE CHANNELS TO BE WITHIN +/- 10MM (LOCAL CIRCUIT I.E. INTERNAL/RELATIVE CONSISTENCY REQUIRED ONLY)
 - FOR ALL OTHER ASSETS +/-20MM (E.G. MANHOLE COVERS, EARTHWORKS)

NAME: **REECE MOODY**

SIGNED:


Licensed Cadastral Surveyor

REGISTRATION NUMBER: **1161724** DATE: **06/09/2025**

CONTACT PHONE: **09 242 2717**

EMAIL: **reecem@maven.co.nz**

DATE: 6/10/2025 FILE PATH: F:\Maven\Projects\62,78 AND 80 PAPAURA\ASBUILT\STG_2 - C960 WATER SUPPLY ASBUILT.DWG

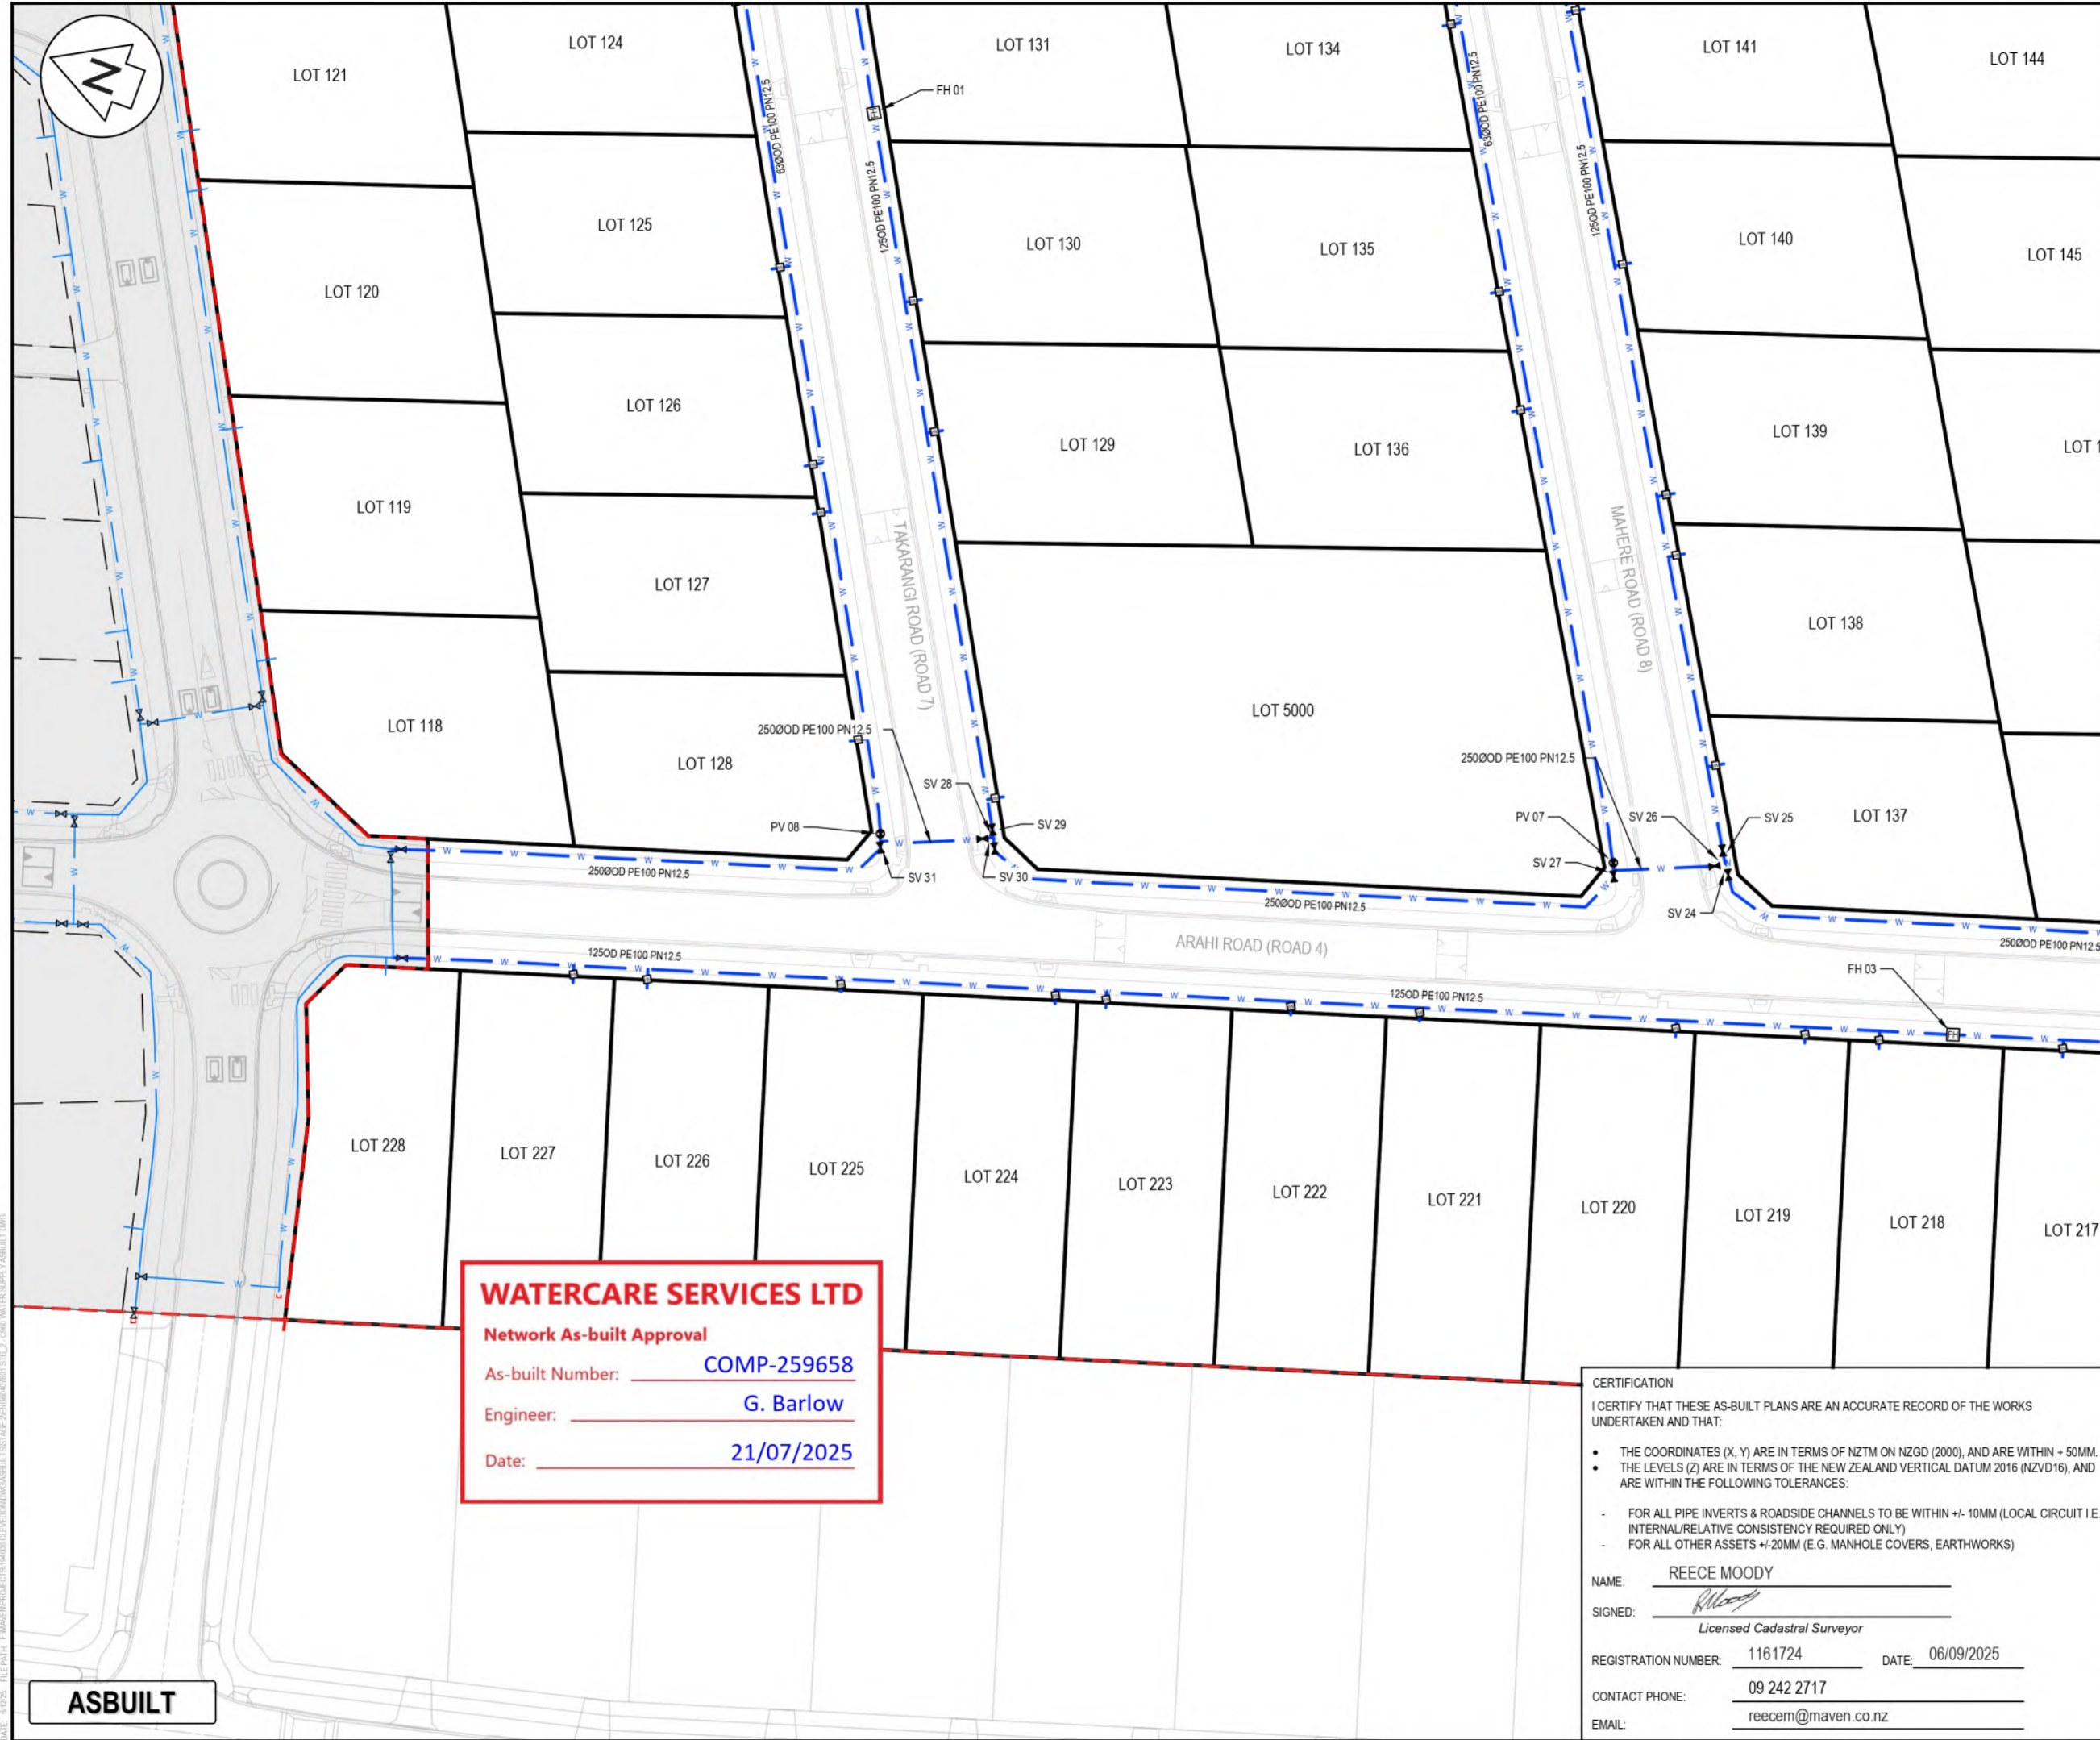

- NOTES
1. ALL WORKS TO BE IN ACCORDANCE WITH AUCKLAND COUNCIL STANDARDS.
 2. COORDINATES IN TERMS OF THE NEW ZEALAND TRANSVERSE MERACATOR (NZTM) LEVELS IN TERMS OF THE NEW ZEALAND VERTICAL DATUM (NZVD 2016).
 3. ORIGIN OF LEVELS = RM 5846 SO 58211 PUBLISHED RL=10.31m, SOURCED FROM THE LINZ DIGITAL GEODETIC DATABASE.
 4. WORKS CARRIED OUT BY DEMPSEY WOOD.
 5. SURVEY DATA PROVIDED BY DEMPSEY WOOD.
 6. WORKS COMPLETED IN SEPTEMBER 2024.
 7. CONSTRUCTED IN ACCORDANCE WITH AUCKLAND COUNCIL STANDARDS.
 8. ALL ASSETS TO BE CONSIDERED PUBLIC UNLESS SHOWN OTHERWISE.
 9. EPA NO. ENG60407601. WATERCARE COMP NO. 259658.
 10. ALL SERVICE LEADS SIZE ARE 25MM DN PE 100 PN12.5.

Legend

---	EX BDY
---	AB BDY
---	STAGE BDY
---	EX WATERMAIN
---	EX/AB HYDRANT
---	AB METER BOX
---	EX SLUICE/PEET VALVE
---	AB WATERMAIN
---	AB SLUICE VALVE
---	AB PEET VALVE

D	AS-BUILT	AL	06/2025
C	DRAFT	ML	03/2025
B	DRAFT	ML	03/2025
A	DRAFT	AL	01/2025
Rev	Description	By	Date
		By	Date
Survey	DEMPSEY WOOD		12/2024
Design	ML		12/2024
Drawn	ML		12/2024
Checked	JD		12/2024



Maven Associates
09 571 0050
info@maven.co.nz
www.maven.co.nz
5 Owens Road, Epsom
Auckland 1023

Project
**62, 78 AND 80 PAPAURA -
CLEVEDON ROAD,
CLEVEDON, AUCKLAND
FOR CLEVEDON
PROPERTIES LTD**

Title
**ENG60407601 STAGE 2
WATER SUPPLY ASBUILT
PLAN**

Project no.	194006
Scale	1:750 @ A3
Cad file	ENG60407601 STG_2 - C960 WATER SUPPLY ASBUILT DWG
Drawing no.	STG_2 C963
Rev	D

WATERCARE SERVICES LTD
Network As-built Approval
As-built Number: **COMP-259658**
Engineer: **G. Barlow**
Date: **21/07/2025**


CERTIFICATION
I CERTIFY THAT THESE AS-BUILT PLANS ARE AN ACCURATE RECORD OF THE WORKS UNDERTAKEN AND THAT:

- THE COORDINATES (X, Y) ARE IN TERMS OF NZTM ON NZGD (2000), AND ARE WITHIN + 50MM.
- THE LEVELS (Z) ARE IN TERMS OF THE NEW ZEALAND VERTICAL DATUM 2016 (NZVD16), AND ARE WITHIN THE FOLLOWING TOLERANCES:
 - FOR ALL PIPE INVERTS & ROADSIDE CHANNELS TO BE WITHIN +/- 10MM (LOCAL CIRCUIT I.E. INTERNAL/RELATIVE CONSISTENCY REQUIRED ONLY)
 - FOR ALL OTHER ASSETS +/-20MM (E.G. MANHOLE COVERS, EARTHWORKS)

NAME: **REECE MOODY**
SIGNED: 
Licensed Cadastral Surveyor
REGISTRATION NUMBER: **1161724** DATE: **06/09/2025**
CONTACT PHONE: **09 242 2717**
EMAIL: **reecem@maven.co.nz**

ASBUILT

DATE: 06/2025 FILE PATH: E:\Maven\Projects\62, 78 AND 80 PAPAURA\ASBUILT\STG_2 - C960 WATER SUPPLY ASBUILT.DWG

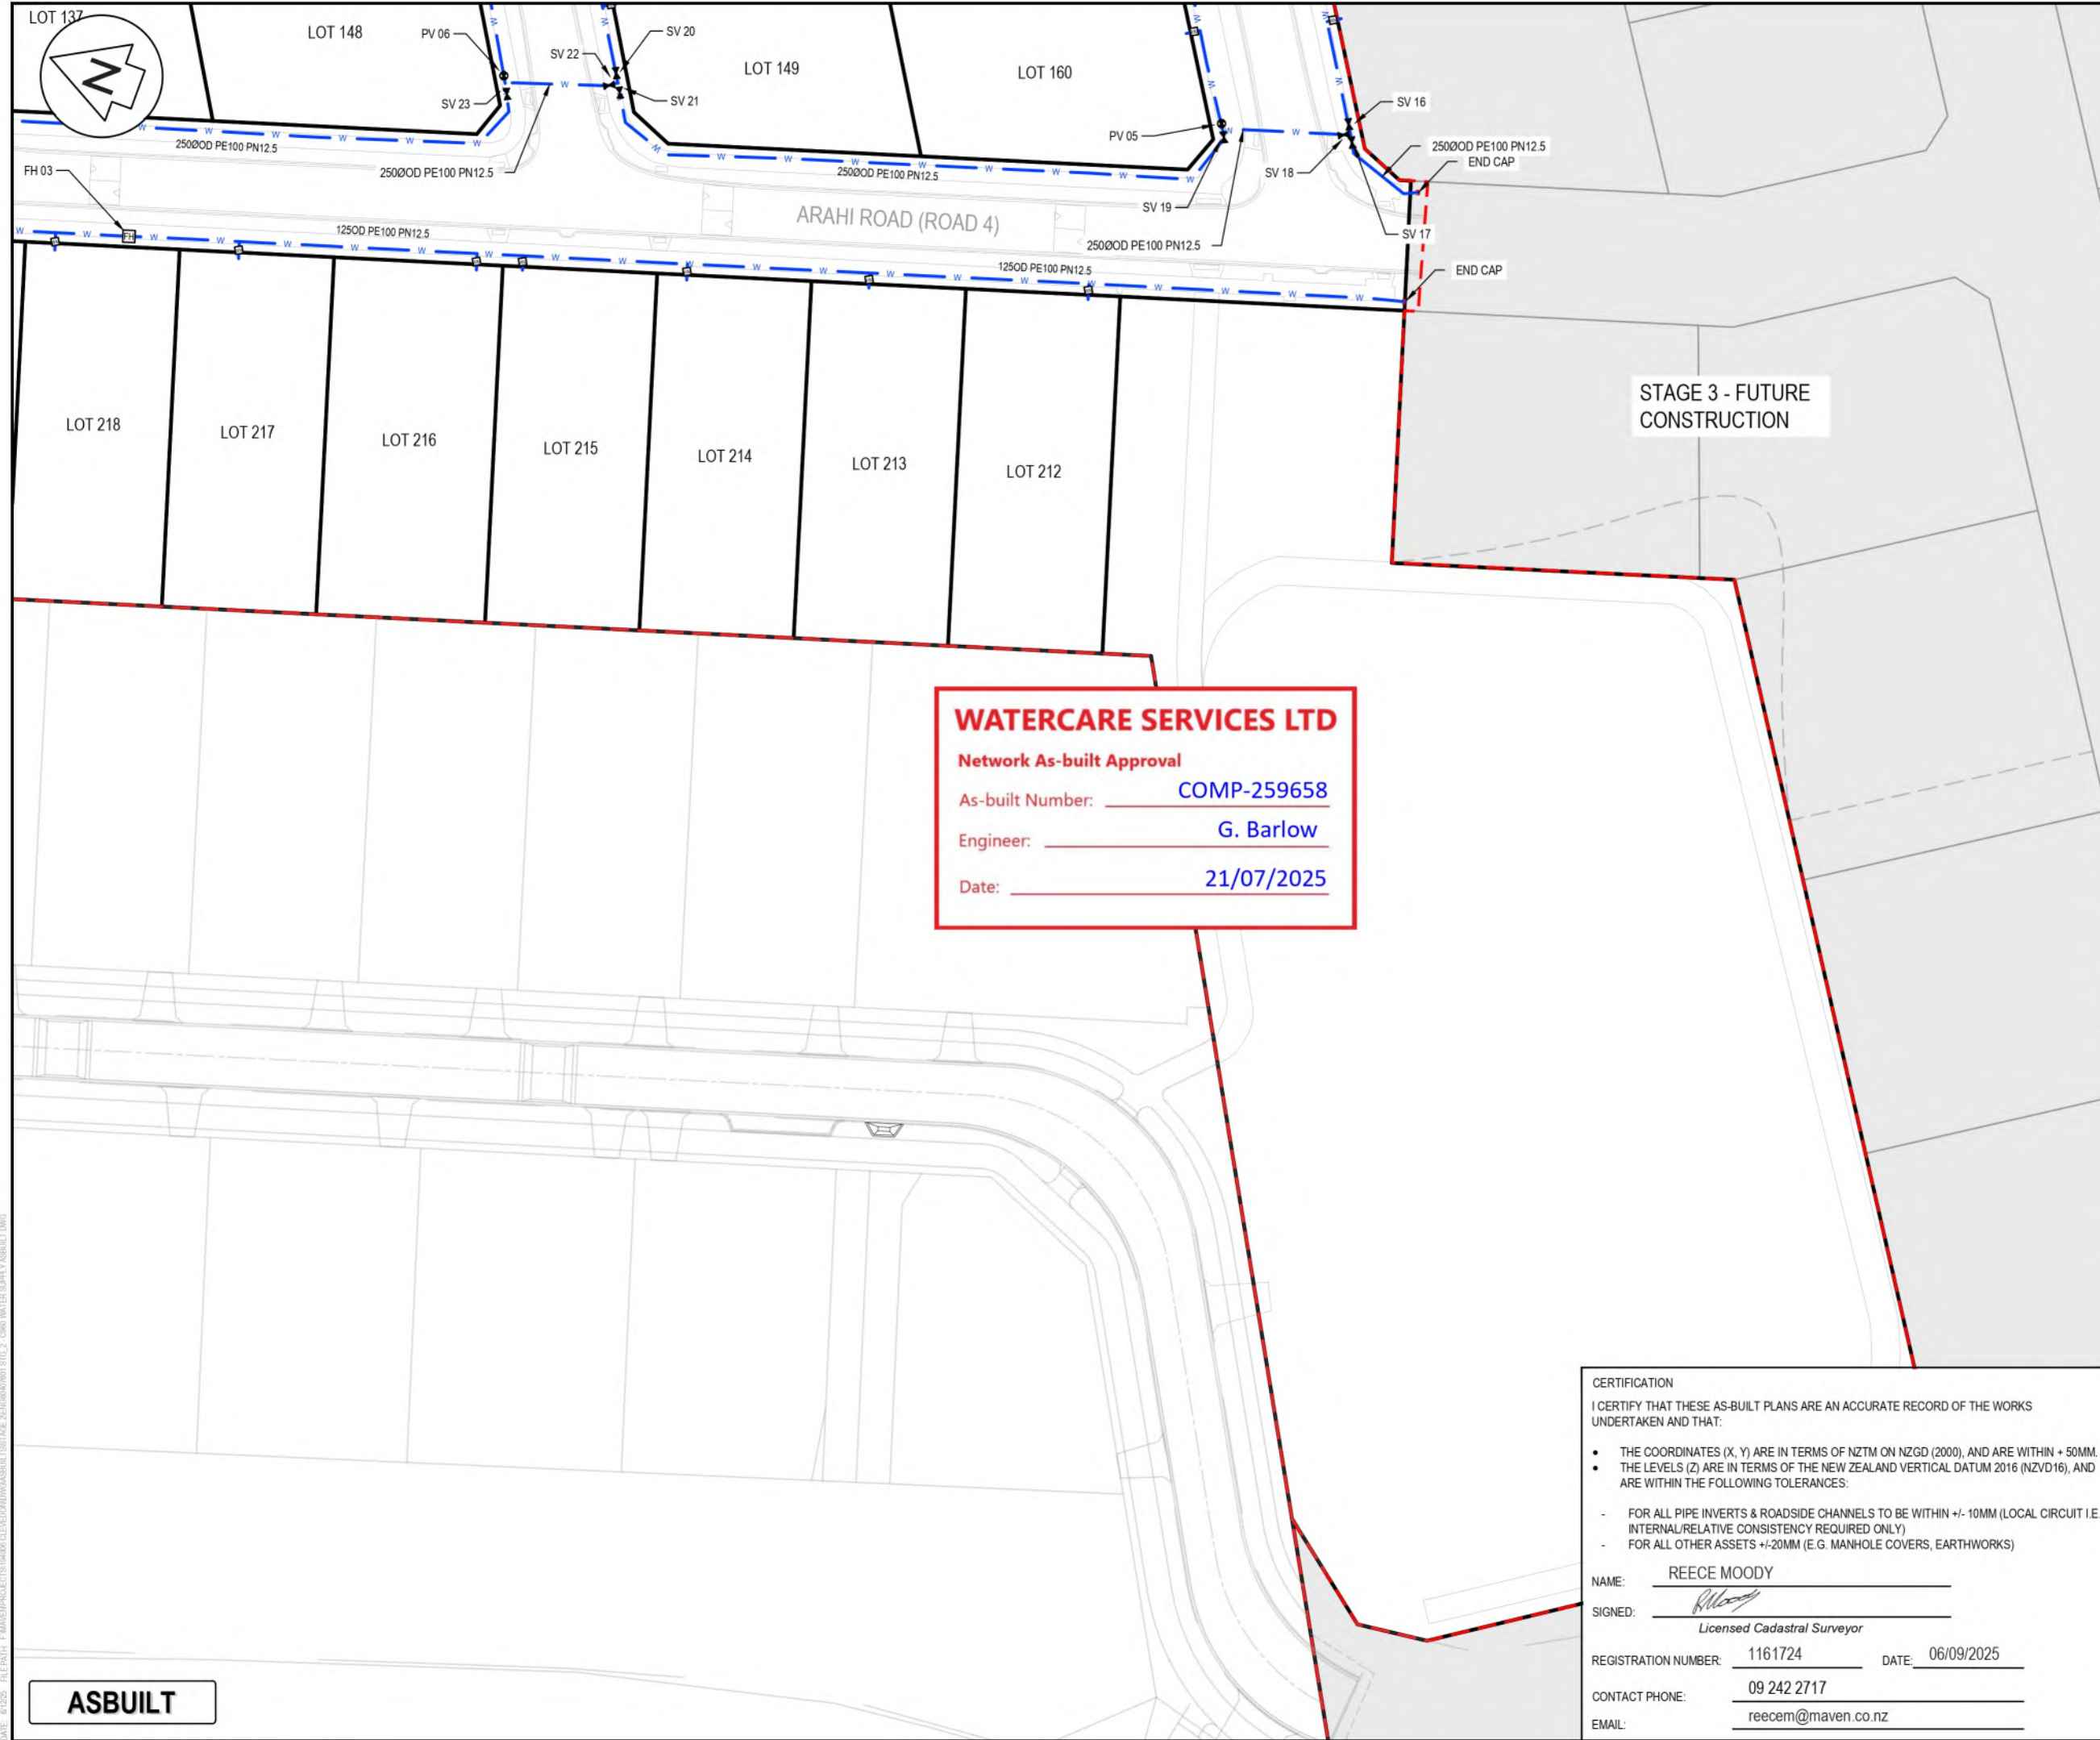

WATERCARE SERVICES LTD

Network As-built Approval

As-built Number: COMP-259658

Engineer: G. Barlow

Date: 21/07/2025

NOTES

1. ALL WORKS TO BE IN ACCORDANCE WITH AUCKLAND COUNCIL STANDARDS.

2. COORDINATES IN TERMS OF THE NEW ZEALAND TRANSVERSE MERACATOR (NZTM), LEVELS IN TERMS OF THE NEW ZEALAND VERTICAL DATUM (NZVD 2016).

4. ORIGIN OF LEVELS = RM 5846 SO 58211 PUBLISHED RL=10.31m, SOURCED FROM THE LINZ DIGITAL GEODETIC DATABASE.

5. WORKS CARRIED OUT BY DEMPSEY WOOD.

6. SURVEY DATA PROVIDED BY DEMPSEY WOOD.

7. WORKS COMPLETED IN SEPTEMBER 2024.

8. CONSTRUCTED IN ACCORDANCE WITH AUCKLAND COUNCIL STANDARDS.

9. ALL ASSETS TO BE CONSIDERED PUBLIC UNLESS SHOWN OTHERWISE.

10. EPA NO. ENG60407601. WATERCARE COMP NO. 259658.

11. ALL SERVICE LEADS SIZE ARE 25MM DN PE 100 PN12.5.

Legend

EX BDY

AB BDY

STAGE BDY

w

w

EX WATERMAIN

FH

MM

EX/AB HYDRANT

⊗

AB METER BOX

⊗

EX SLUICE/PEET VALVE

⊗

AB WATERMAIN

⊗

AB SLUICE VALVE

⊗

AB PEET VALVE

D	AS-BUILT	AL	06/2025
C	DRAFT	ML	03/2025
B	DRAFT	ML	03/2025
A	DRAFT	AL	01/2025
Rev	Description	By	Date
	By	Date	
Survey	DEMPSEY WOOD	12/2024	
Design	ML	12/2024	
Drawn	ML	12/2024	
Checked	JD	12/2024	

M

M A V E N

Maven Associates

09 571 0050

info@maven.co.nz

www.maven.co.nz

5 Owens Road, Epsom

Auckland 1023

Project

62, 78 AND 80 PAPA KURA - CLEVEDON ROAD, CLEVEDON, AUCKLAND FOR CLEVEDON PROPERTIES LTD

Title

ENG60407601 STAGE 2 WATER SUPPLY ASBUILT PLAN

Project no.	194006		
Scale	1:750 @ A3		
Cad file	ENG60407601 STG_2 - C960 WATER SUPPLY ASBUILT DWG		
Drawing no.	STG_2 C964	Rev	D

CERTIFICATION

I CERTIFY THAT THESE AS-BUILT PLANS ARE AN ACCURATE RECORD OF THE WORKS UNDERTAKEN AND THAT:

• THE COORDINATES (X, Y) ARE IN TERMS OF NZTM ON NZGD (2000), AND ARE WITHIN + 50MM.

• THE LEVELS (Z) ARE IN TERMS OF THE NEW ZEALAND VERTICAL DATUM 2016 (NZVD16), AND ARE WITHIN THE FOLLOWING TOLERANCES:

- FOR ALL PIPE INVERTS & ROADSIDE CHANNELS TO BE WITHIN +/- 10MM (LOCAL CIRCUIT I.E. INTERNAL/RELATIVE CONSISTENCY REQUIRED ONLY)

- FOR ALL OTHER ASSETS +/-20MM (E.G. MANHOLE COVERS, EARTHWORKS)

NAME: REECE MOODY

SIGNED:

Licensed Cadastral Surveyor

REGISTRATION NUMBER: 1161724

DATE: 06/09/2025

CONTACT PHONE: 09 242 2717

EMAIL: reecem@maven.co.nz

DATE: 6/10/25, FILE PATH: F:\Maven\Projects\62,78 AND 80 PAPA KURA - CLEVEDON ROAD\ASBUILT\STG_2 - C960 WATER SUPPLY ASBUILT.DWG

DATE: 8/12/25 FILE PATH: F:\WATER\PROJECTS\WAKA WAKA\CLEVEDON\WAKA WAKA STAGE 2\WATER SUPPLY ASBUILT.DWG

ASBUILT

TABLE OF CO-ORDINATES (NZTM)		
Name	Northing	Easting
FH 01	5902953.15mN	1781164.90mE
FH 02	5902786.09mN	1781219.44mE
FH 03	5902789.60mN	1781103.85mE
PV 01	5903008.04mN	1781235.02mE
PV 02	5902923.32mN	1781266.90mE
PV 03	5902844.97mN	1781291.15mE
PV 04	5902765.33mN	1781318.16mE
PV 05	5902668.04mN	1781162.91mE
PV 06	5902753.03mN	1781138.20mE
PV 07	5902836.09mN	1781109.42mE
PV 08	5902922.03mN	1781081.88mE
SV 01	5903009.02mN	1781236.40mE
SV 02	5902995.92mN	1781240.10mE
SV 03	5902995.28mN	1781239.53mE
SV 04	5902995.70mN	1781240.59mE
SV 05	5902926.92mN	1781264.06mE
SV 06	5902913.97mN	1781267.67mE
SV 07	5902913.26mN	1781267.18mE
SV 08	5902913.79mN	1781268.23mE
SV 09	5902845.68mN	1781292.36mE

TABLE OF CO-ORDINATES (NZTM)		
Name	Northing	Easting
SV 10	5902833.10mN	1781296.39mE
SV 11	5902832.41mN	1781295.88mE
SV 12	5902832.90mN	1781296.89mE
SV 13	5902765.94mN	1781319.35mE
SV 14	5902751.31mN	1781327.11mE
SV 15	5902750.88mN	1781324.49mE
SV 16	5902653.12mN	1781167.80mE
SV 17	5902652.54mN	1781166.82mE
SV 18	5902653.07mN	1781166.95mE
SV 19	5902667.40mN	1781161.74mE
SV 20	5902739.98mN	1781142.82mE
SV 21	5902739.38mN	1781141.86mE
SV 22	5902739.90mN	1781141.99mE
SV 23	5902752.37mN	1781137.03mE
SV 24	5902822.94mN	1781113.72mE
SV 25	5902823.57mN	1781114.67mE
SV 26	5902823.44mN	1781113.84mE
SV 27	5902835.58mN	1781108.15mE
SV 28	5902908.65mN	1781085.86mE
SV 29	5902909.21mN	1781086.90mE

TABLE OF CO-ORDINATES (NZTM)		
Name	Northing	Easting
SV 30	5902909.21mN	1781086.09mE
SV 31	5902921.57mN	1781080.65mE
SV 32	5902752.27mN	1781324.59mE
SV 33	5903072.86mN	1781208.78mE

WATERCARE SERVICES LTD
Network As-built Approval
As-built Number: **COMP-259658**
Engineer: **G. Barlow**
Date: **21/07/2025**

CERTIFICATION
I CERTIFY THAT THESE AS-BUILT PLANS ARE AN ACCURATE RECORD OF THE WORKS UNDERTAKEN AND THAT:

- THE COORDINATES (X, Y) ARE IN TERMS OF NZTM ON NZGD (2000), AND ARE WITHIN + 50MM.
- THE LEVELS (Z) ARE IN TERMS OF THE NEW ZEALAND VERTICAL DATUM 2016 (NZVD16), AND ARE WITHIN THE FOLLOWING TOLERANCES:
 - FOR ALL PIPE INVERTS & ROADSIDE CHANNELS TO BE WITHIN +/- 10MM (LOCAL CIRCUIT I.E. INTERNAL/RELATIVE CONSISTENCY REQUIRED ONLY)
 - FOR ALL OTHER ASSETS +/-20MM (E.G. MANHOLE COVERS, EARTHWORKS)

NAME: REECE MOODY
SIGNED: 
Licensed Cadastral Surveyor
REGISTRATION NUMBER: 1161724 DATE: 06/09/2025
CONTACT PHONE: 09 242 2717
EMAIL: reecem@maven.co.nz

- NOTES
- ALL WORKS TO BE IN ACCORDANCE WITH AUCKLAND COUNCIL STANDARDS.
 - COORDINATES IN TERMS OF THE NEW ZEALAND TRANSVERSE MERACATOR (NZTM).LEVELS IN TERMS OF THE NEW ZEALAND VERTICAL DATUM (NZVD 2016).
 - ORIGIN OF LEVELS = RM 5846 SO 58211 PUBLISHED RL=10.31m, SOURCED FROM THE LINZ DIGITAL GEODETIC DATABASE.
 - WORKS CARRIED OUT BY DEMPSEY WOOD.
 - SURVEY DATA PROVIDED BY DEMPSEY WOOD.
 - WORKS COMPLETED IN SEPTEMBER 2024.
 - CONSTRUCTED IN ACCORDANCE WITH AUCKLAND COUNCIL STANDARDS.
 - ALL ASSETS TO BE CONSIDERED PUBLIC UNLESS SHOWN OTHERWISE.
 - EPA NO. ENG60407601. WATERCARE COMP NO.259658.
 - ALL SERVICE LEADS SIZE ARE 25MM DN PE 100 PN12.5.

D	AS-BUILT	AL	06/2025
C	DRAFT	ML	03/2025
B	DRAFT	ML	03/2025
A	DRAFT	AL	01/2025
Rev	Description	By	Date
	By	Date	
Survey	DEMPSEY WOOD	12/2024	
Design	ML	12/2024	
Drawn	ML	12/2024	
Checked	JD	12/2024	

**Maven Associates**
09 571 0050
info@maven.co.nz
www.maven.co.nz
5 Owens Road, Epsom
Auckland 1023

Project
62, 78 AND 80 PAPAKURA - CLEVEDON ROAD, CLEVEDON, AUCKLAND FOR CLEVEDON PROPERTIES LTD

Title
ENG60407601 STAGE 2 WATER SUPPLY ASBUILT TABLE

Project no.	194006		
Scale	1:500 @ A3		
Cad file	ENG60407601 STG_2 - C960 WATER SUPPLY ASBUILT		
Drawing no.	STG_2 C965	Rev	D