

- NOTES
1. ALL WORKS TO BE IN ACCORDANCE WITH AUCKLAND COUNCIL STANDARDS.
 2. COORDINATES IN TERMS OF THE NEW ZEALAND TRANSVERSE MERACATOR 2000 (NZTM).
 3. LEVELS IN TERMS OF THE NEW ZEALAND VERTICAL DATUM 2016 (NZVD 2016).
 4. ORIGIN OF LEVELS = RM 5846 SO 58211(BB2R) PUBLISHED RL=10.31, SOURCED FROM THE LINZ DIGITAL GEODETIC DATABASE.

- STAGE 1
- STAGE 2
- STAGE 3
- STAGE 4

- Legend
- EX BDY
- AB BDY
- STAGE BDY
- AB 1wM MICRONET
- AB 1wR RIBBONET
- AB 7wM MICRONET
- AB 12wR RIBBONET
- AB 26wR RIBBONET
- TELECOM TUD
- CHORUS PIT

A	ASBUILT	HL	01/2025
Rev	Description	By	Date
		By	Date
Survey	DEMPSEY WOOD		12/2024
Design	ML		12/2024
Drawn	ML		12/2024
Checked	JD		12/2024



Project

62, 78 AND 80 PAKAKURA - CLEVEDON ROAD, CLEVEDON, AUCKLAND FOR CLEVEDON PROPERTIES LTD

Title

ENG60407601 STAGE 2 COMMS ASBUILT OVERVIEW PLAN

Project no.	194006		
Scale	1:3500 @ A3		
Cad file	ENG60407601 STG 2 - C980 COMMS ASBUILT.DWG		
Drawing no.	STG_2 C980	Rev	A

73R MONUMENT ROAD
LOT 2 DP 176480, LOT 2 DP 67978, PT
ALLT 3 PARO WAIROA, LOT 1 DP 67852,
LOT 2 DP 67852, LOT 1 DP 176480

REFER TO STG-2 C981

REFER TO STG-2 C982

REFER TO STG-2 C983


REFER TO STG-2 C984

144 PAKAKURA-CLEVEDON ROAD
LOT 2 DP 142381, LOT 3 DP 142381,
LOT 2 DP 186158


PAKAKURA CLEVEDON ROAD

ASBUILT

DATE: 5/2/25 FILE PATH: I:\MAVEN\PROJECTS\194006 CLEVEDON\DRAWINGS\STAGE 2 - C980 COMMS ASBUILT.DWG

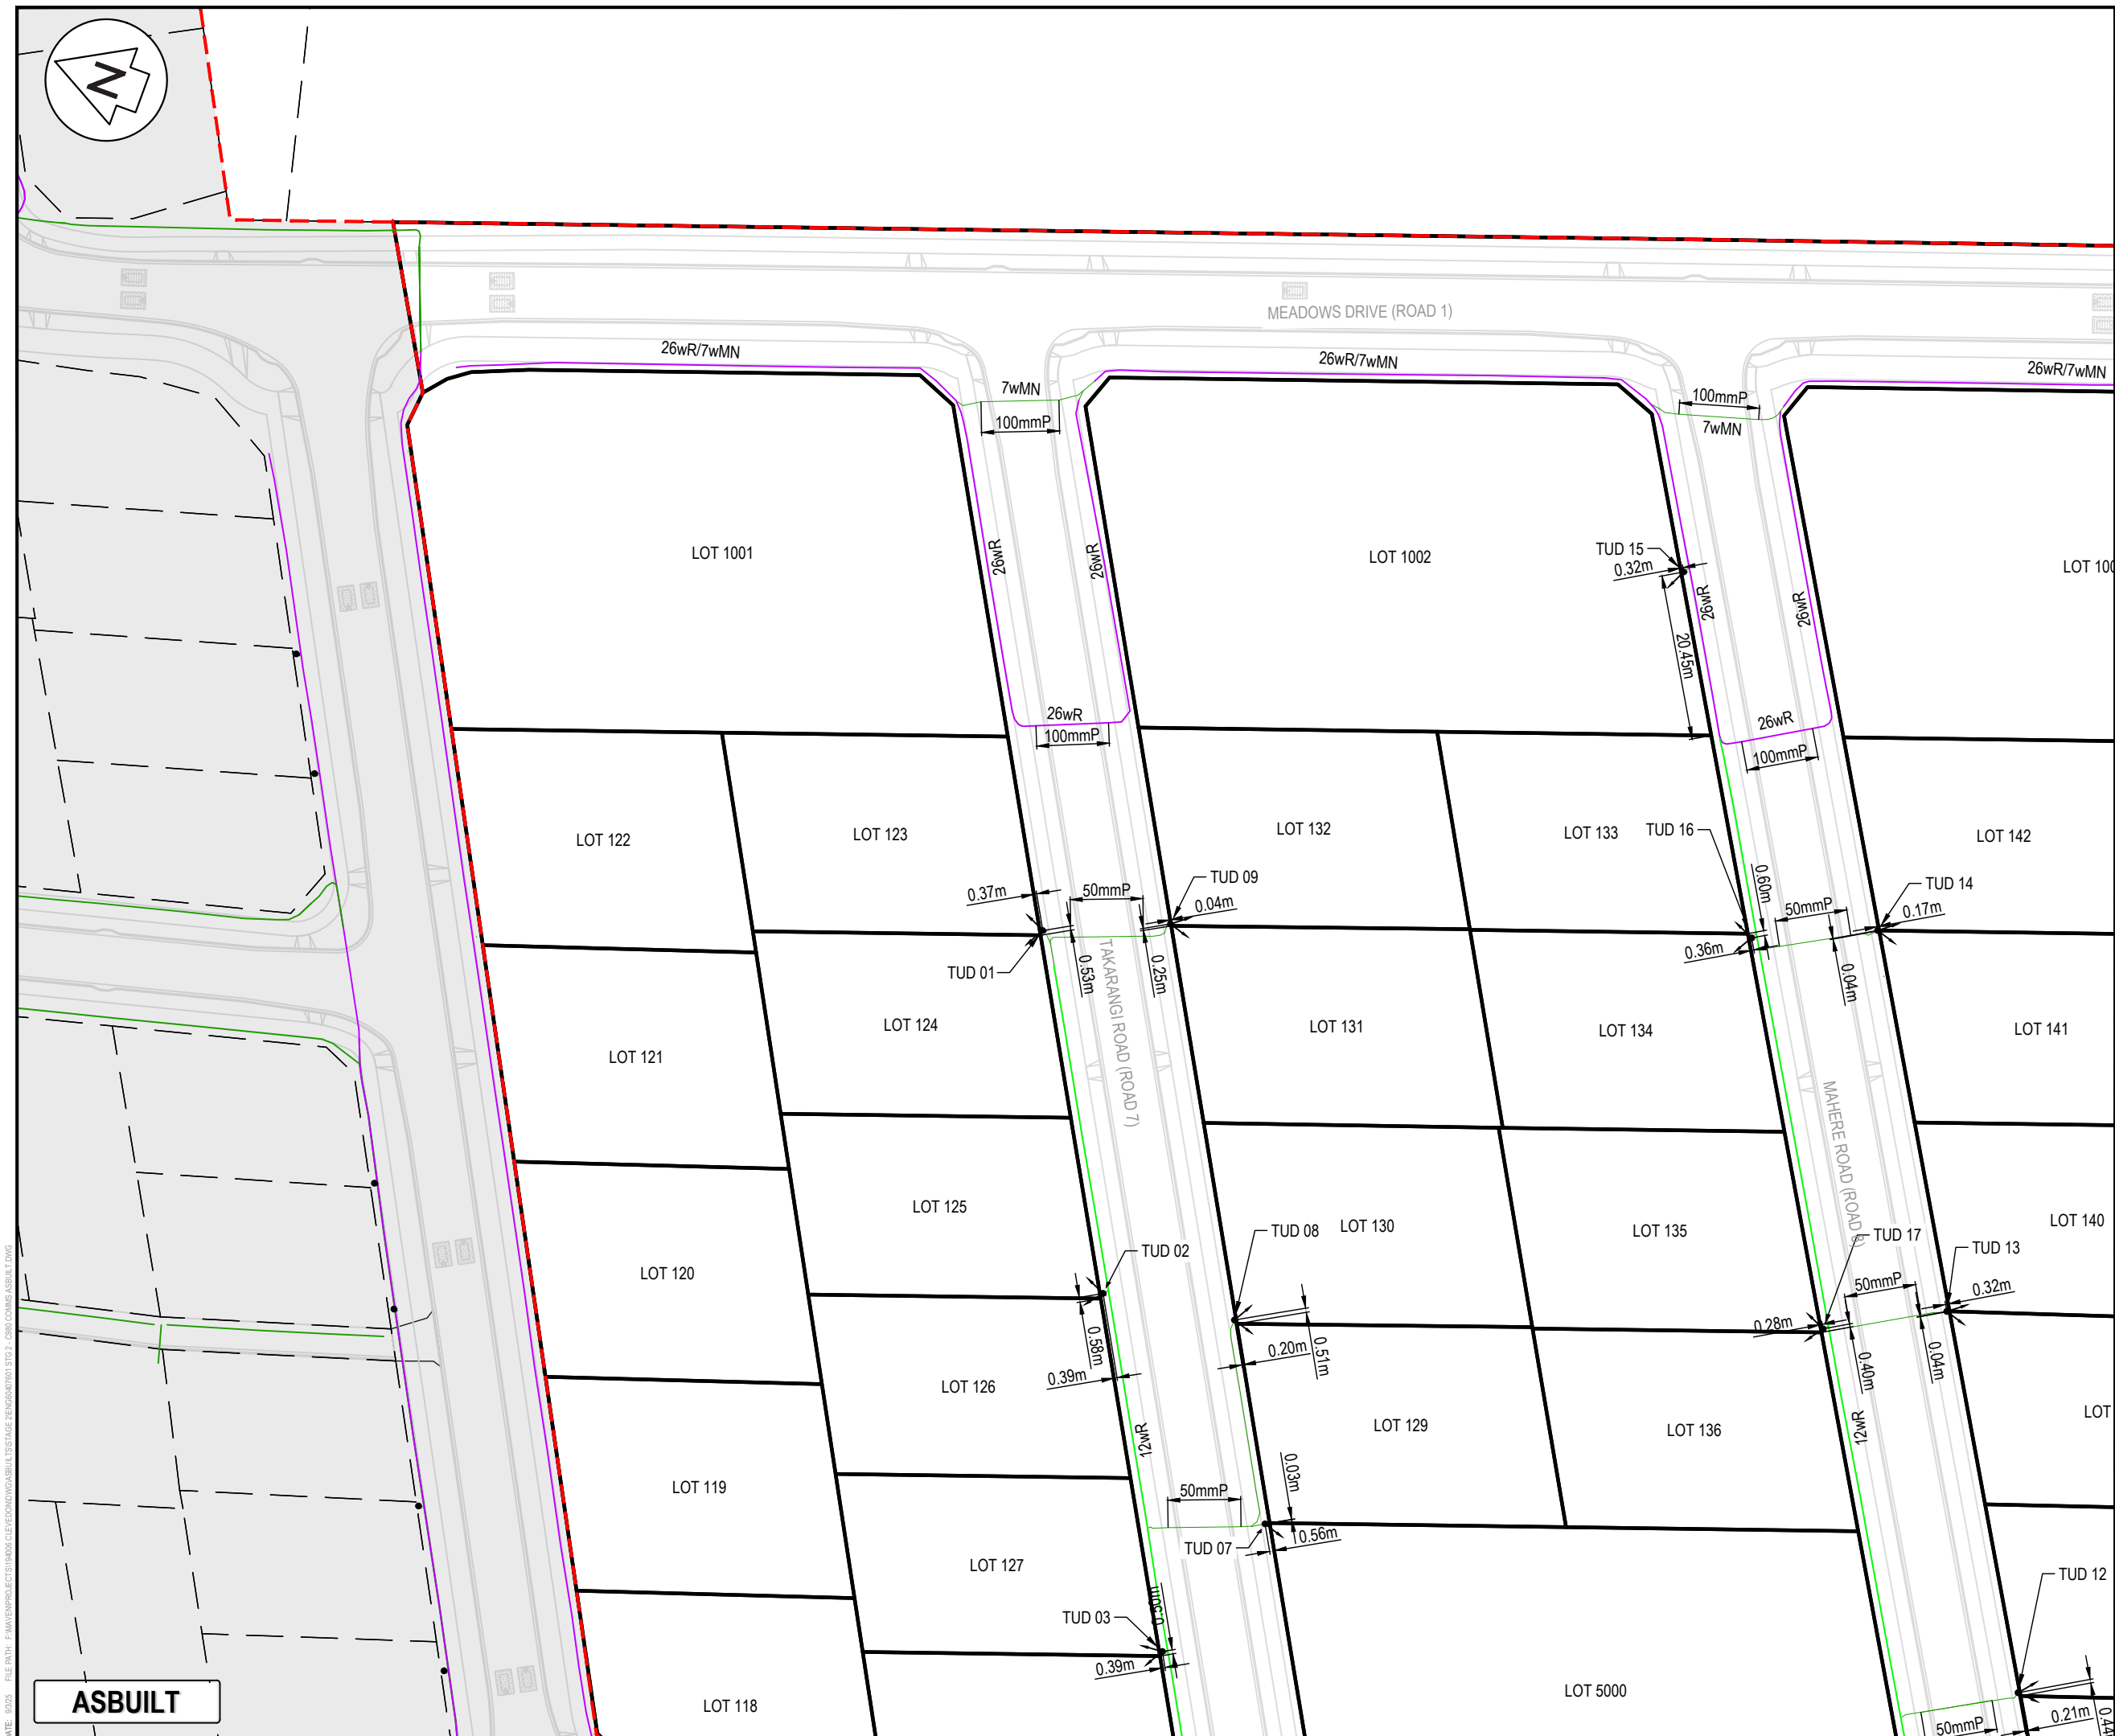


- NOTES

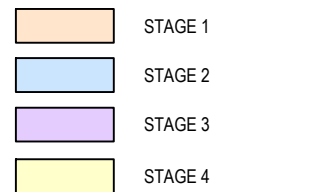

A	ASBUILT	HL	01/2024
Rev	Description	By	Date
	By	Date	
Survey	DEMPSEY WOOD	12/2024	
Design	ML	12/2024	
Drawn	ML	12/2024	
Checked	JD	12/2024	

Project
**62, 78 AND 80 PAPAKURA
CLEVEDON ROAD,
CLEVEDON, AUCKLAND
FOR CLEVEDON
PROPERTIES LTD**

Project no.	194006		
Scale	1:750 @ A3		
Cad file	ENG60407601 STG 2 - C980 COMMS ASBUILT.DWG		
Drawing no.	STG_2 C981	Rev	A

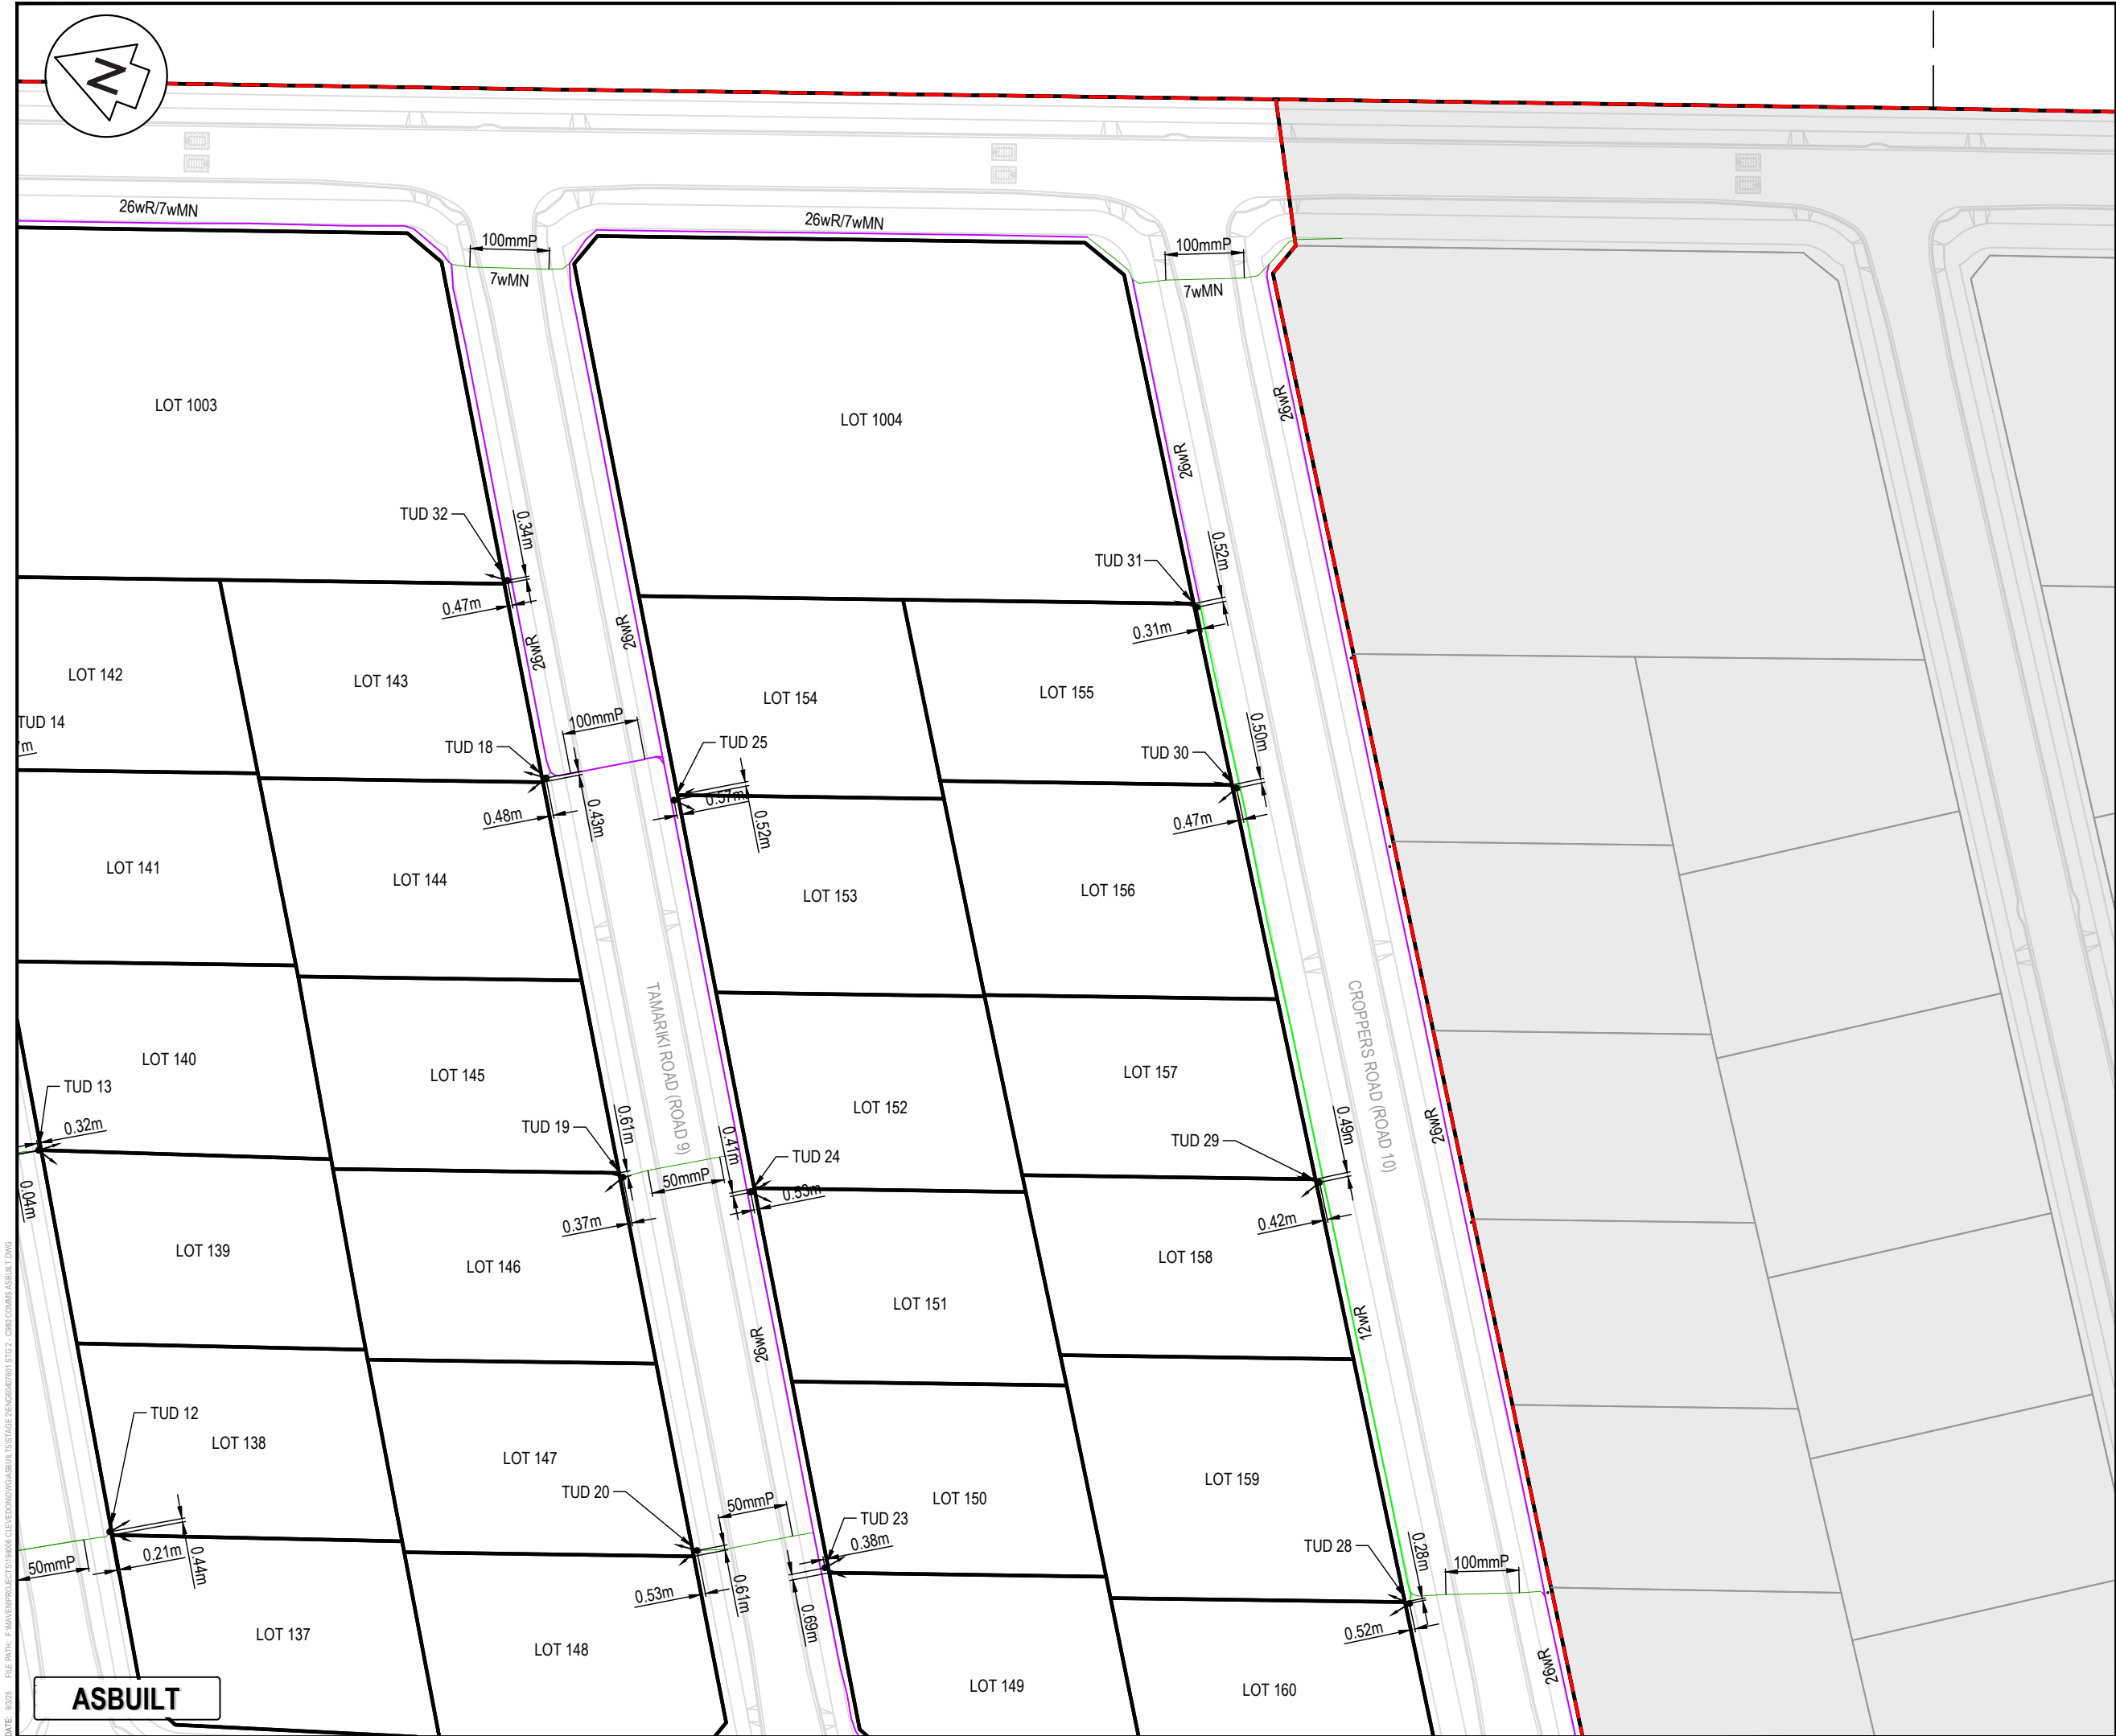

NOTES

- ALL WORKS TO BE IN ACCORDANCE WITH AUCKLAND COUNCIL STANDARDS.
- COORDINATES IN TERMS OF THE NEW ZEALAND TRANSVERSE MERACATOR 2000 (NZTM).
- LEVELS IN TERMS OF THE NEW ZEALAND VERTICAL DATUM 2016 (NZVD 2016).
- ORIGIN OF LEVELS = RM 5846 SO 58211(BB2R) PUBLISHED RL=10.31, SOURCED FROM THE LINZ DIGITAL GEODETIC DATABASE.

Legend

- EX BDY
- AB BDY
- STAGE BDY
- AB 1wM MICRONET
- AB 1wR RIBBONET
- AB 7wM MICRONET
- AB 12wR RIBBONET
- AB 26wR RIBBONET
- TELECOM TUD
- CHORUS PIT

A	ASBUILT	HL	01/2025
Rev	Description	By	Date
		By	Date
Survey	DEMPSEY WOOD		12/2024
Design	ML		12/2024
Drawn	ML		12/2024
Checked	JD		12/2024


M **Maven Associates**
09 571 0050
info@maven.co.nz
www.maven.co.nz
5 Owens Road, Epsom
Auckland 1023

Project
**62, 78 AND 80 PAKAPURA -
CLEVEDON ROAD,
CLEVEDON, AUCKLAND
FOR CLEVEDON
PROPERTIES LTD**

Title
**ENG60407601 STAGE 2
COMMS ASBUILT
PLAN**

Project no.	194006
Scale	1:750 @ A3
Cad file	ENG60407601 STG 2 - C980 COMMS ASBUILT.DWG
Drawing no.	STG_2 C982
Rev	A

DATE: 01/2025 FILE PATH: P:\Maven\PROJECTS\194006 CLEVEDON\DRAWINGS\194006 STG 2 - C980 COMMS ASBUILT.DWG

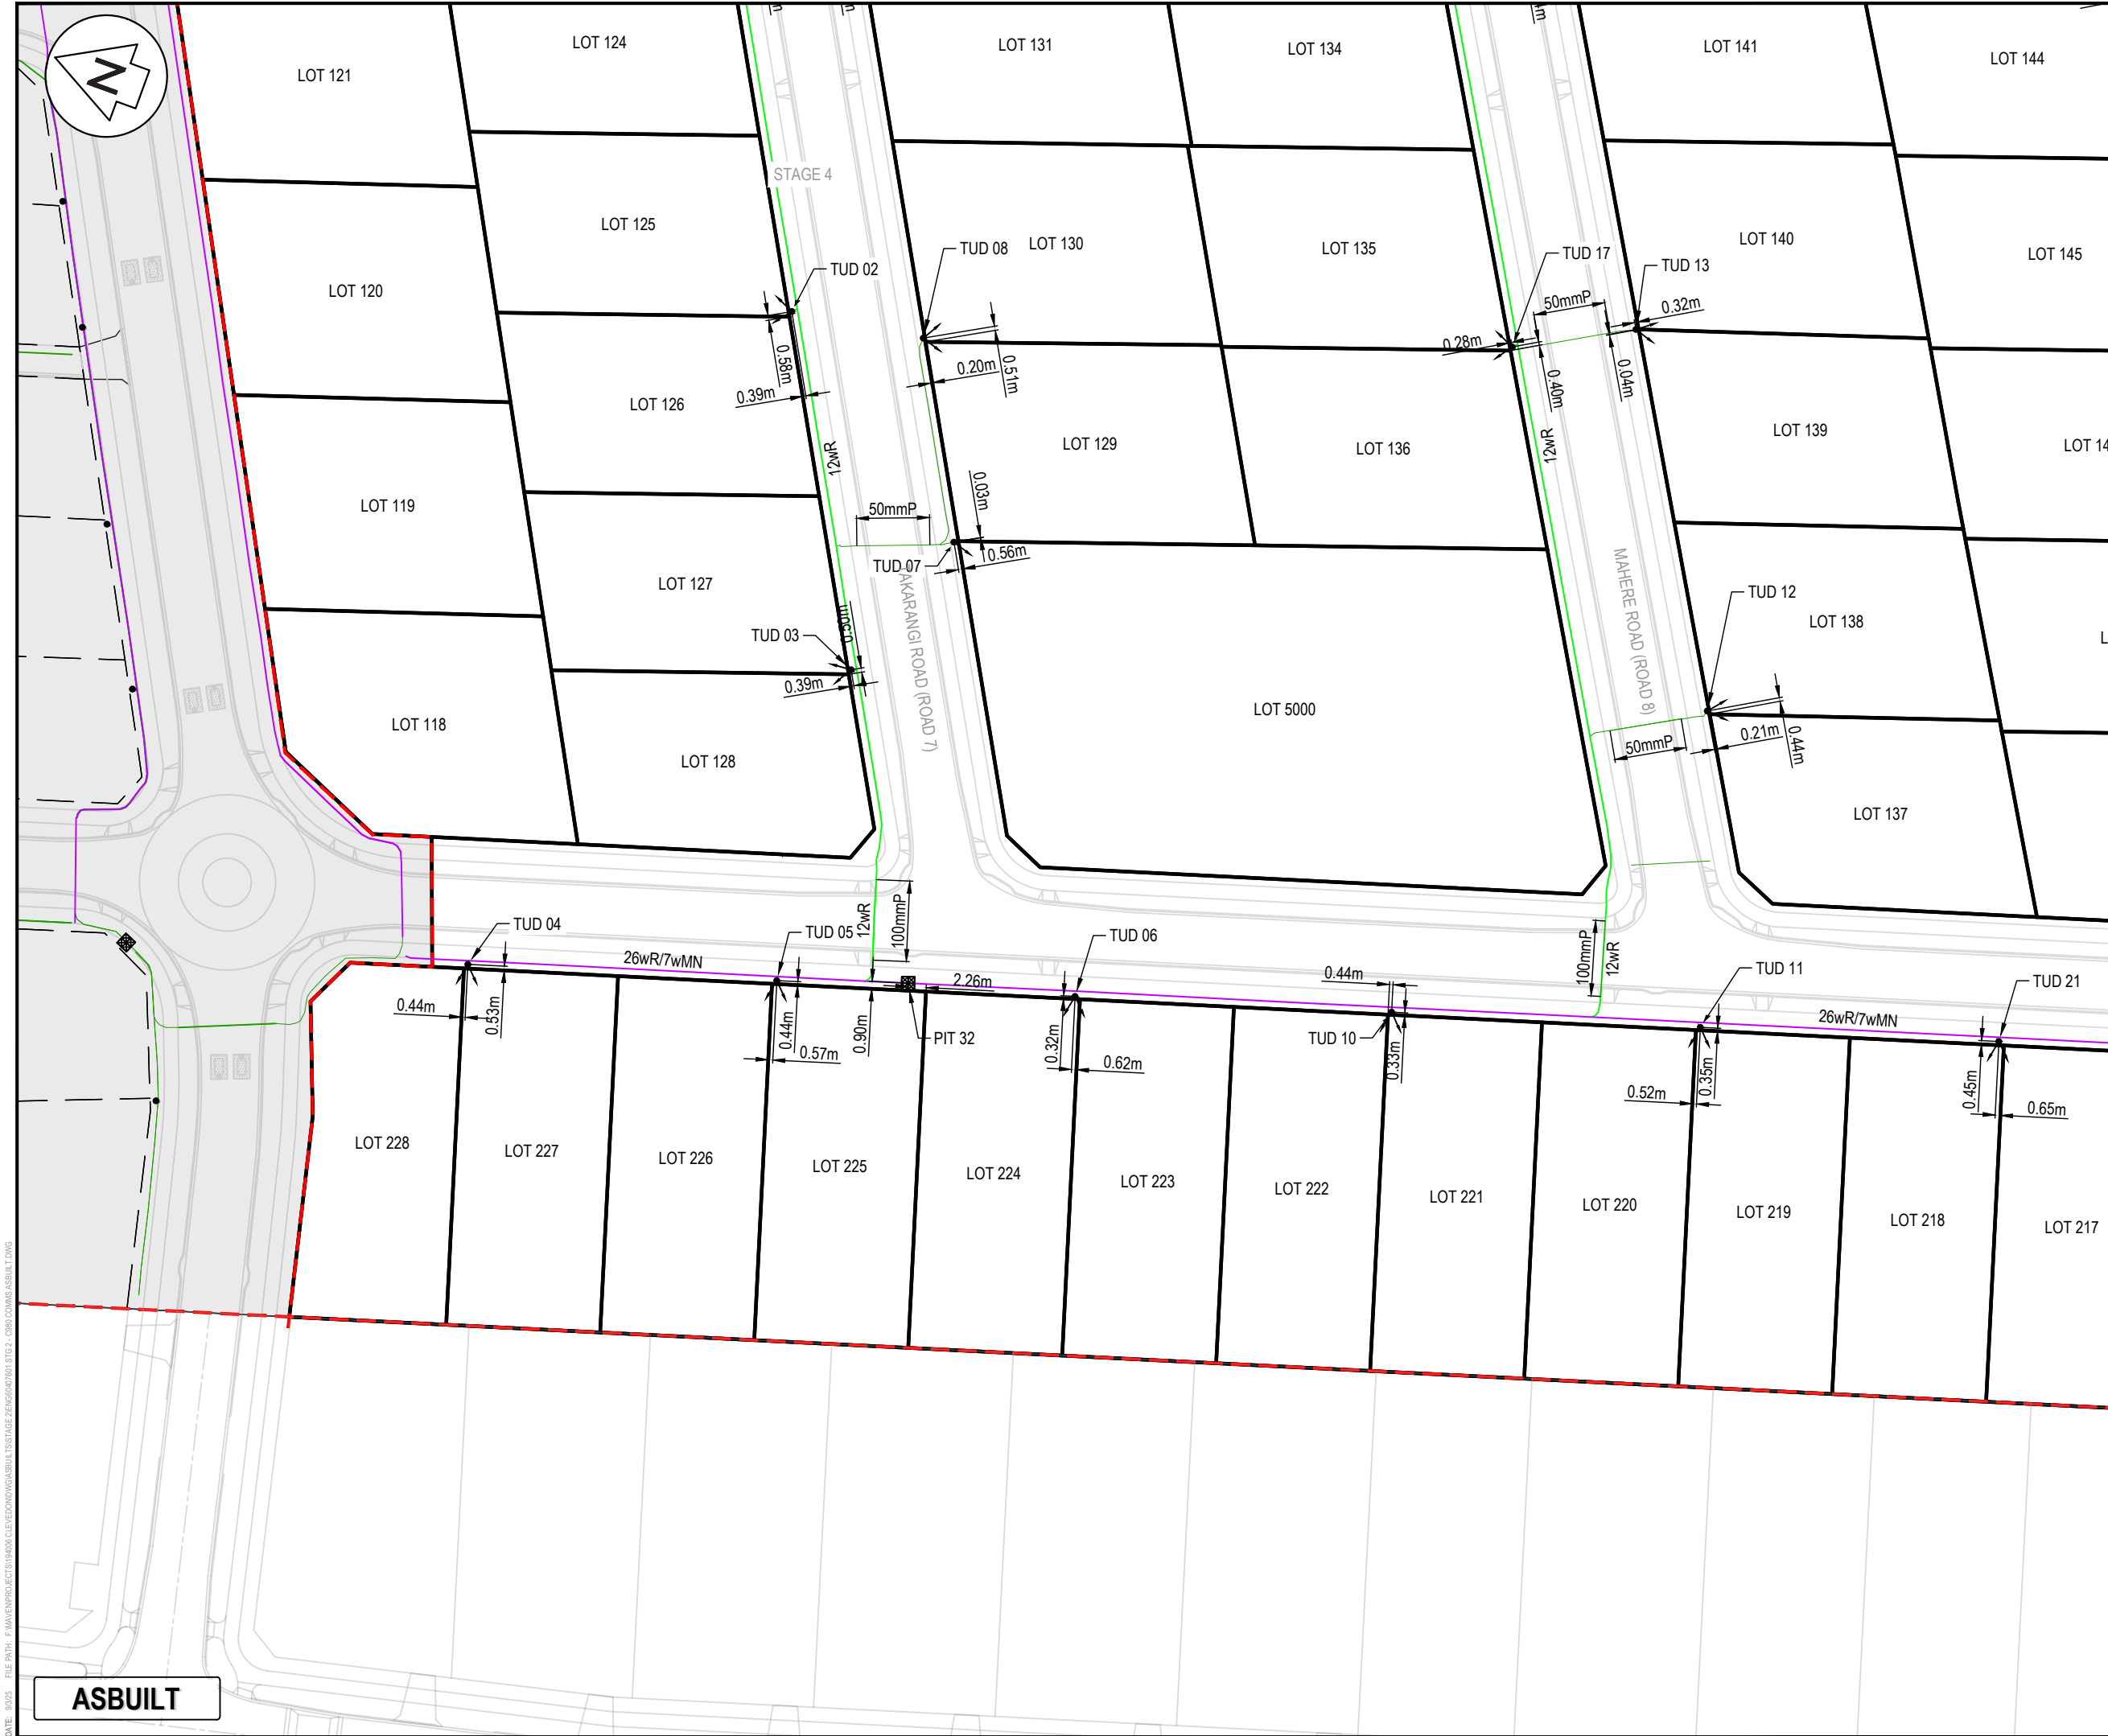

NOTES

- ALL WORKS TO BE IN ACCORDANCE WITH AUCKLAND COUNCIL STANDARDS.
- COORDINATES IN TERMS OF THE NEW ZEALAND TRANSVERSE MERACATOR 2000 (NZTM).
- LEVELS IN TERMS OF THE NEW ZEALAND VERTICAL DATUM 2016 (NZVD 2016).
- ORIGIN OF LEVELS = RM 5846 SO 58211(BB2R) PUBLISHED RL=10.31, SOURCED FROM THE LINZ DIGITAL GEODETIC DATABASE.

STAGE 1

STAGE 2

STAGE 3

STAGE 4

Legend

- EX BDY
- AB BDY
- STAGE BDY
- AB 1wM MICRONET
- AB 1wR RIBBONET
- AB 7wM MICRONET
- AB 12wR RIBBONET
- AB 26wR RIBBONET
- TELECOM TUD
- CHORUS PIT

A	ASBUILT	HL	01/2025
Rev	Description	By	Date
		By	Date
Survey	DEMPSEY WOOD		12/2024
Design	ML		12/2024
Drawn	ML		12/2024
Checked	JD		12/2024

M

Maven Associates

09 571 0050

info@maven.co.nz

www.maven.co.nz

5 Owens Road, Epsom

Auckland 1023

Project

62, 78 AND 80 PAPA KURA - CLEVEDON ROAD, CLEVEDON, AUCKLAND FOR CLEVEDON PROPERTIES LTD


Title

ENG60407601 STAGE 2 COMMS ASBUILT PLAN

Project no.	194006		
Scale	1:750 @ A3		
Cad file	ENG60407601 STG 2 - C980 COMMS ASBUILT.DWG		
Drawing no.	STG_2 C983	Rev	A

DATE: 5/02/25 FILE PATH: I:\Maven\PROJECTS\194006 CLEVEDON\WGAASBUILT\STAGE 2\ENG60407601 STG 2 - C980 COMMS ASBUILT.DWG

ASBUILT

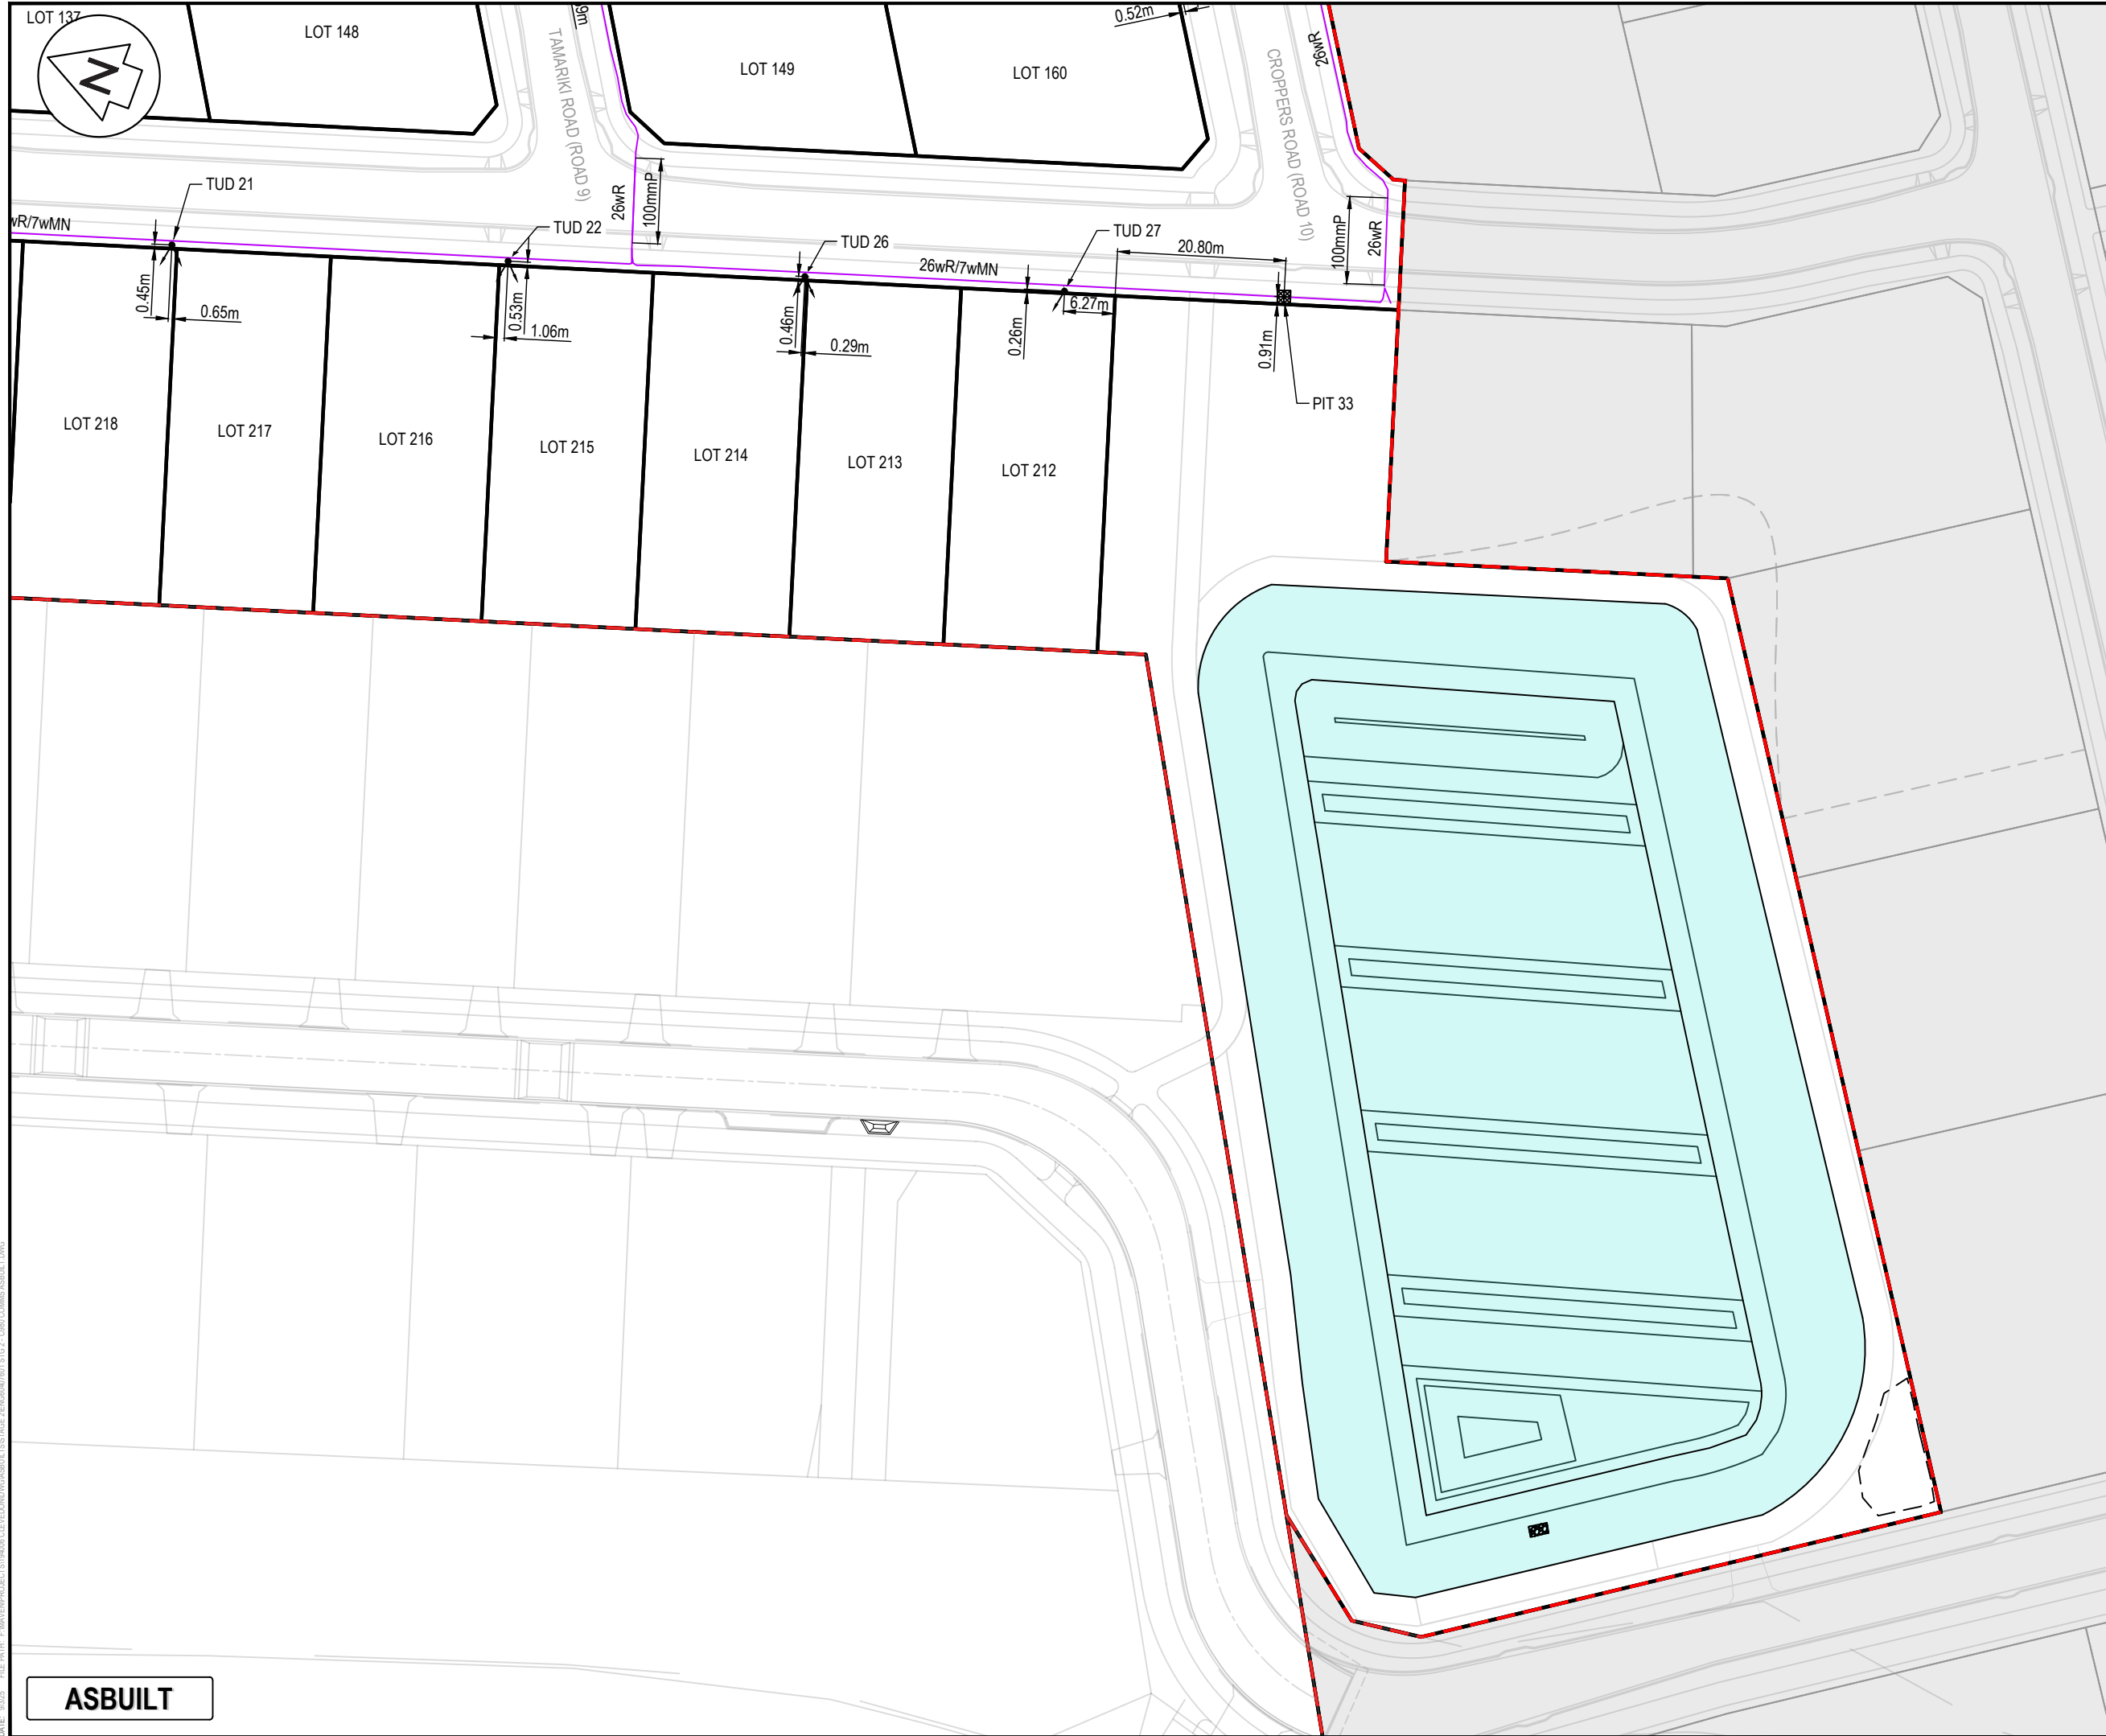

NOTES

- ALL WORKS TO BE IN ACCORDANCE WITH AUCKLAND COUNCIL STANDARDS.
- COORDINATES IN TERMS OF THE NEW ZEALAND TRANSVERSE MERACATOR 2000 (NZTM).
- LEVELS IN TERMS OF THE NEW ZEALAND VERTICAL DATUM 2016 (NZVD 2016).
- ORIGIN OF LEVELS = RM 5846 SO 58211(BB2R) PUBLISHED RL=10.31, SOURCED FROM THE LINZ DIGITAL GEODETIC DATABASE.

Legend

	STAGE 1
	STAGE 2
	STAGE 3
	STAGE 4

	EX BDY
	AB BDY
	STAGE BDY
	AB 1wM MICRONET
	AB 1wR RIBBONET
	AB 7wM MICRONET
	AB 12wR RIBBONET
	AB 26wR RIBBONET
	TELECOM TUD
	CHORUS PIT

A	ASBUILT	HL	01/2025
Rev	Description	By	Date
		By	Date
Survey	DEMPSEY WOOD		12/2024
Design	ML		12/2024
Drawn	ML		12/2024
Checked	JD		12/2024

Maven Associates
09 571 0050
info@maven.co.nz
www.maven.co.nz
5 Owens Road, Epsom
Auckland 1023

Project

**62, 78 AND 80 PAPA KURA -
CLEVEDON ROAD,
CLEVEDON, AUCKLAND
FOR CLEVEDON
PROPERTIES LTD**

Title

**ENG60407601 STAGE 2
COMMS ASBUILT
PLAN**

Project no.	194006		
Scale	1:750 @ A3		
Cad file	ENG60407601 STG 2 - C980 COMMS ASBUILT.DWG		
Drawing no.	STG_2 C984	Rev	A

DATE: 5/02/25 FILE PATH: I:\MAVEN\PROJECTS\194006 CLEVEDON\DRAWINGS\STAGE 2\ENG60407601 STG 2 - C980 COMMS ASBUILT.DWG

ASBUILT

DATE: 18/25 FILE PATH: F:\Maven\PROJECTS\14048 CLEVEDON\ASBUILT\STG 2 - C985 COMMS ASBUILT.DWG

ASBUILT

TABLE OF CO-ORDINATES (NZTM)		
Description	Northing	Easting
PIT 32	5902912.79mN	1781065.40mE
PIT 33	5902652.88mN	1781145.66mE
TUD 01	5902976.92mN	1781177.81mE
TUD 02	5902954.61mN	1781138.30mE
TUD 03	5902932.61mN	1781099.30mE
TUD 04	5902964.59mN	1781049.00mE
TUD 05	5902928.11mN	1781060.17mE
TUD 06	5902892.88mN	1781070.93mE
TUD 07	5902926.09mN	1781118.43mE
TUD 08	5902938.25mN	1781140.77mE
TUD 09	5902962.40mN	1781183.98mE
TUD 10	5902855.53mN	1781082.47mE
TUD 11	5902819.12mN	1781093.74mE
TUD 12	5902831.67mN	1781130.69mE
TUD 13	5902856.04mN	1781171.87mE
TUD 14	5902880.14mN	1781213.10mE
TUD 15	5902917.78mN	1781246.45mE
TUD 16	5902894.45mN	1781206.91mE
TUD 17	5902869.65mN	1781164.61mE
TUD 18	5902812.95mN	1781236.43mE

TABLE OF CO-ORDINATES (NZTM)		
Description	Northing	Easting
TUD 19	5902787.19mN	1781193.44mE
TUD 20	5902762.84mN	1781153.31mE
TUD 21	5902783.94mN	1781104.71mE
TUD 22	5902744.30mN	1781117.04mE
TUD 23	5902747.28mN	1781156.71mE
TUD 24	5902771.76mN	1781197.09mE
TUD 25	5902797.20mN	1781239.27mE
TUD 26	5902709.24mN	1781127.79mE
TUD 27	5902678.56mN	1781137.06mE
TUD 28	5902678.06mN	1781177.27mE
TUD 29	5902706.28mN	1781222.25mE
TUD 30	5902732.52mN	1781264.42mE
TUD 31	5902744.75mN	1781283.70mE
TUD 32	5902825.76mN	1781257.69mE

- NOTES
1. ALL WORKS TO BE IN ACCORDANCE WITH AUCKLAND COUNCIL STANDARDS.
 2. COORDINATES IN TERMS OF THE NEW ZEALAND TRANSVERSE MERACATOR 2000 (NZTM).
 3. LEVELS IN TERMS OF THE NEW ZEALAND VERTICAL DATUM 2016 (NZVD 2016).
 4. ORIGIN OF LEVELS = RM 5846 SO 58211(BB2R)
PUBLISHED RL=10.31, SOURCED FROM THE LINZ DIGITAL GEODETIC DATABASE.

STAGE 1

STAGE 2

STAGE 3

STAGE 4

Legend

EX BDY

AB BDY

STAGE BDY

AB 1wM MICRONET

AB 1wR RIBBONET

AB 7wM MICRONET

AB 12wR RIBBONET

AB 26wR RIBBONET



TELECOM TUD



CHORUS PIT

A	ASBUILT	HL	01/2025
Rev	Description	By	Date
	By	Date	
Survey	DEMPSEY WOOD	12/2024	
Design	ML	12/2024	
Drawn	ML	12/2024	
Checked	JD	12/2024	



Maven Associates
09 571 0050
info@maven.co.nz
www.maven.co.nz
5 Owens Road, Epsom
Auckland 1023

Project
**62, 78 AND 80 PAPAKURA -
CLEVEDON ROAD,
CLEVEDON, AUCKLAND
FOR CLEVEDON
PROPERTIES LTD**

Title
**ENG60407601 STAGE 2
COMMS ASBUILT
TABLE**

Project no.	194006		
Scale	1:750 @ A3		
Cad file	ENG60407601 STG 2 - C980 COMMS ASBUILT.DWG		
Drawing no.	STG_2 C985	Rev	A