

- NOTES
1. ALL WORKS TO BE IN ACCORDANCE WITH AUCKLAND COUNCIL STANDARDS.
 2. COORDINATES IN TERMS OF NEW ZEALAND TRANSVERSE MERCATOR 2000 (NZTM 2000).
 3. LEVELS IN TERMS OF NEW ZEALAND VERTICAL DATUM 2016 (NZVD2016).
 4. ORIGIN OF LEVELS = RM 5846 SO 58211(BB2R) PUBLISHED RL=10.31, SOURCED FROM THE LINZ DIGITAL GEODETIC DATABASE.

- STAGE 1 (VESTED)
- STAGE 2
- STAGE 3
- STAGE 4 (FUTURE EPA)

- Legend
- EX BDY
 - AB BDY
 - STAGE BDY
 - LV POWER 100
 - HV POWER 140
 - STREETLIGHT LINE
 - LINK PILLAR
 - POWER SERVICE PIT
 - STREET LIGHT
 - TRANSFORMER/ SWITCHGEAR

A	ASBUILT	HL	01/2025
Rev	Description	By	Date
		By	Date
Survey	DEMPSEY WOOD		12/2024
Design	ML		12/2024
Drawn	ML		12/2024
Checked	JD		12/2024



Project
**62, 78 AND 80 PAKURA -
CLEVEDON ROAD,
CLEVEDON, AUCKLAND
FOR CLEVEDON
PROPERTIES LTD**

Title
**ENG60407601 STAGE 2
POWER ASBUILT
OVERVIEW PLAN**

Project no.	194006
Scale	1:3500 @ A3
Cad file	ENG60407601 - STG_2 - C990 POWER ASBUILT.DWG
Drawing no.	STG_2 C990
Rev	A

73R MONUMENT ROAD
LOT 2 DP 176480, LOT 2 DP 67978, PT
ALLT 3 PARO WAIROA, LOT 1 DP 67852,
LOT 2 DP 67852, LOT 1 DP 176480

REFER TO STG-2 C991

REFER TO STG-2 C992

REFER TO STG-2 C993

REFER TO STG-2 C994

144 PAKURA-CLEVEDON ROAD
LOT 2 DP 142381, LOT 3 DP 142381,
LOT 2 DP 186158

PAKURA CLEVEDON ROAD

ASBUILT

DATE: 5/2/25 FILE PATH: F:\Maven\PROJECTS\194006 CLEVEDON\ASBUILT\STAGE 2\ENG60407601 - STG_2 - C990 POWER ASBUILT.DWG



NOTES

- ALL WORKS TO BE IN ACCORDANCE WITH AUCKLAND COUNCIL STANDARDS.
- COORDINATES IN TERMS OF NEW ZEALAND TRANSVERSE MERCATOR 2000 (NZTM 2000).
- LEVELS IN TERMS OF NEW ZEALAND VERTICAL DATUM 2016 (NZVD2016).
- ORIGIN OF LEVELS = RM 5846 S0 58211(BB2R) PUBLISHED RL=10.31, SOURCED FROM THE LINZ DIGITAL GEODETIC DATABASE.

Legend

- EX BDY
- AB BDY
- STAGE BDY
- LV POWER 100
- HV POWER 140
- STREETLIGHT LINE
- LINK PILLAR
- POWER SERVICE PIT
- STREET LIGHT
- TRANSFORMER/ SWITCHGEAR

A	ASBUILT	HL	01/2025
Rev	Description	By	Date
		By	Date
Survey	DEMPSEY WOOD		12/2024
Design	ML		12/2024
Drawn	ML		12/2024
Checked	JD		12/2024

Maven Associates
09 571 0050
info@maven.co.nz
www.maven.co.nz
5 Owens Road, Epsom
Auckland 1023

Project

62, 78 AND 80 PAKAPURA - CLEVEDON ROAD, CLEVEDON, AUCKLAND FOR CLEVEDON PROPERTIES LTD

Title

ENG60407601 STAGE 2 POWER ASBUILT PLAN

Project no.	194006		
Scale	1:750 @ A3		
Cad file	ENG60407601 - STG_2 - C990 POWER ASBUILT.DWG		
Drawing no.	STG_2 C991	Rev	A

DATE: 5/2/25 FILE PATH: F:\Maven\PROJECTS\194006 CLEVEDON\DRAWINGS\STAGE 2\STG_2 - C990 POWER ASBUILT.DWG

ASBUILT



NOTES

- ALL WORKS TO BE IN ACCORDANCE WITH AUCKLAND COUNCIL STANDARDS.
- COORDINATES IN TERMS OF NEW ZEALAND TRANSVERSE MERCATOR 2000 (NZTM 2000).
- LEVELS IN TERMS OF NEW ZEALAND VERTICAL DATUM 2016 (NZVD2016).
- ORIGIN OF LEVELS = RM 5846 SO 58211(BB2R) PUBLISHED RL=10.31, SOURCED FROM THE LINZ DIGITAL GEODETIC DATABASE.

Legend

- EX BDY
- AB BDY
- STAGE BDY
- LV POWER 100
- HV POWER 140
- STREETLIGHT LINE
- LINK PILLAR
- POWER SERVICE PIT
- STREET LIGHT
- TRANSFORMER/ SWITCHGEAR

A	ASBUILT	HL	01/2025
Rev	Description	By	Date
		By	Date
Survey	DEMPSEY WOOD		12/2024
Design	ML		12/2024
Drawn	ML		12/2024
Checked	JD		12/2024

Maven Associates
09 571 0050
info@maven.co.nz
www.maven.co.nz
5 Owens Road, Epsom
Auckland 1023

Project

62, 78 AND 80 PAKAKURA - CLEVEDON ROAD, CLEVEDON, AUCKLAND FOR CLEVEDON PROPERTIES LTD

Title

ENG60407601 STAGE 2 POWER ASBUILT PLAN

Project no.	194006		
Scale	1:750 @ A3		
Cad file	ENG60407601 - STG_2 - C990 POWER ASBUILT.DWG		
Drawing no.	STG_2 C992	Rev	A

DATE: 01/2025 FILE PATH: P:\Maven\PROJECTS\194006 CLEVEDON\ASBUILT\STAGE 2\STG_2_C990 POWER ASBUILT.DWG



NOTES

- ALL WORKS TO BE IN ACCORDANCE WITH AUCKLAND COUNCIL STANDARDS.
- COORDINATES IN TERMS OF NEW ZEALAND TRANSVERSE MERCATOR 2000 (NZTM 2000).
- LEVELS IN TERMS OF NEW ZEALAND VERTICAL DATUM 2016 (NZVD2016).
- ORIGIN OF LEVELS = RM 5846 SO 58211(BB2R) PUBLISHED RL=10.31, SOURCED FROM THE LINZ DIGITAL GEODETIC DATABASE.

Legend

- EX BDY
- AB BDY
- STAGE BDY
- LV POWER 100
- HV POWER 140
- STREETLIGHT LINE
- LINK PILLAR
- POWER SERVICE PIT
- STREET LIGHT
- TRANSFORMER/ SWITCHGEAR

A	ASBUILT	HL	01/2025
Rev	Description	By	Date
	By	Date	
Survey	DEMPSEY WOOD	12/2024	
Design	ML	12/2024	
Drawn	ML	12/2024	
Checked	JD	12/2024	

Maven Associates
09 571 0050
info@maven.co.nz
www.maven.co.nz
5 Owens Road, Epsom
Auckland 1023

Project

62, 78 AND 80 PAPA KURA - CLEVEDON ROAD, CLEVEDON, AUCKLAND FOR CLEVEDON PROPERTIES LTD


Title

ENG60407601 STAGE 2 POWER ASBUILT PLAN

Project no.	194006		
Scale	1:750 @ A3		
Cad file	ENG60407601 - STG_2 - C990 POWER ASBUILT.DWG		
Drawing no.	STG_2 C993	Rev	A

DATE: 5/2/25 FILE PATH: F:\MAVEN\PROJECTS\194006 CLEVEDON\ASBUILT\STAGE 2\ENG60407601 - STG_2 - C990 POWER ASBUILT.DWG

ASBUILT

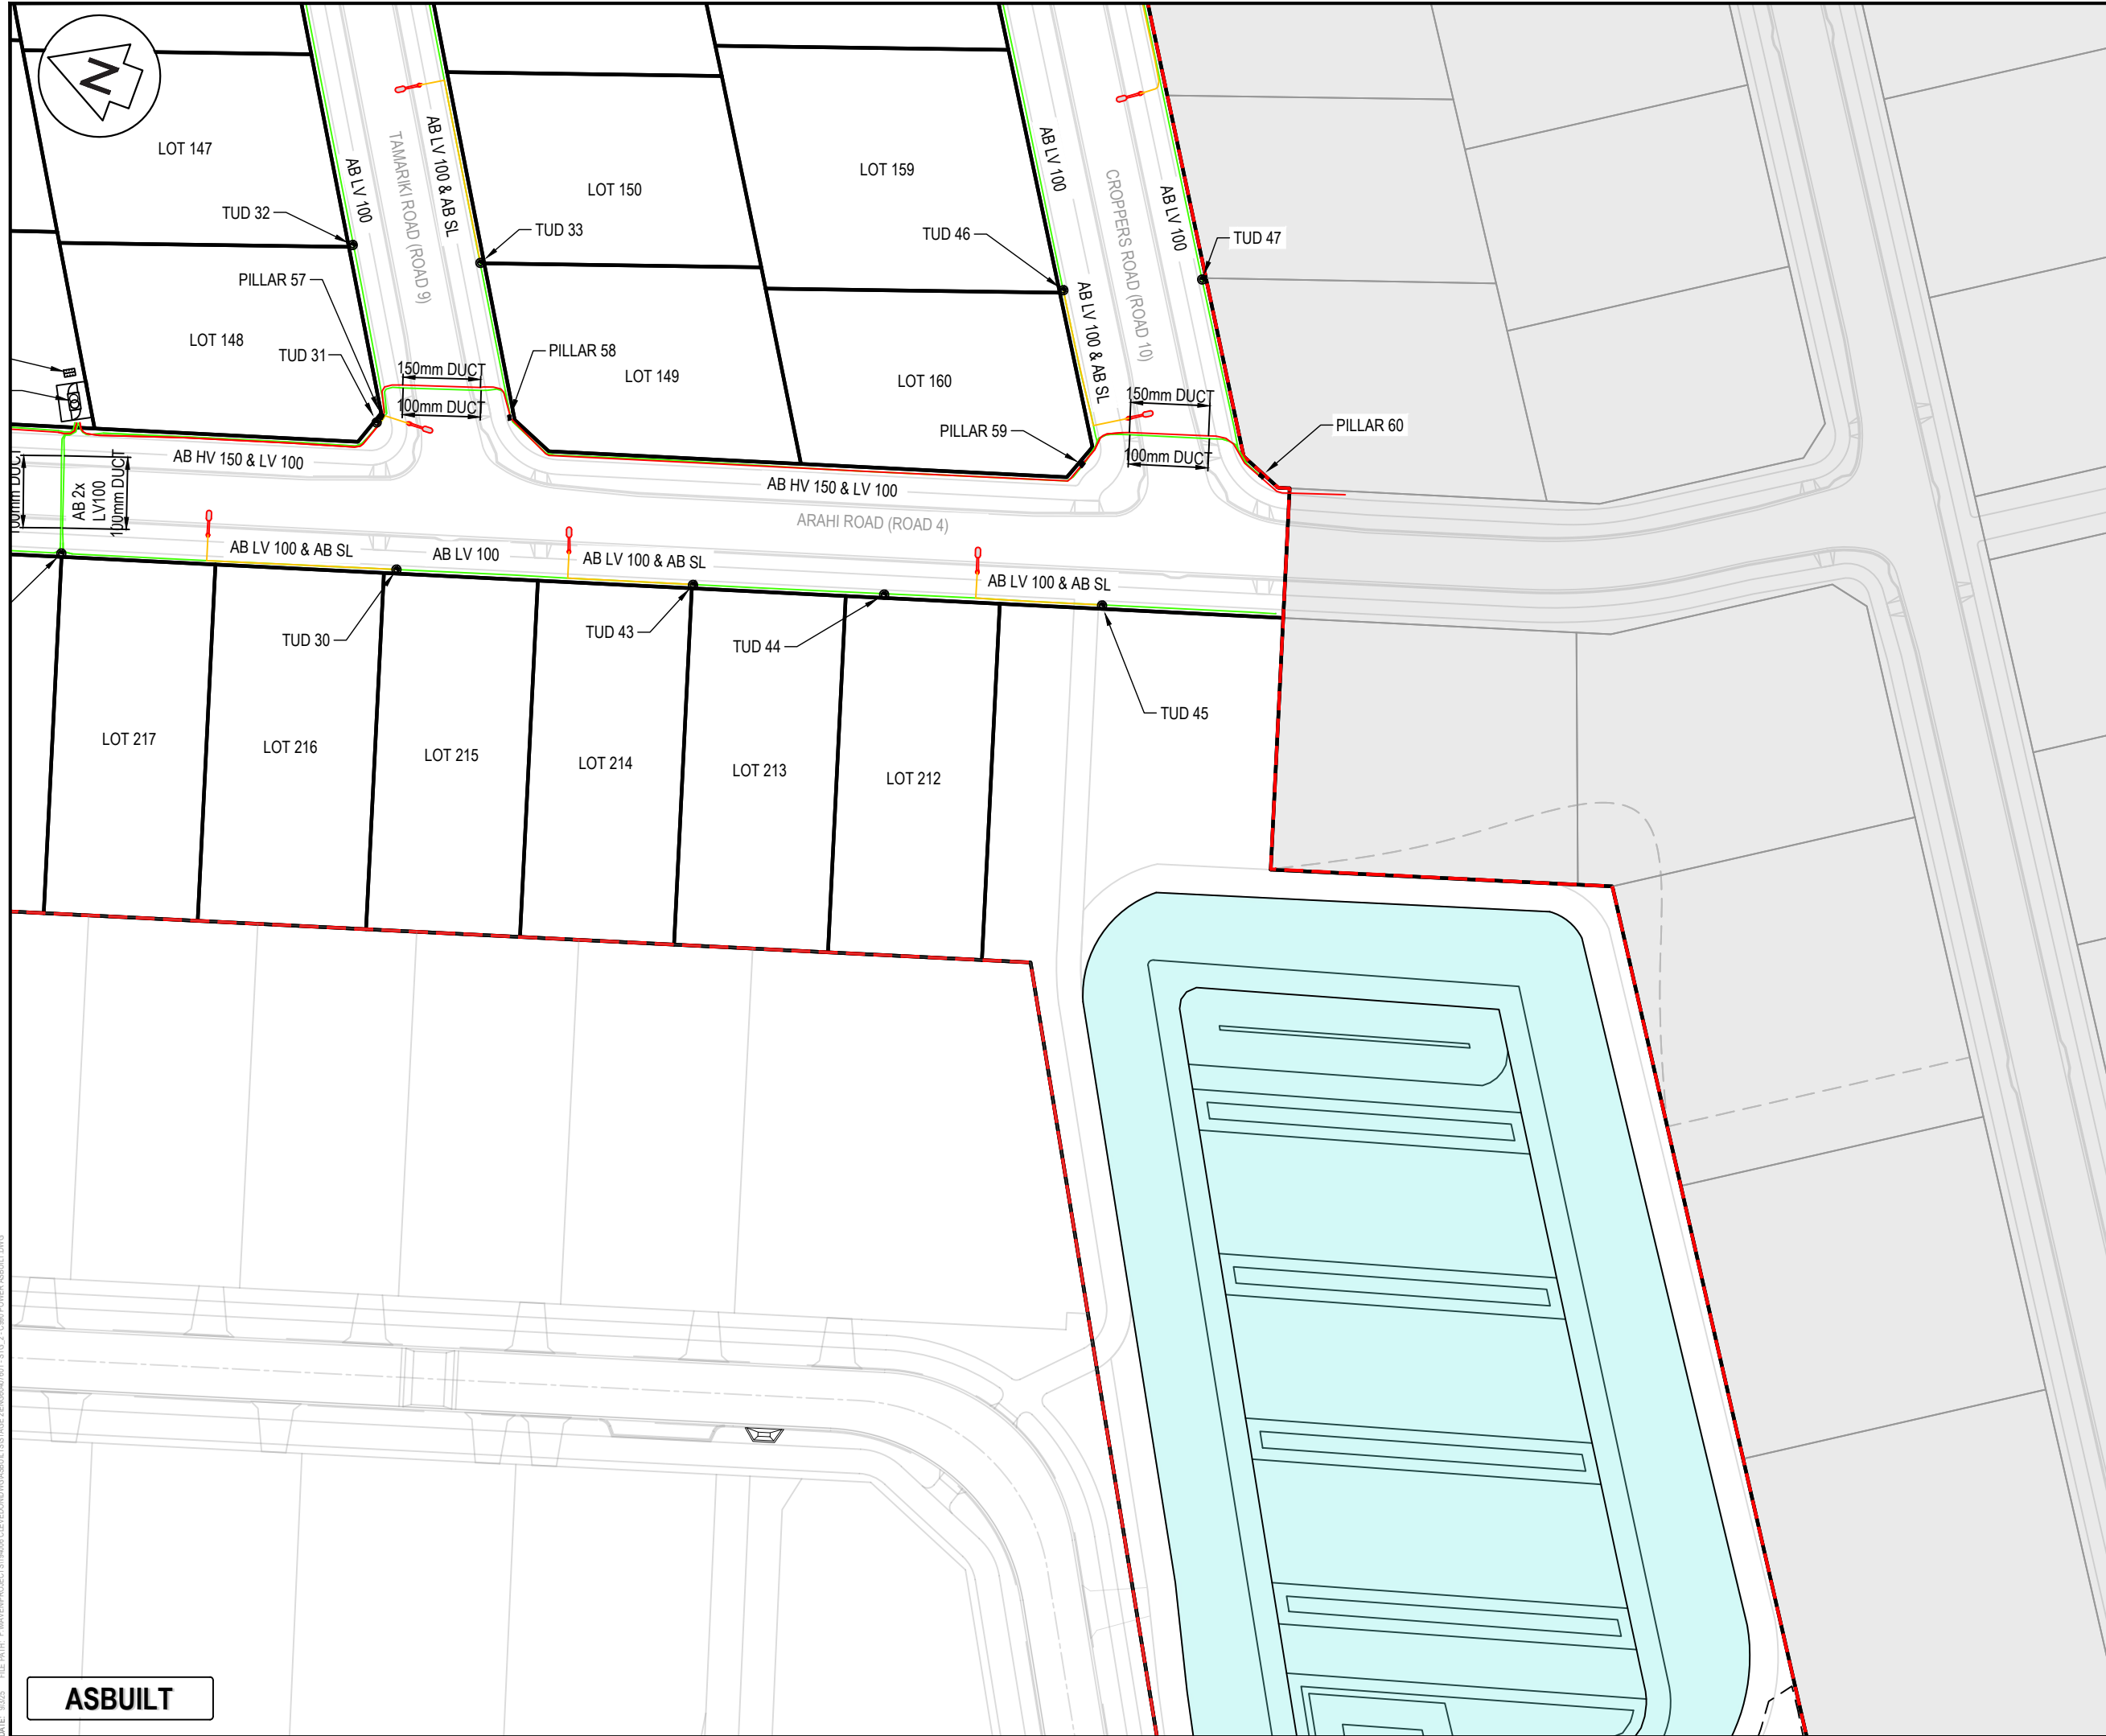

NOTES

- ALL WORKS TO BE IN ACCORDANCE WITH AUCKLAND COUNCIL STANDARDS.
- COORDINATES IN TERMS OF NEW ZEALAND TRANSVERSE MERCATOR 2000 (NZTM 2000).
- LEVELS IN TERMS OF NEW ZEALAND VERTICAL DATUM 2016 (NZVD2016).
- ORIGIN OF LEVELS = RM 5846 SO 58211(BB2R) PUBLISHED RL=10.31, SOURCED FROM THE LINZ DIGITAL GEODETIC DATABASE.

Legend

- EX BDY
- AB BDY
- STAGE BDY
- LV POWER 100
- HV POWER 140
- STREETLIGHT LINE
- LINK PILLAR
- POWER SERVICE PIT
- STREET LIGHT
- TRANSFORMER/ SWITCHGEAR

A	ASBUILT	HL	01/2025
Rev	Description	By	Date
		By	Date
Survey	DEMPSEY WOOD		12/2024
Design	ML		12/2024
Drawn	ML		12/2024
Checked	JD		12/2024

M

M A E N

Maven Associates
09 571 0050
info@maven.co.nz
www.maven.co.nz
5 Owens Road, Epsom
Auckland 1023

Project

**62, 78 AND 80 PAPA KURA -
CLEVEDON ROAD,
CLEVEDON, AUCKLAND
FOR CLEVEDON
PROPERTIES LTD**

Title

**ENG60407601 STAGE 2
POWER ASBUILT
PLAN**

Project no.	194006		
Scale	1:750 @ A3		
Cad file	ENG60407601 - STG_2 - C990 POWER ASBUILT.DWG		
Drawing no.	STG_2 C994	Rev	A

DATE: 5/2/25 FILE PATH: F:\Maven\PROJECTS\194006 CLEVEDON\ASBUILT\STAGE 2\ENG60407601 - STG_2 - C990 POWER ASBUILT.DWG

ASBUILT

DATE: 09/25 FILE PATH: F:\Maven\PROJECTS\10405 CLEVEDON\ASBUILT\STG_2 - C990 POWER ASBUILT.DWG

ASBUILT

TABLE OF CO-ORDINATES (NZTM)		
Description	Northing	Easting
PILLAR 53	5902923.27mN	1781080.63mE
PILLAR 54	5902907.41mN	1781086.39mE
PILLAR 55	5902837.01mN	1781107.29mE
PILLAR 56	5902821.32mN	1781113.20mE
PILLAR 57	5902752.00mN	1781134.23mE
PILLAR 58	5902737.17mN	1781139.51mE
PILLAR 59	5902668.78mN	1781158.27mE
PILLAR 60	5902647.56mN	1781164.51mE
PILLAR 61	5902881.61mN	1781283.69mE
PILLAR 62	5902801.60mN	1781311.60mE
PILLAR 63	5902749.61mN	1781327.87mE
PILLAR 64	5902962.70mN	1781255.78mE
SWITCHGEAR 65	5902790.05mN	1781126.12mE
TRANSFORMER 66	5902788.27mN	1781123.02mE
TUD 1	5902965.02mN	1781048.77mE
TUD 2	5902928.64mN	1781059.93mE
TUD 3	5902932.23mN	1781074.81mE
TUD 4	5902932.42mN	1781098.87mE
TUD 5	5902954.34mN	1781137.87mE
TUD 6	5902938.13mN	1781140.31mE

TABLE OF CO-ORDINATES (NZTM)		
Description	Northing	Easting
TUD 47	5902662.71mN	1781184.77mE
TUD 48	5902687.23mN	1781224.38mE
TUD 49	5902706.58mN	1781222.68mE
TUD 50	5902732.80mN	1781264.78mE
TUD 51	5902712.51mN	1781264.61mE
TUD 52	5902725.00mN	1781284.71mE

TABLE OF CO-ORDINATES (NZTM)		
Description	Northing	Easting
TUD 7	5902976.62mN	1781177.34mE
TUD 8	5902960.13mN	1781179.56mE
TUD 9	5902988.91mN	1781199.03mE
TUD 10	5902974.77mN	1781205.24mE
TUD 11	5903000.29mN	1781219.26mE
TUD 12	5902984.68mN	1781223.00mE
TUD 13	5902994.44mN	1781240.83mE
TUD 14	5902964.46mN	1781255.13mE
TUD 15	5902891.67mN	1781087.27mE
TUD 16	5902893.25mN	1781070.80mE
TUD 17	5902855.95mN	1781082.37mE
TUD 18	5902819.56mN	1781093.58mE
TUD 19	5902831.45mN	1781130.30mE
TUD 20	5902869.31mN	1781164.16mE
TUD 21	5902855.77mN	1781171.47mE
TUD 22	5902894.76mN	1781207.41mE
TUD 23	5902877.62mN	1781208.38mE
TUD 24	5902892.99mN	1781234.58mE
TUD 25	5902917.62mN	1781246.08mE
TUD 26	5902902.87mN	1781251.54mE

TABLE OF CO-ORDINATES (NZTM)		
Description	Northing	Easting
TUD 27	5902912.84mN	1781268.43mE
TUD 28	5902885.75mN	1781282.40mE
TUD 29	5902783.35mN	1781104.85mE
TUD 30	5902743.82mN	1781117.16mE
TUD 31	5902752.33mN	1781133.35mE
TUD 32	5902762.60mN	1781152.90mE
TUD 33	5902747.05mN	1781156.21mE
TUD 34	5902787.47mN	1781193.86mE
TUD 35	5902771.95mN	1781197.53mE
TUD 36	5902812.75mN	1781236.01mE
TUD 37	5902797.47mN	1781239.74mE
TUD 38	5902837.29mN	1781276.76mE
TUD 39	5902810.26mN	1781261.19mE
TUD 40	5902820.97mN	1781279.63mE
TUD 41	5902831.22mN	1781296.81mE
TUD 42	5902800.10mN	1781312.21mE
TUD 43	5902708.82mN	1781127.89mE
TUD 44	5902686.26mN	1781134.84mE
TUD 45	5902660.59mN	1781142.78mE
TUD 46	5902678.34mN	1781177.67mE

- NOTES
1. ALL WORKS TO BE IN ACCORDANCE WITH AUCKLAND COUNCIL STANDARDS.
 2. COORDINATES IN TERMS OF NEW ZEALAND TRANSVERSE MERCATOR 2000 (NZTM 2000).
 3. LEVELS IN TERMS OF NEW ZEALAND VERTICAL DATUM 2016 (NZVD2016).
 4. ORIGIN OF LEVELS = RM 5846 SO 58211(BB2R) PUBLISHED RL=10.31, SOURCED FROM THE LINZ DIGITAL GEODETIC DATABASE.

A	ASBUILT	HL	01/2025
Rev	Description	By	Date
	By	Date	
Survey	DEMPSEY WOOD	12/2024	
Design	ML	12/2024	
Drawn	ML	12/2024	
Checked	JD	12/2024	
M A E N Maven Associates 09 571 0050 info@maven.co.nz www.maven.co.nz 5 Owens Road, Epsom Auckland 1023			
Project 62, 78 AND 80 PAPAKURA - CLEVEDON ROAD, CLEVEDON, AUCKLAND FOR CLEVEDON PROPERTIES LTD			
Title ENG60407601 STAGE 2 POWER ASBUILT TABLE			
Project no.	194006		
Scale	1:750 @ A3		
Cad file	ENG60407601 - STG_2 - C990 POWER ASBUILT.DWG		
Drawing no.	STG_2 C995	Rev	A