


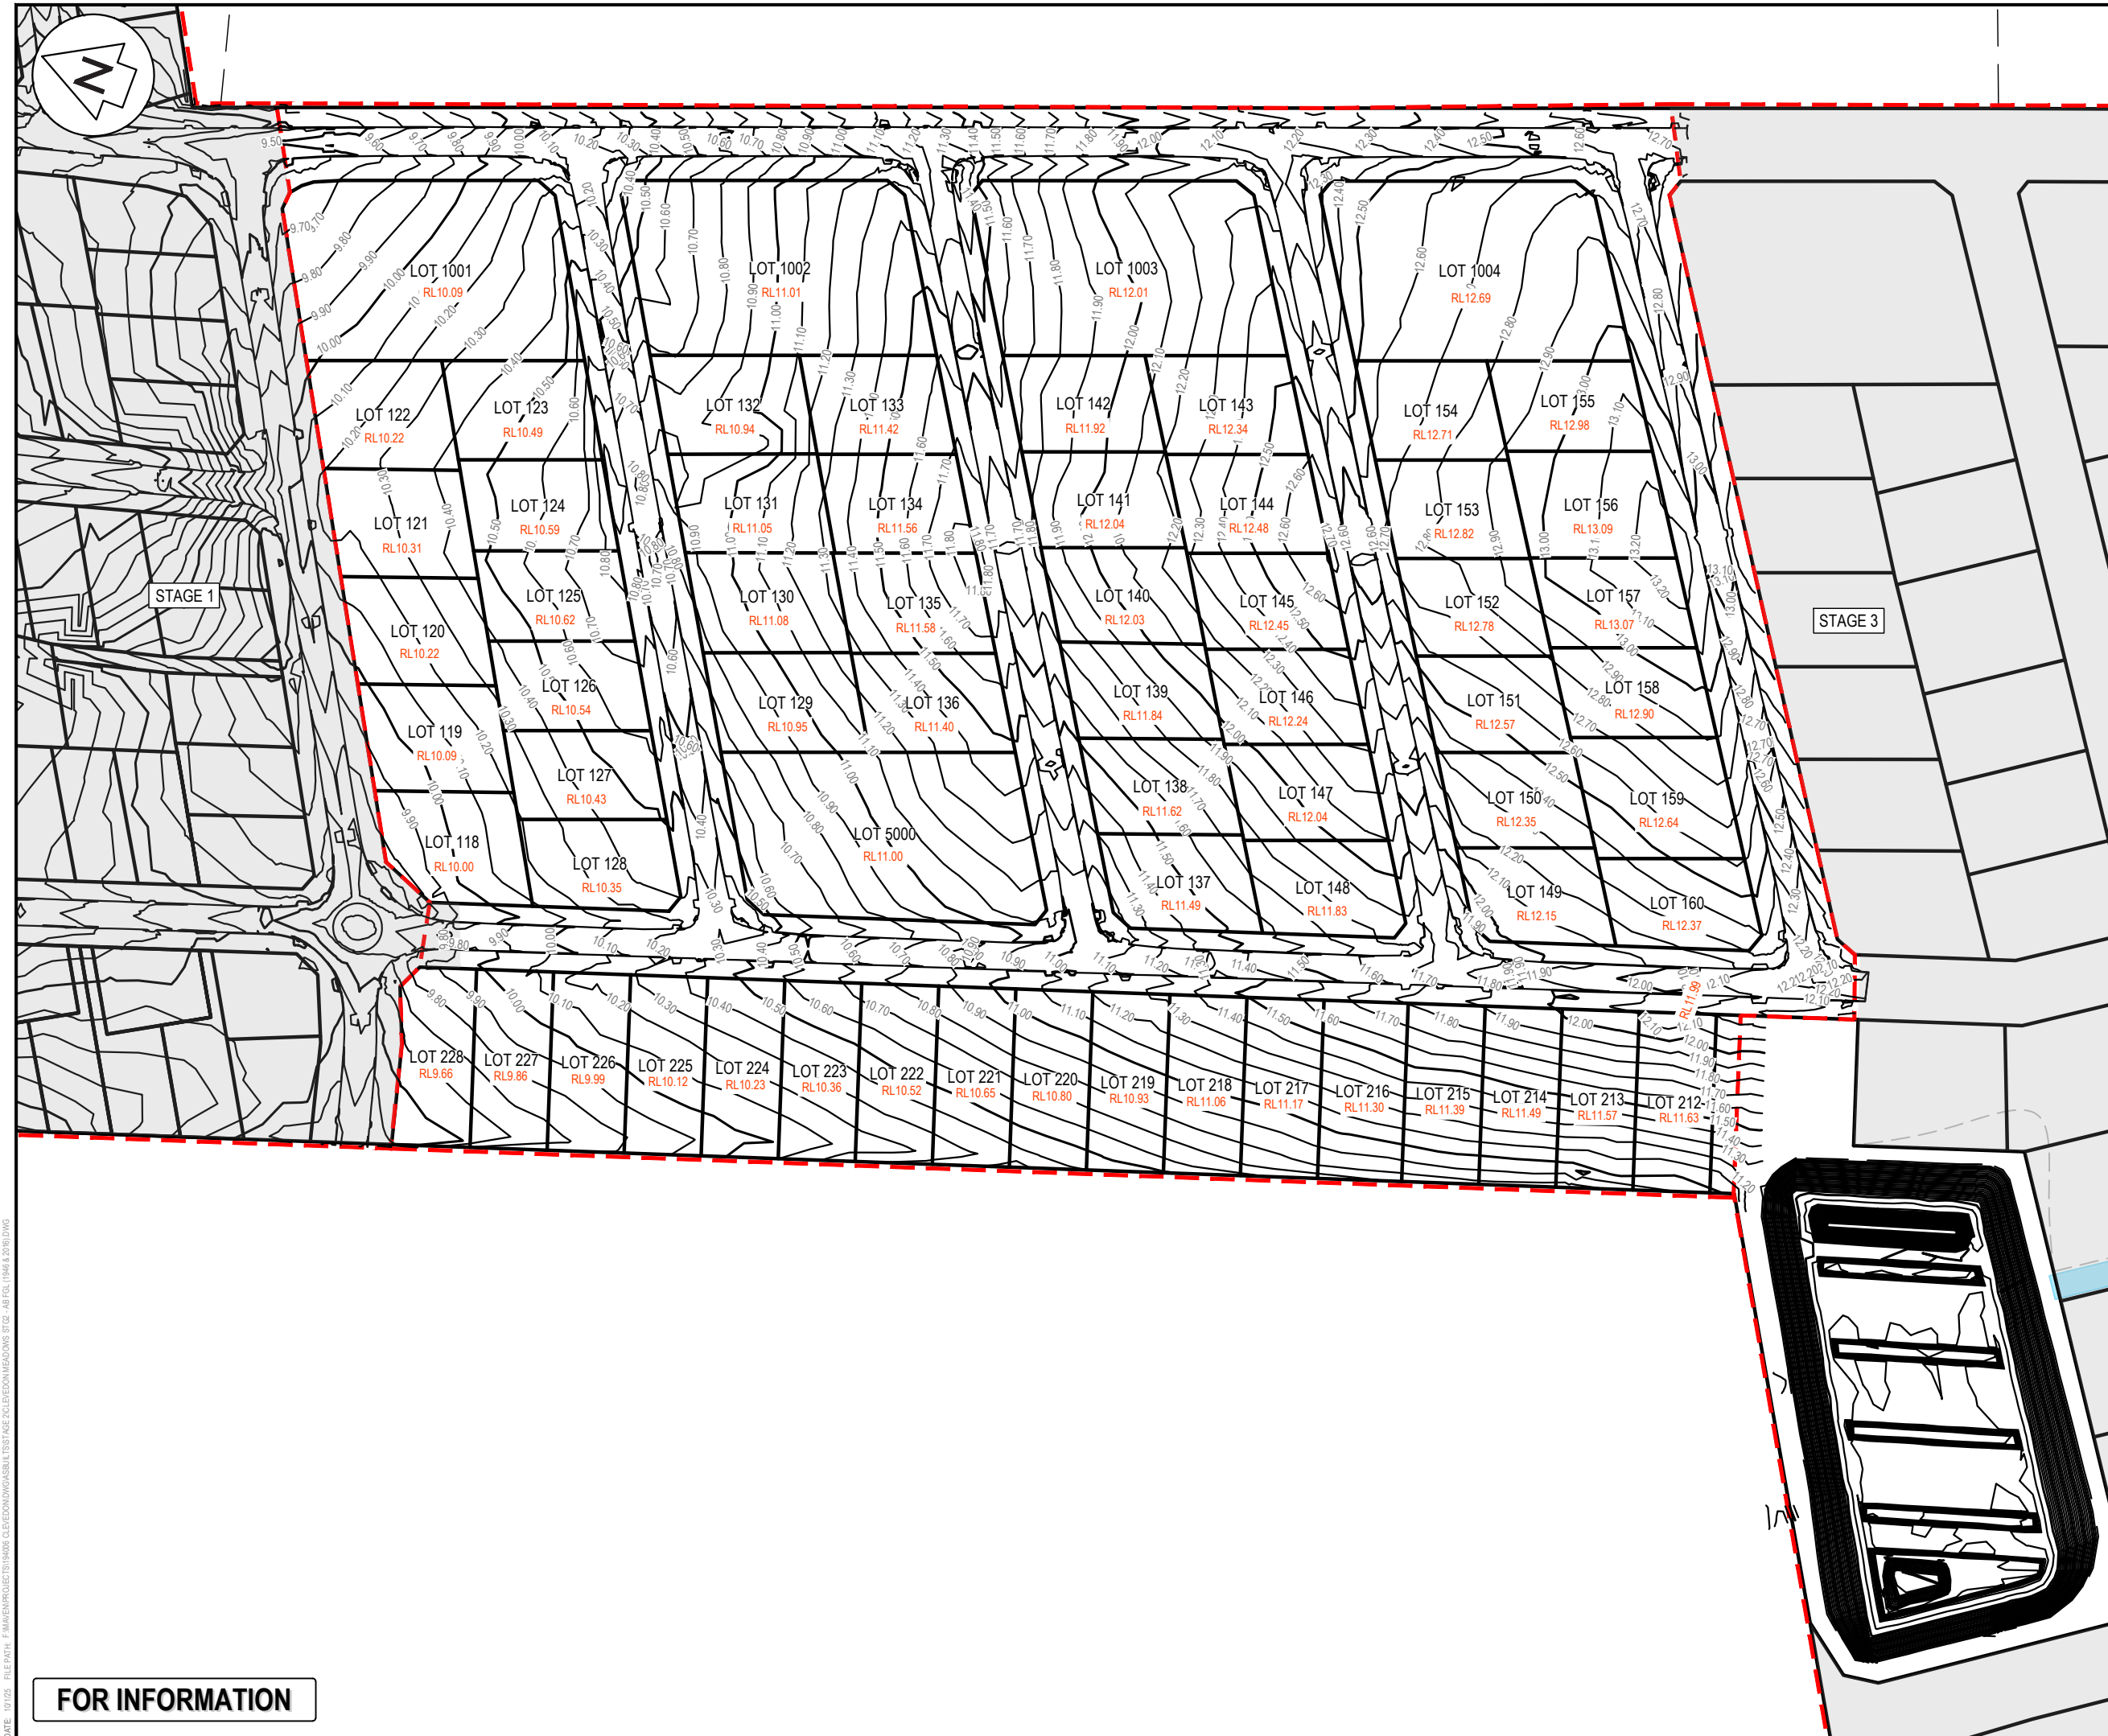

Notes

1. Co-Ordinates are in terms of Mt Eden 2000.
2. Levels in terms of the Auckland Vertical Datum **AUK 1946**.
3. Works carried out by Dempsey Wood Civils
4. Constructed in accordance with Auckland Council standards.
5. Levels shown are for information only and are to be confirmed by survey for detailed design.
6. Origin of Levels
RM 5846 SO 58211 (BB2R)
RL 10.31m

Legend

- EX BDY
- AB BDY
- STAGING BDY
- AB MAJOR CONTOUR
- AB MINOR CONTOUR

D	FOR INFORMATION	ML	10/2025
C	FOR INFORMATION	ML	04/2025
B	FOR INFORMATION	ML	03/2025
A	FOR INFORMATION	ML	10/2024
Rev	Description	By	Date
	By	Date	
Survey	DEMPSEY WOOD	09/2024	
Design	ML	09/2024	
Drawn	ML	09/2024	
Checked	JD	09/2024	



Maven Associates
09 571 0050
info@maven.co.nz
www.maven.co.nz
5 Owens Road, Epsom
Auckland 1023

Project

**62, 78 & 80 PAPAKURA -
CLEVEDON ROAD,
CLEVEDON, AUCKLAND
FOR CLEVEDON
PROPERTIES LTD**


Title

**CLEVEDON MEADOWS
FINISHED GROUND LEVEL
ASBUILT (AUK1946)**

Project no.	194006		
Scale	1:1500 @ A3		
Cad file	CLEVEDON MEADOWS STG2 - AB FGL (1946 & 2016).DWG		
Drawing no.	STG_2 C910	Rev	D

DATE: 10/25 FILE PATH: C:\Maven\Projects\194006_CLEVEDON MEADOWS STG2 - AB FGL (1946 & 2016).DWG

FOR INFORMATION

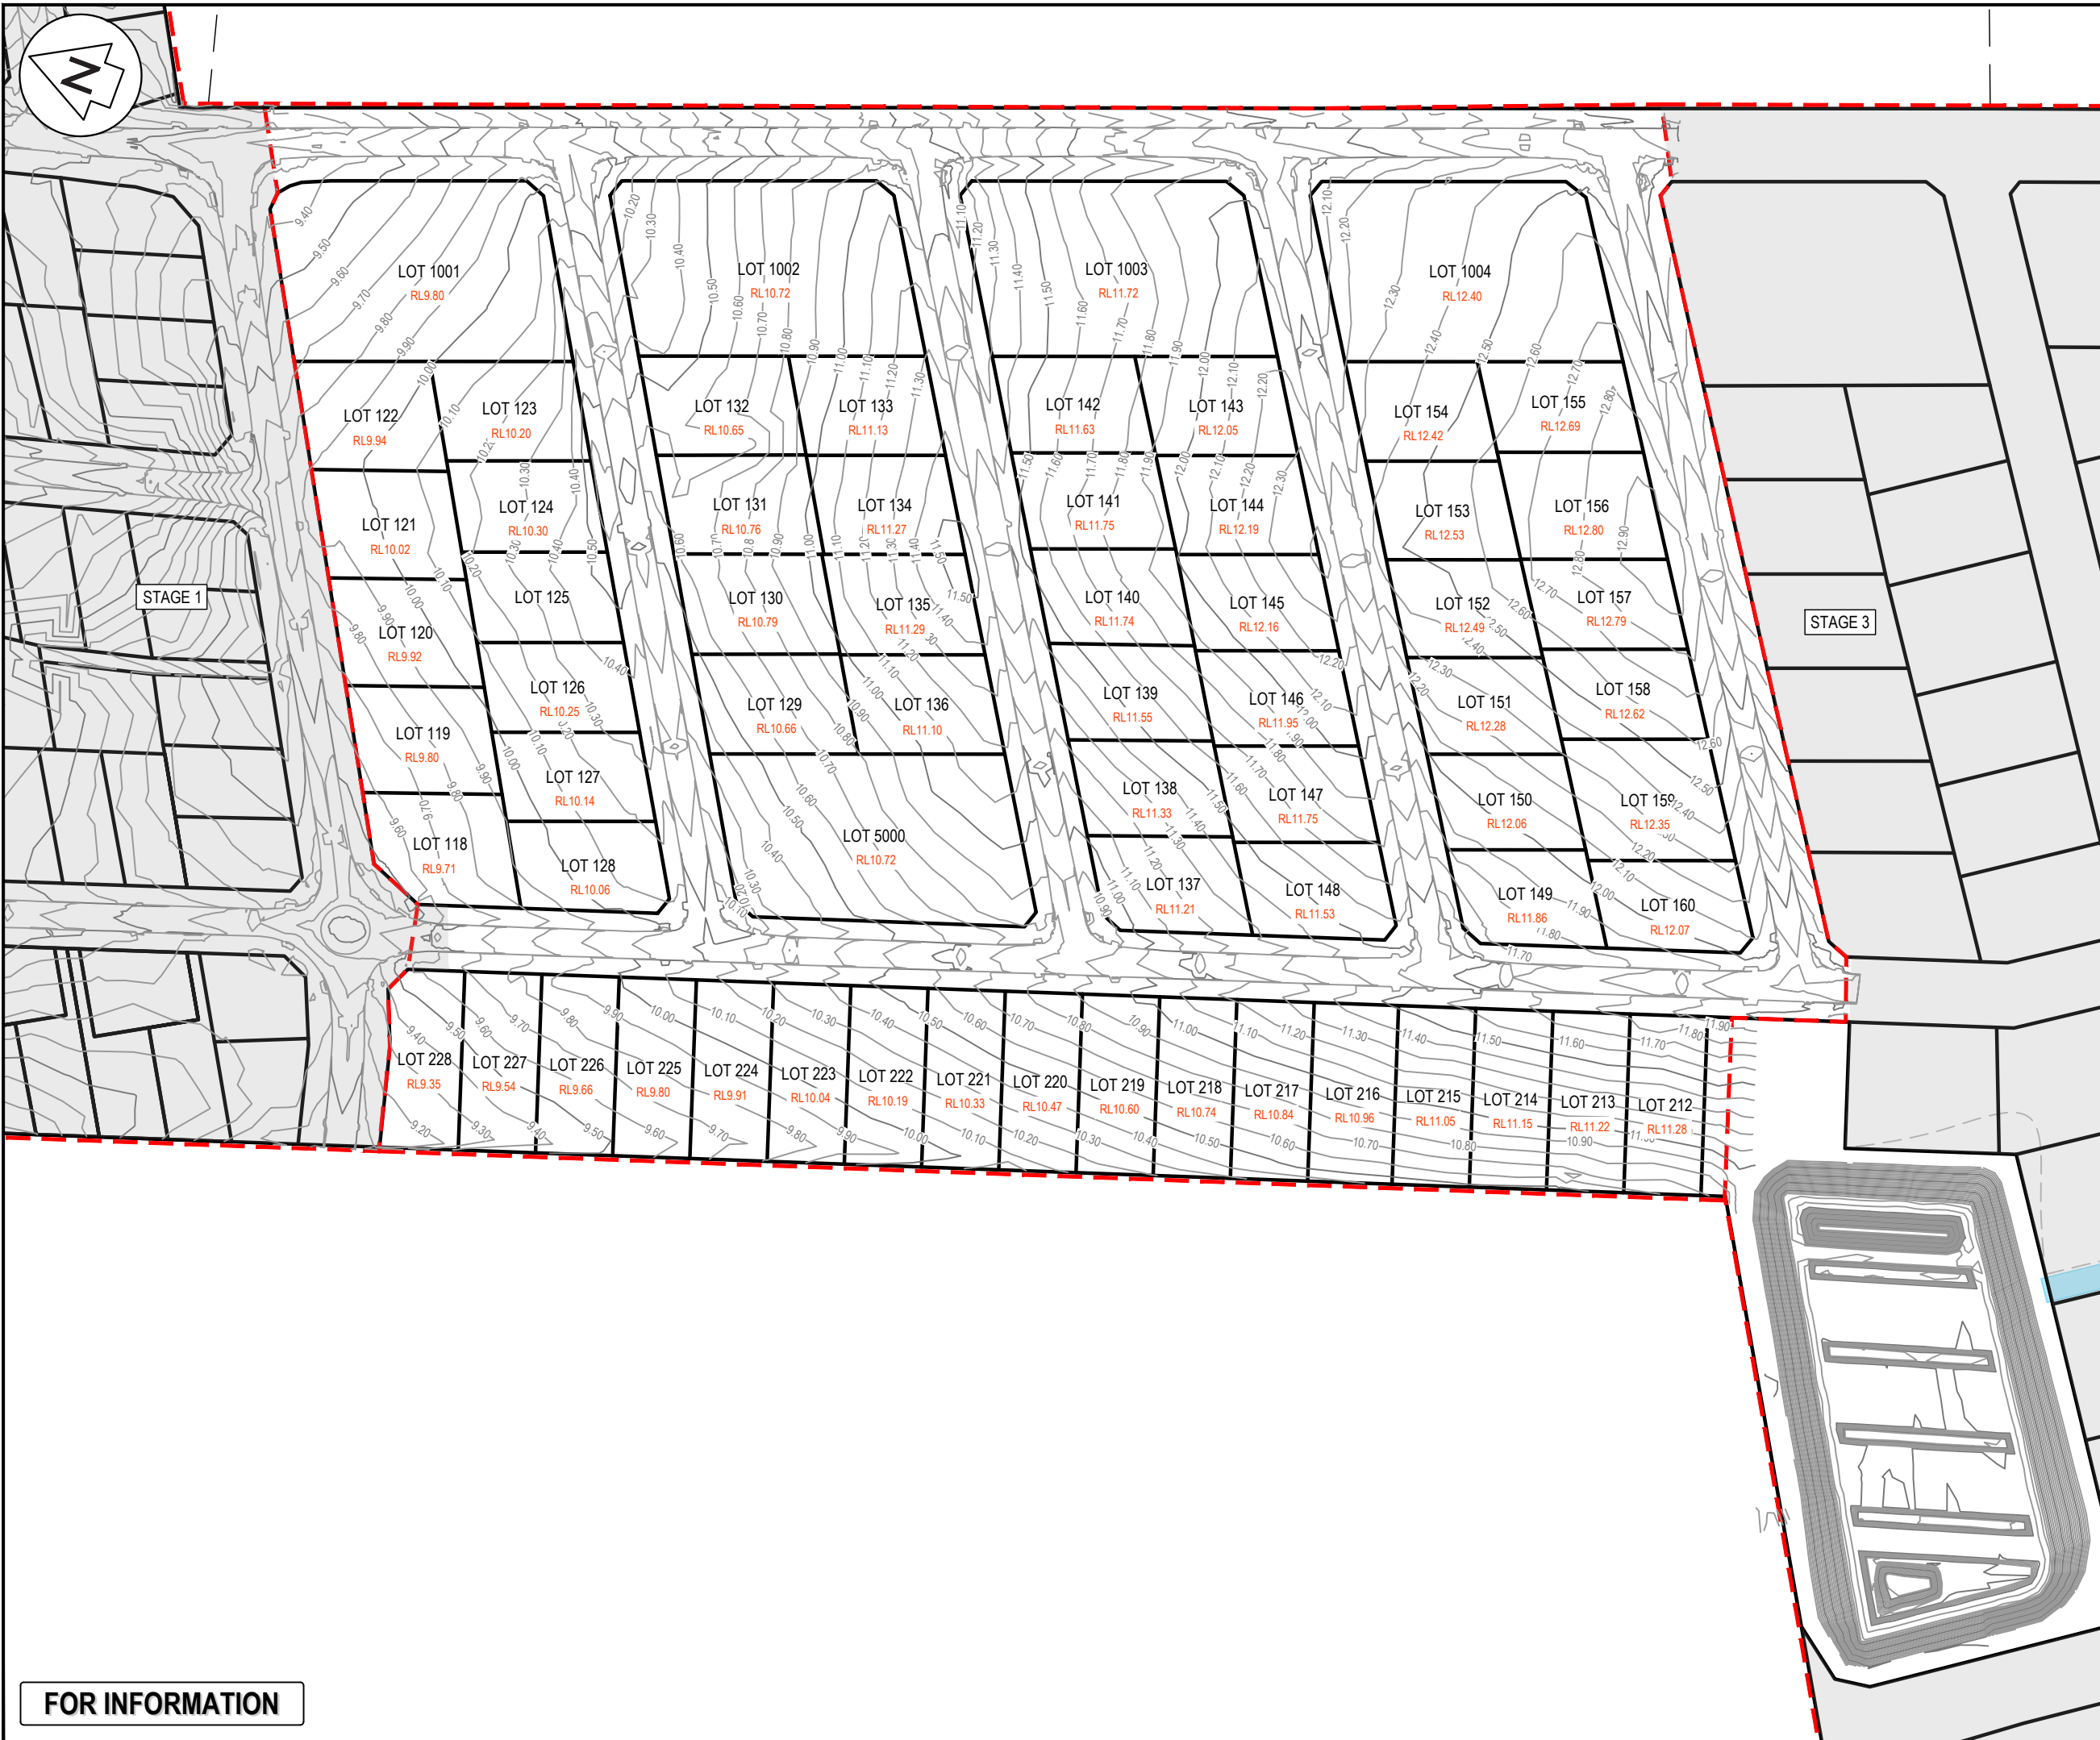

- Notes
1. Co-Ordinates are in terms of Mt Eden 2000.
 2. Levels in terms of the Auckland Vertical Datum **NZVD 2016**.
 3. Works carried out by Dempsey Wood Civils
 4. Constructed in accordance with Auckland Council standards.
 5. Levels shown are for information only and are to be confirmed by survey for detailed design.
 6. Origin of Levels
RM 5846 SO 58211 (BB2R)
RL 10.31m

Legend

---	EX BDY
---	AB BDY
---	STAGING BDY
---	AB MAJOR CONTOUR
---	AB MINOR CONTOUR

D	FOR INFORMATION	ML	10/2025
C	FOR INFORMATION	ML	04/2025
B	FOR INFORMATION	ML	03/2025
A	FOR INFORMATION	ML	10/2024
Rev	Description	By	Date
		By	Date
Survey	DEMPSEY WOOD		09/2024
Design	ML		09/2024
Drawn	ML		09/2024
Checked	JD		09/2024



Maven Associates
09 571 0050
info@maven.co.nz
www.maven.co.nz
5 Owens Road, Epsom
Auckland 1023

Project
**62, 78 & 80 PAPAURA -
CLEVEDON ROAD,
CLEVEDON, AUCKLAND
FOR CLEVEDON
PROPERTIES LTD**

Title
**CLEVEDON MEADOWS
FINISHED GROUND LEVEL
ASBUILT (NZVD 2016)**

Project no.	194006
Scale	1:1500 @ A3
Cad file	CLEVEDON MEADOWS STG2 - AB FGL (1946 & 2016).DWG
Drawing no.	STG_2 C911
Rev	D

DATE: 10/25 FILE PATH: F:\Maven\Projects\194006_Clevedon Meadows\ASBUILT\STG2 - AB FGL (1946 & 2016).DWG